


47,500W

47,000W

TOP SPLIT
Nº 1 VEIN

46,500W

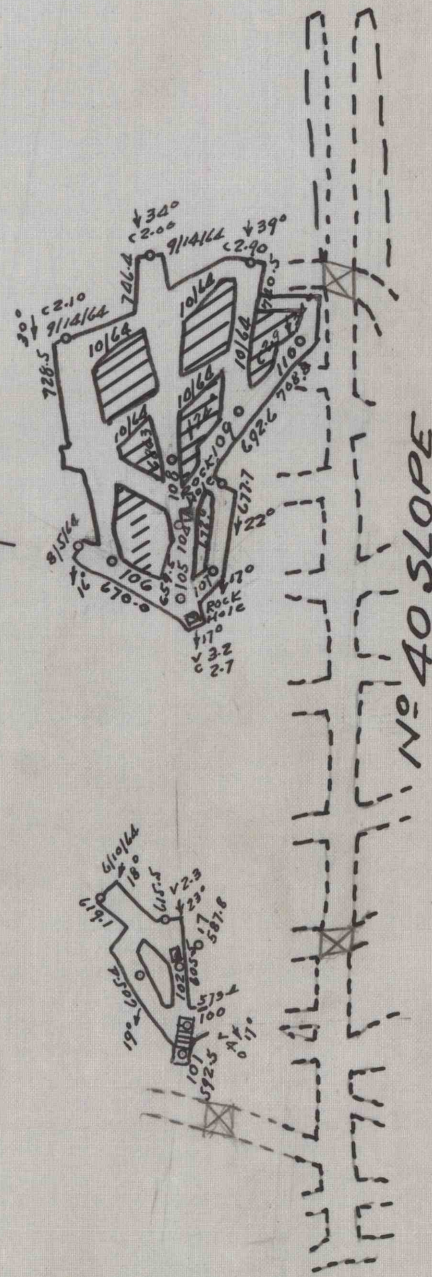

12,500S

12,000S

13,000S