


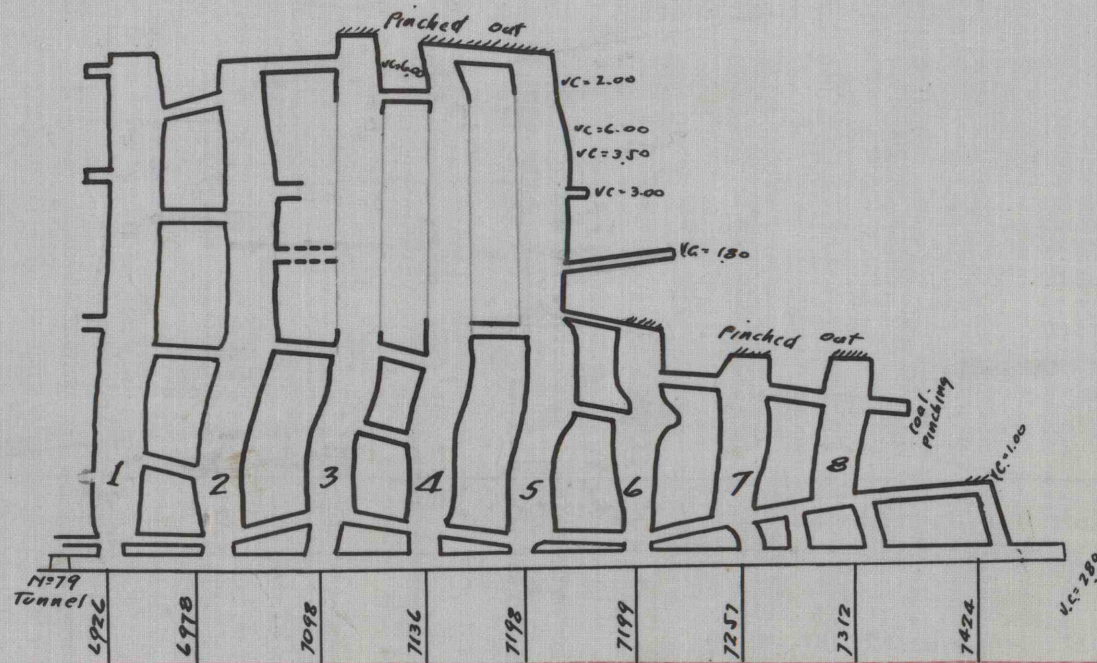

+300.00

