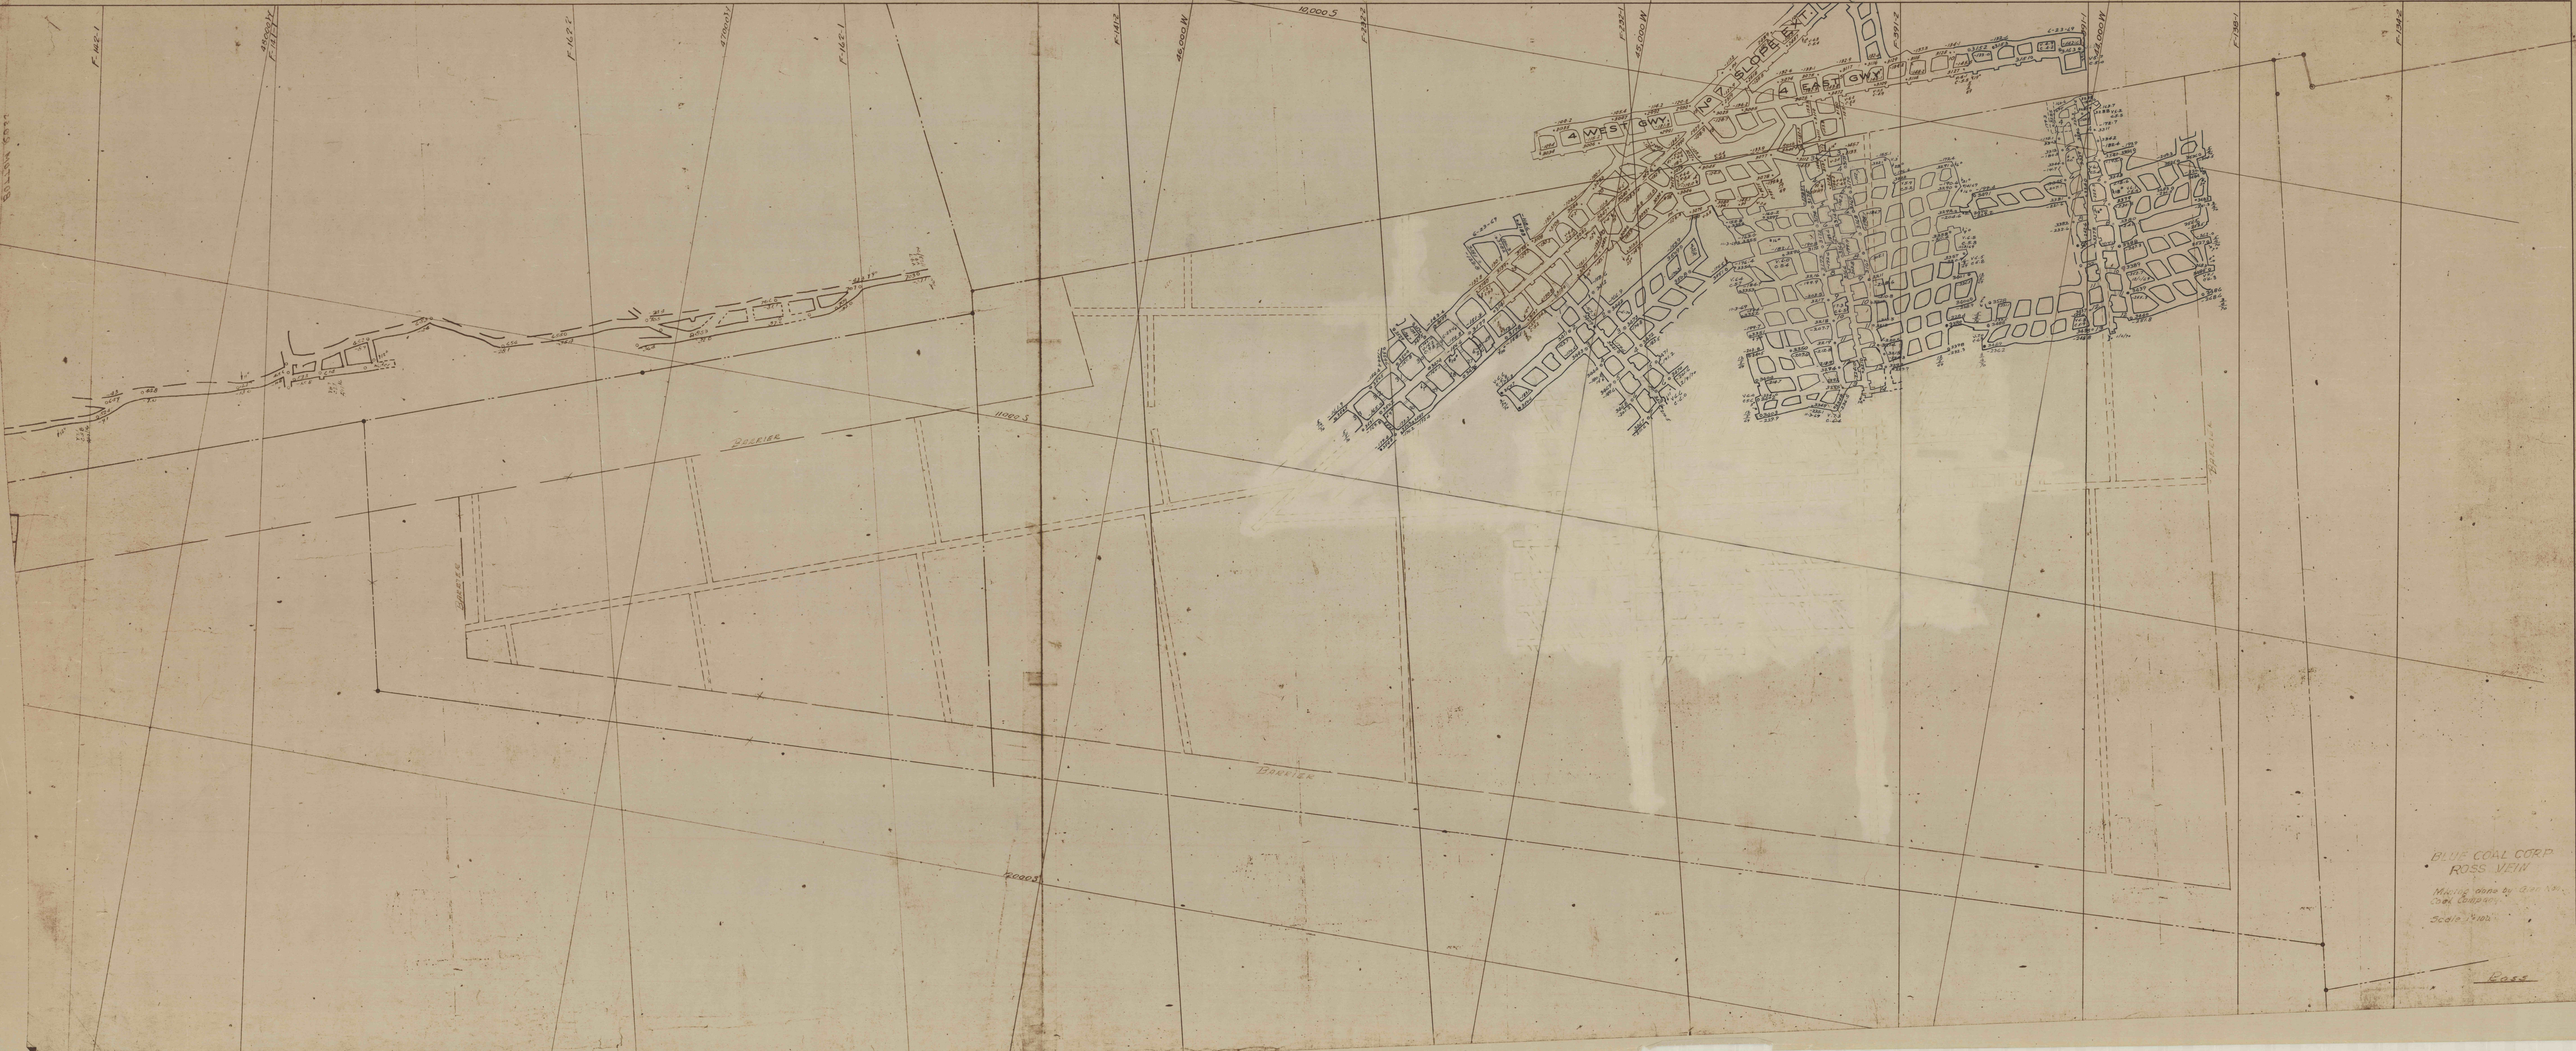
4 WEST GWY
4 EAST GWY
NO 7 SLOPE EXT
BREAKER
BREAKER
BREAKER
BLUE COAL CORP
ROSS VEIN
Mining done by Glen Alden
Coal Company
Scale 1/40th
Ross