


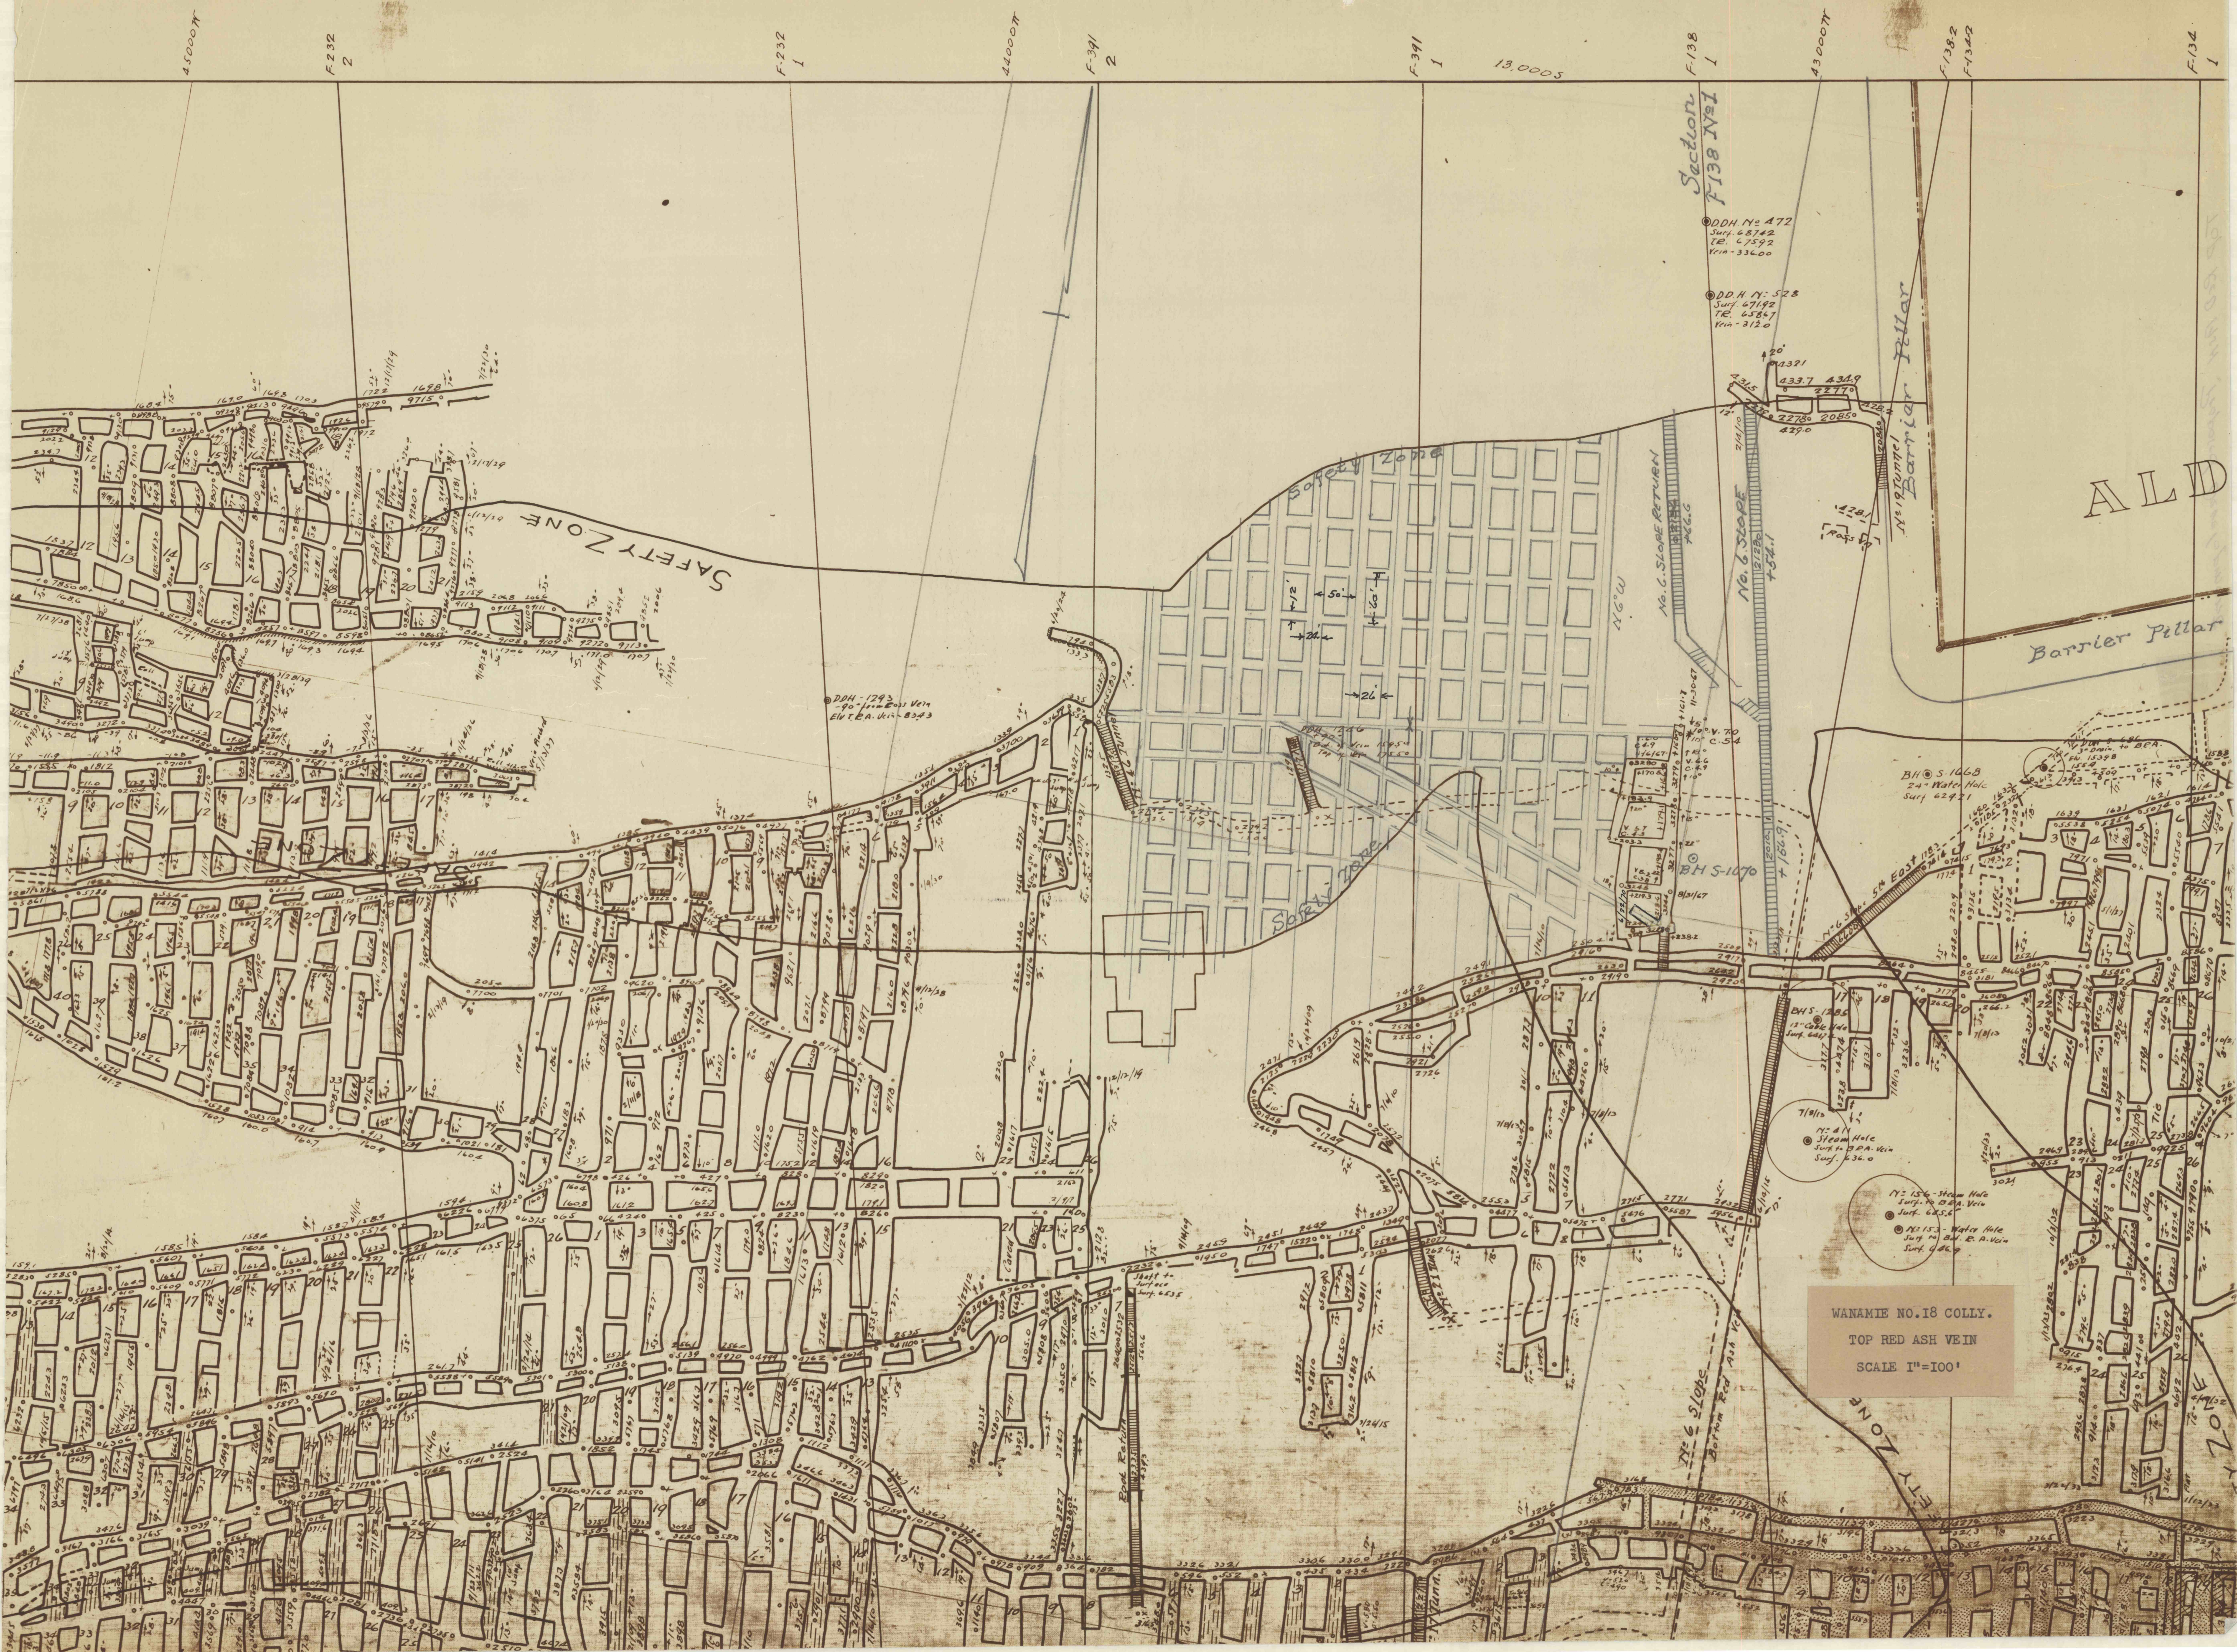

WANAMIE NO. 18 COLLY.
TOP RED ASH VEIN
SCALE 1"=100'