


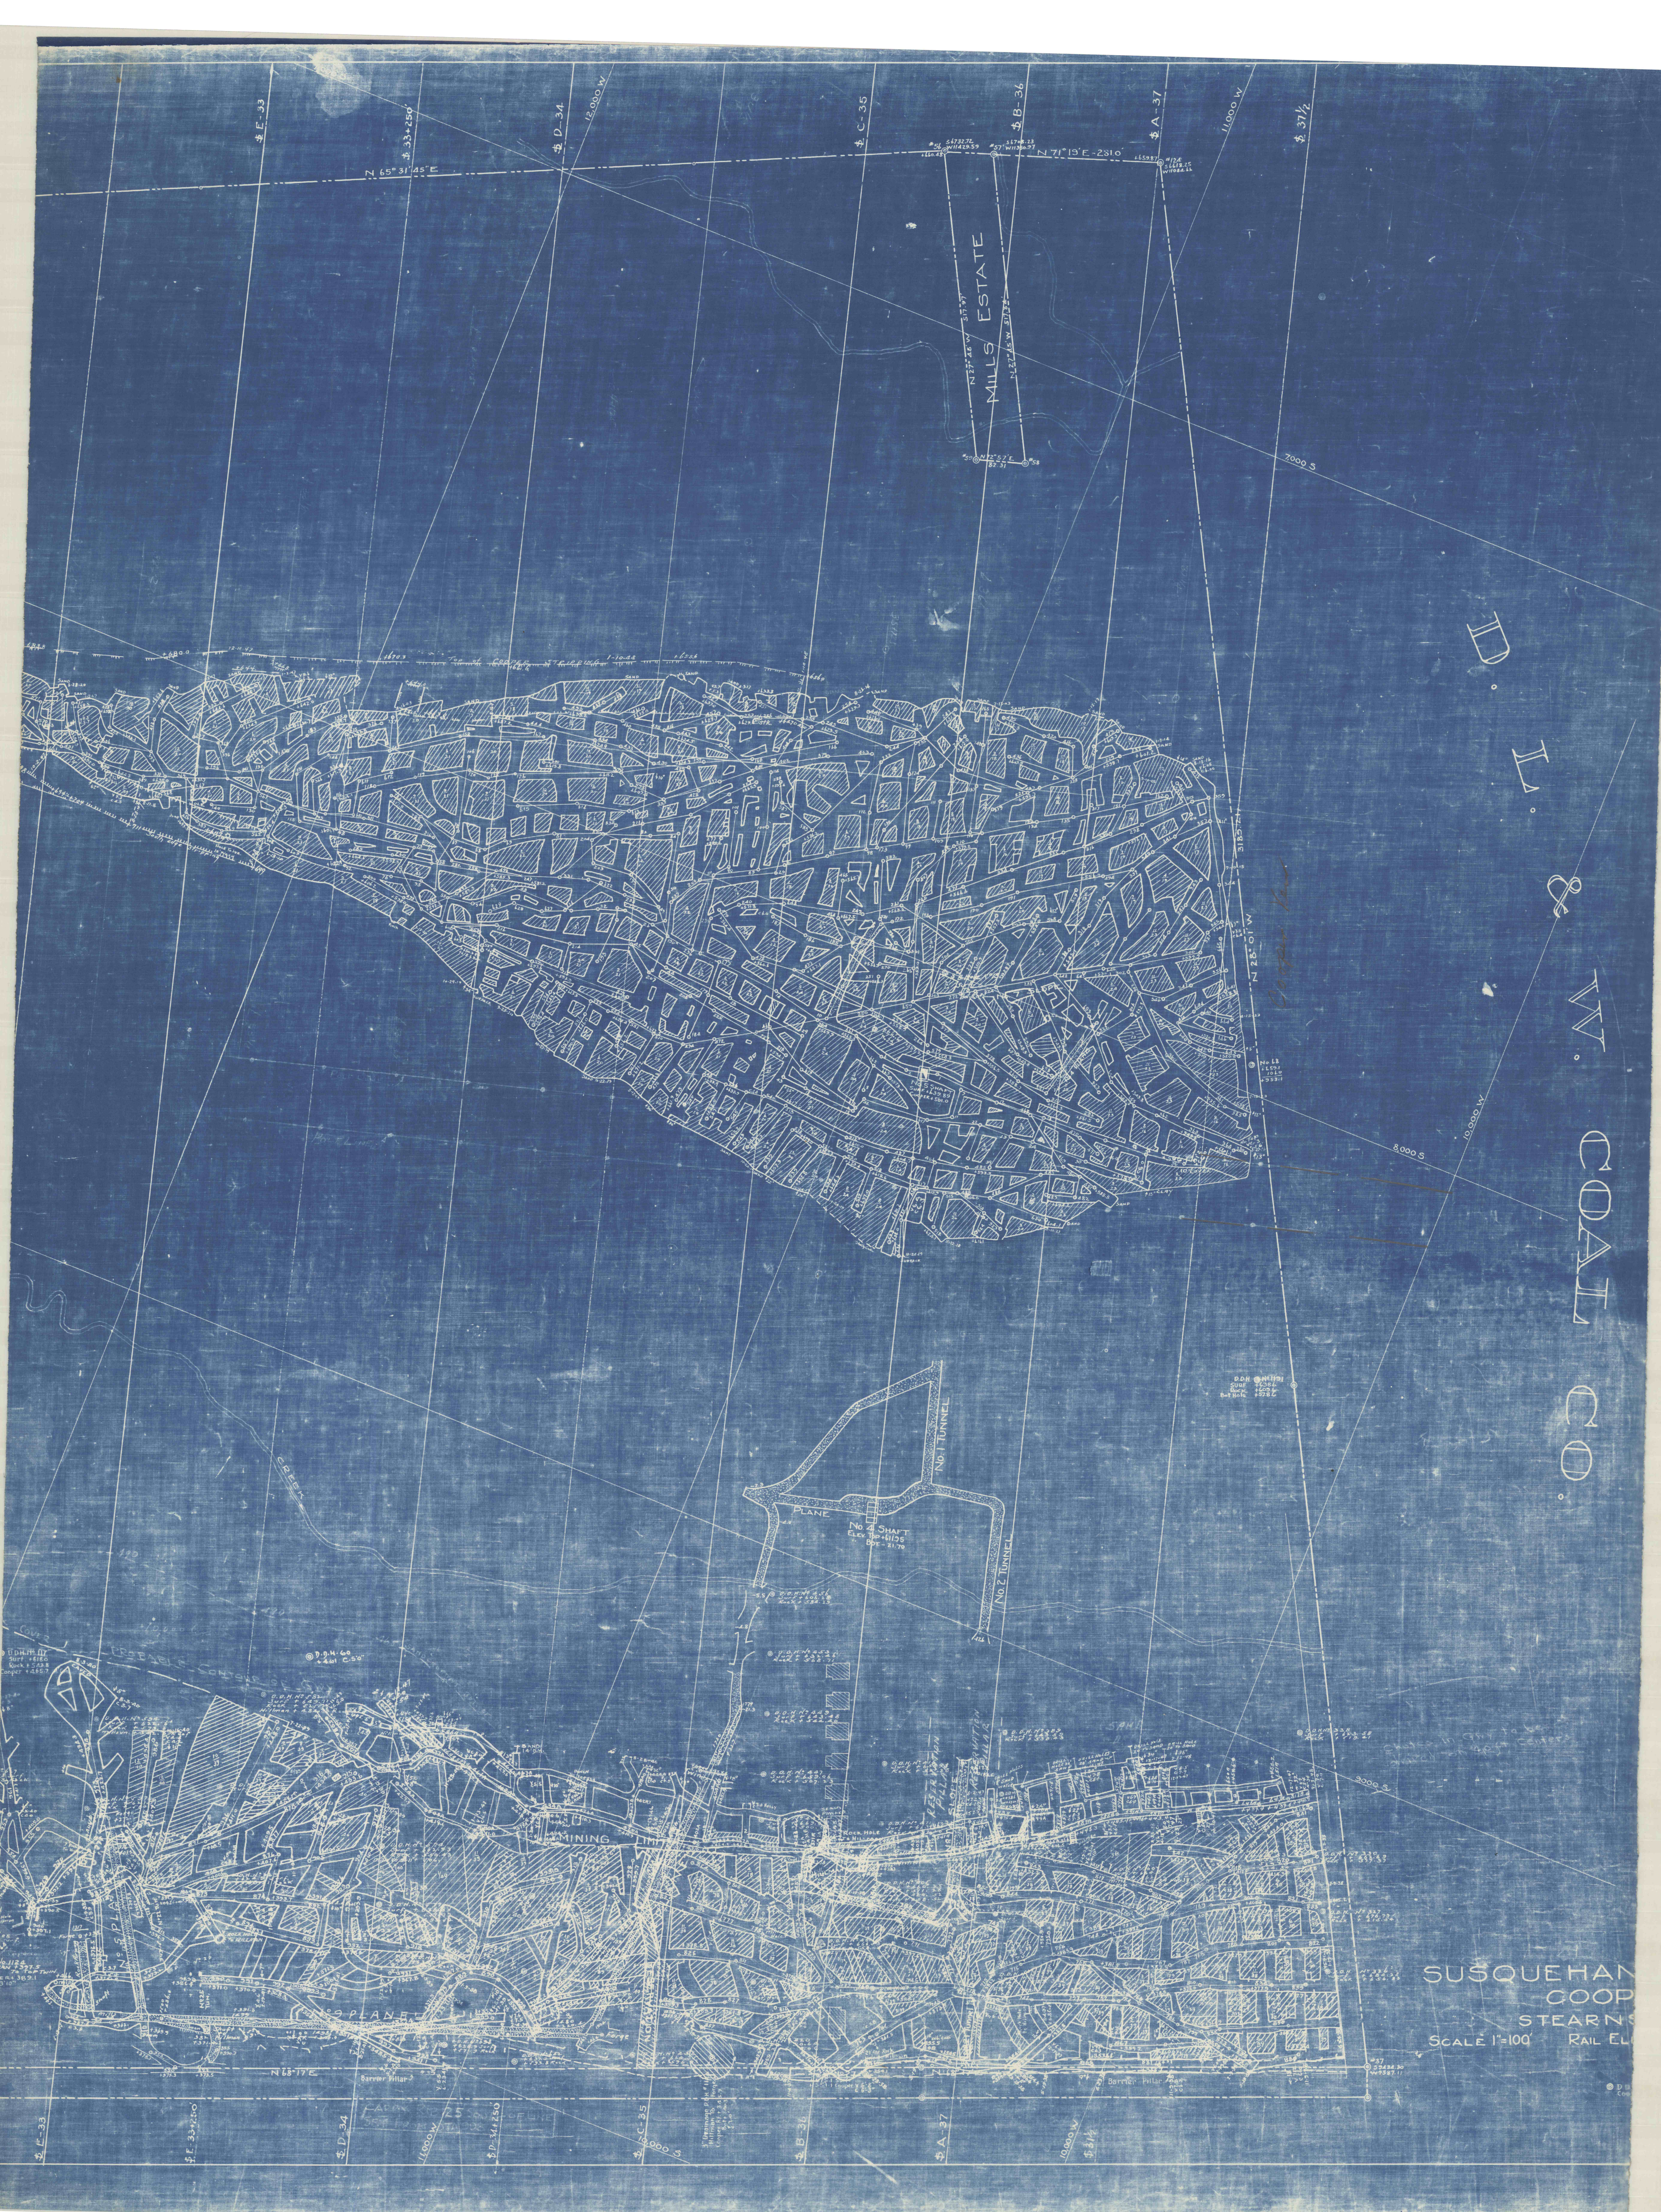

SUSQUEHANNA
STEARNS MINE

SCALE 1"=100' RAIL EL