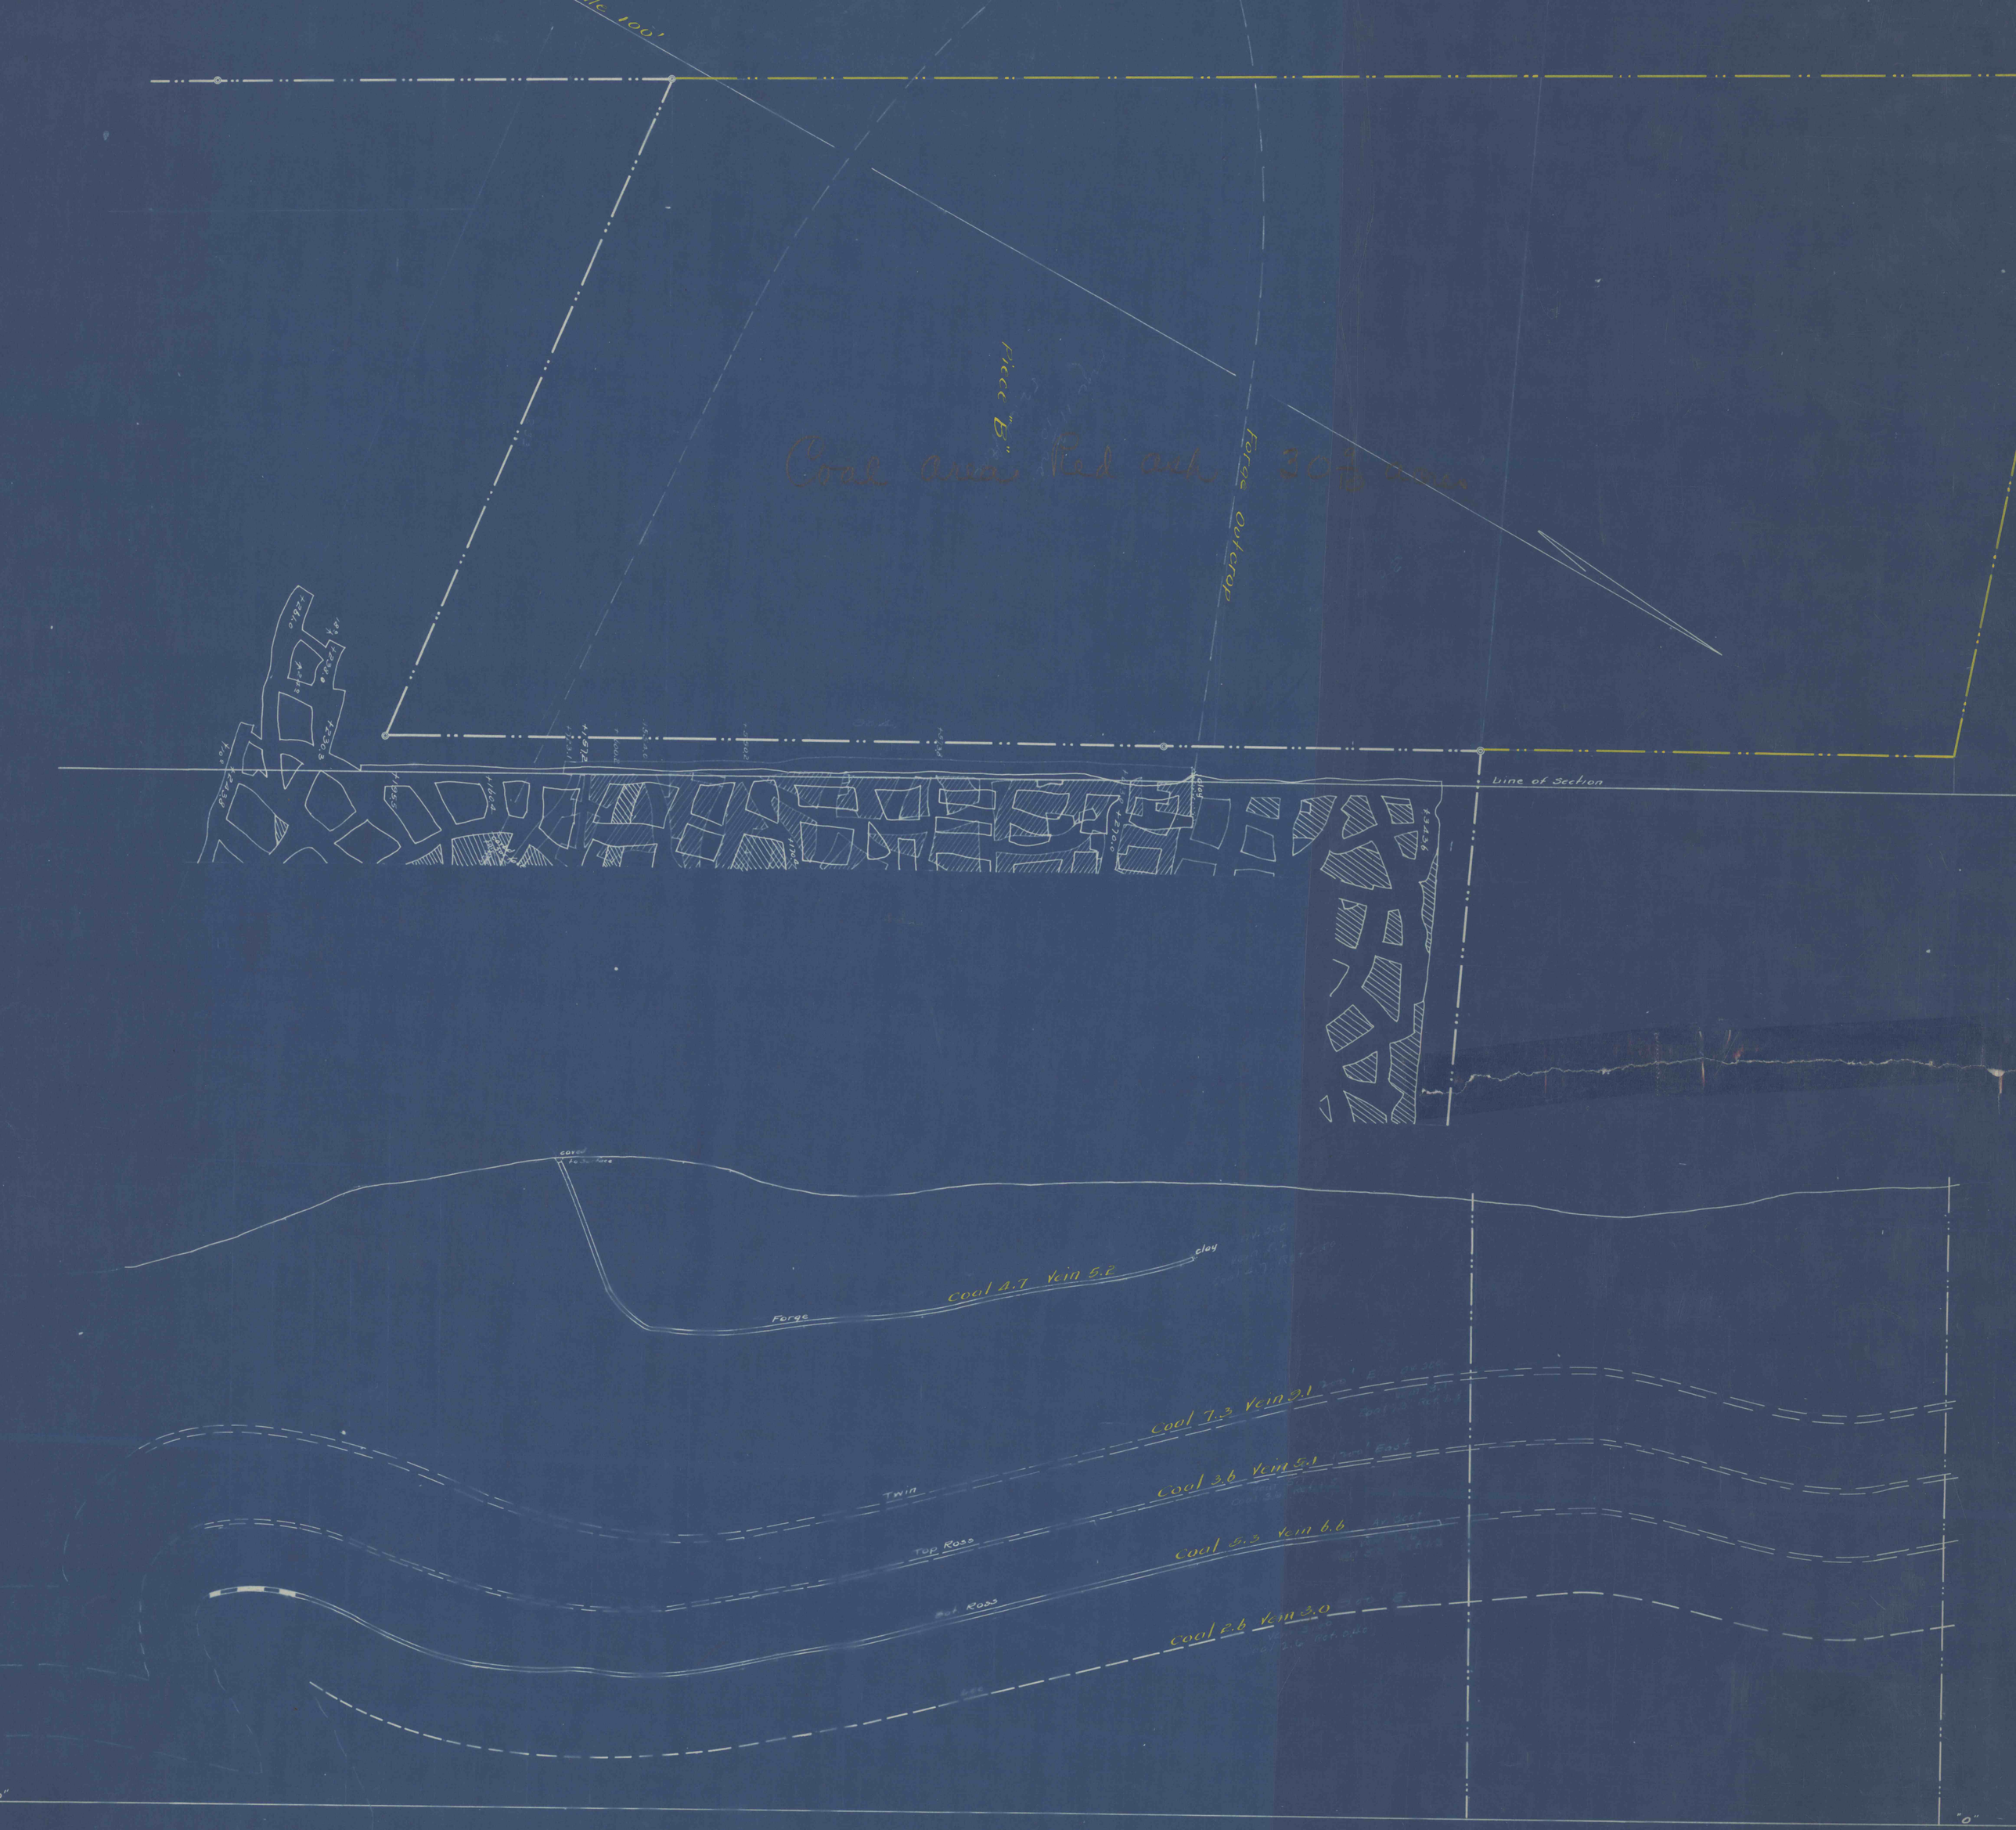
Line of Section
Face "B"
Face outcrop
Coal 4.7 Vein 5.2
Forge
clay
Coal 7.3 Vein 9.1
Coal 3.6 Vein 5.1
Coal 5.3 Vein 6.6
Coal 2.6 Vein 3.0
Twin
Top Ross
Bot Ross
"0"