


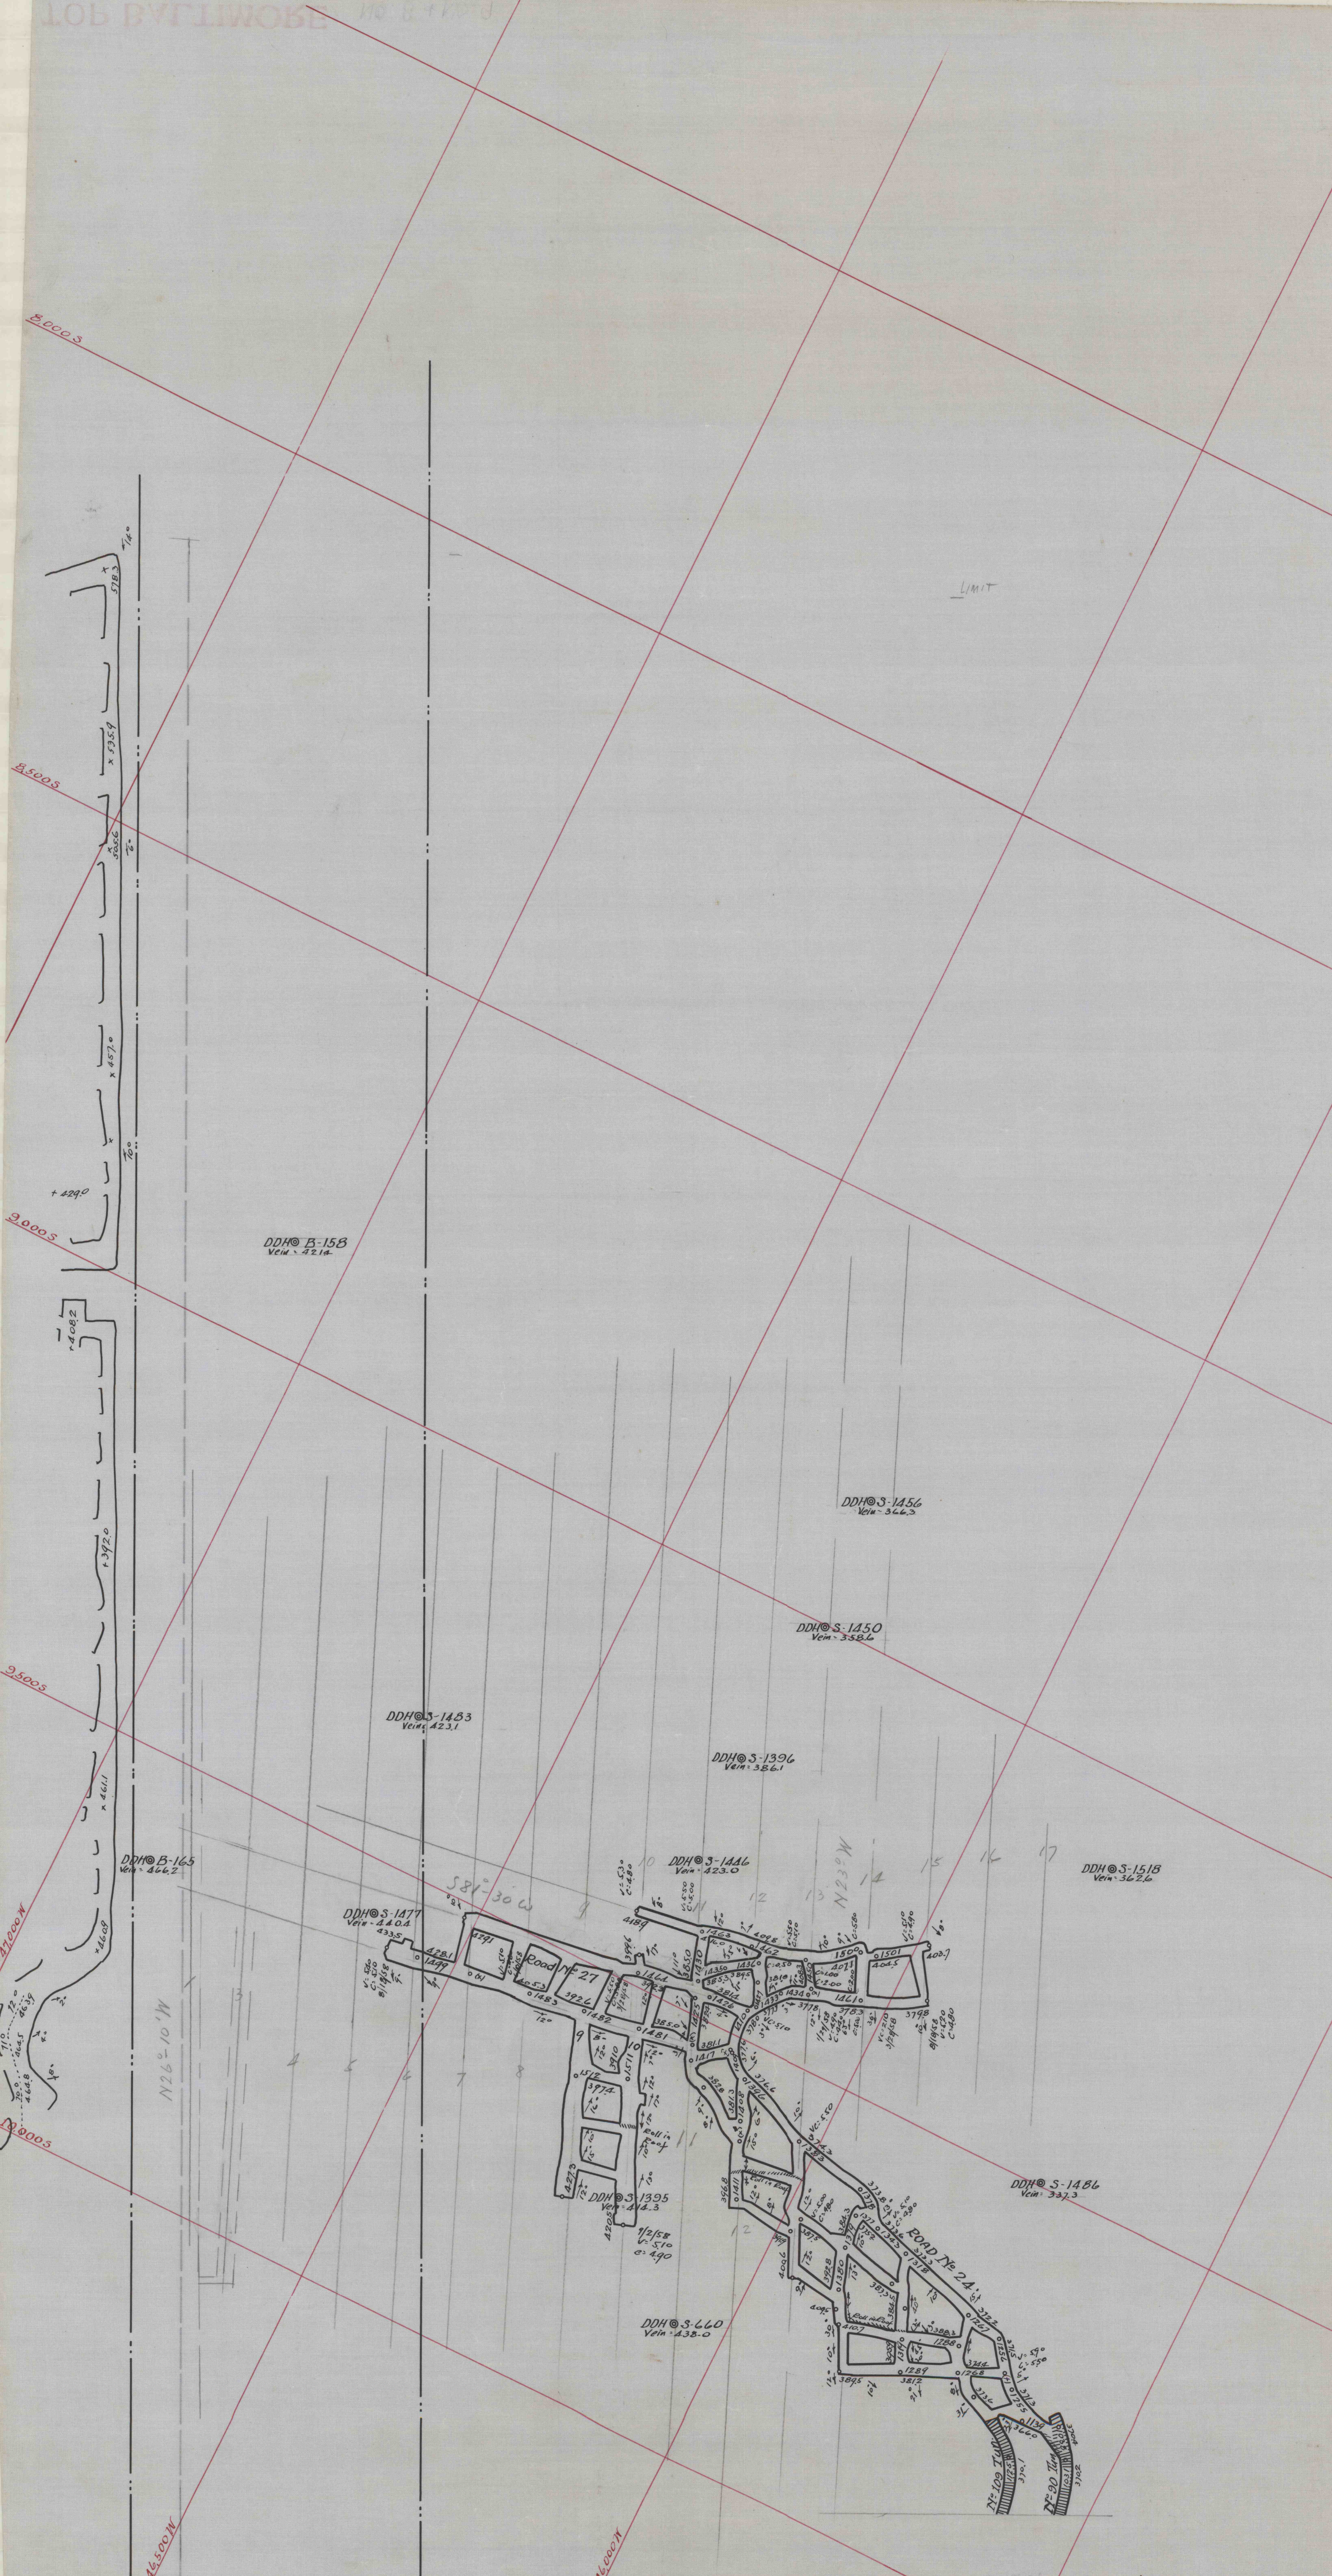

8000.3

8500.3

9000.3

9500.3

10000.3

16,000.0

16,500.0

17,000.0

DDH B-158
Vern. 421.4

DDH S-1456
Vern. 366.3

DDH S-1450
Vern. 358.6

DDH S-1453
Vern. 423.1

DDH S-1396
Vern. 386.1

DDH S-1446
Vern. 423.0

DDH S-1518
Vern. 362.6

DDH S-1486
Vern. 337.3

DDH S-1477
Vern. 440.4

DDH S-660
Vern. 438.0

DDH S-1395
Vern. 412.3

58°-30' W

N 23° W

Road No. 27

Road No. 24

N 100° W

S 90° W