

2B-2

B-2

2,000 S.


2,000 N.

DATUM TIDE

DATUM TIDE

GLEN RIDEN COAL CO. WINDMILL COLLY.

SUSQUEHANNA COLLIERIES CO. NO. 7 COLLIERY

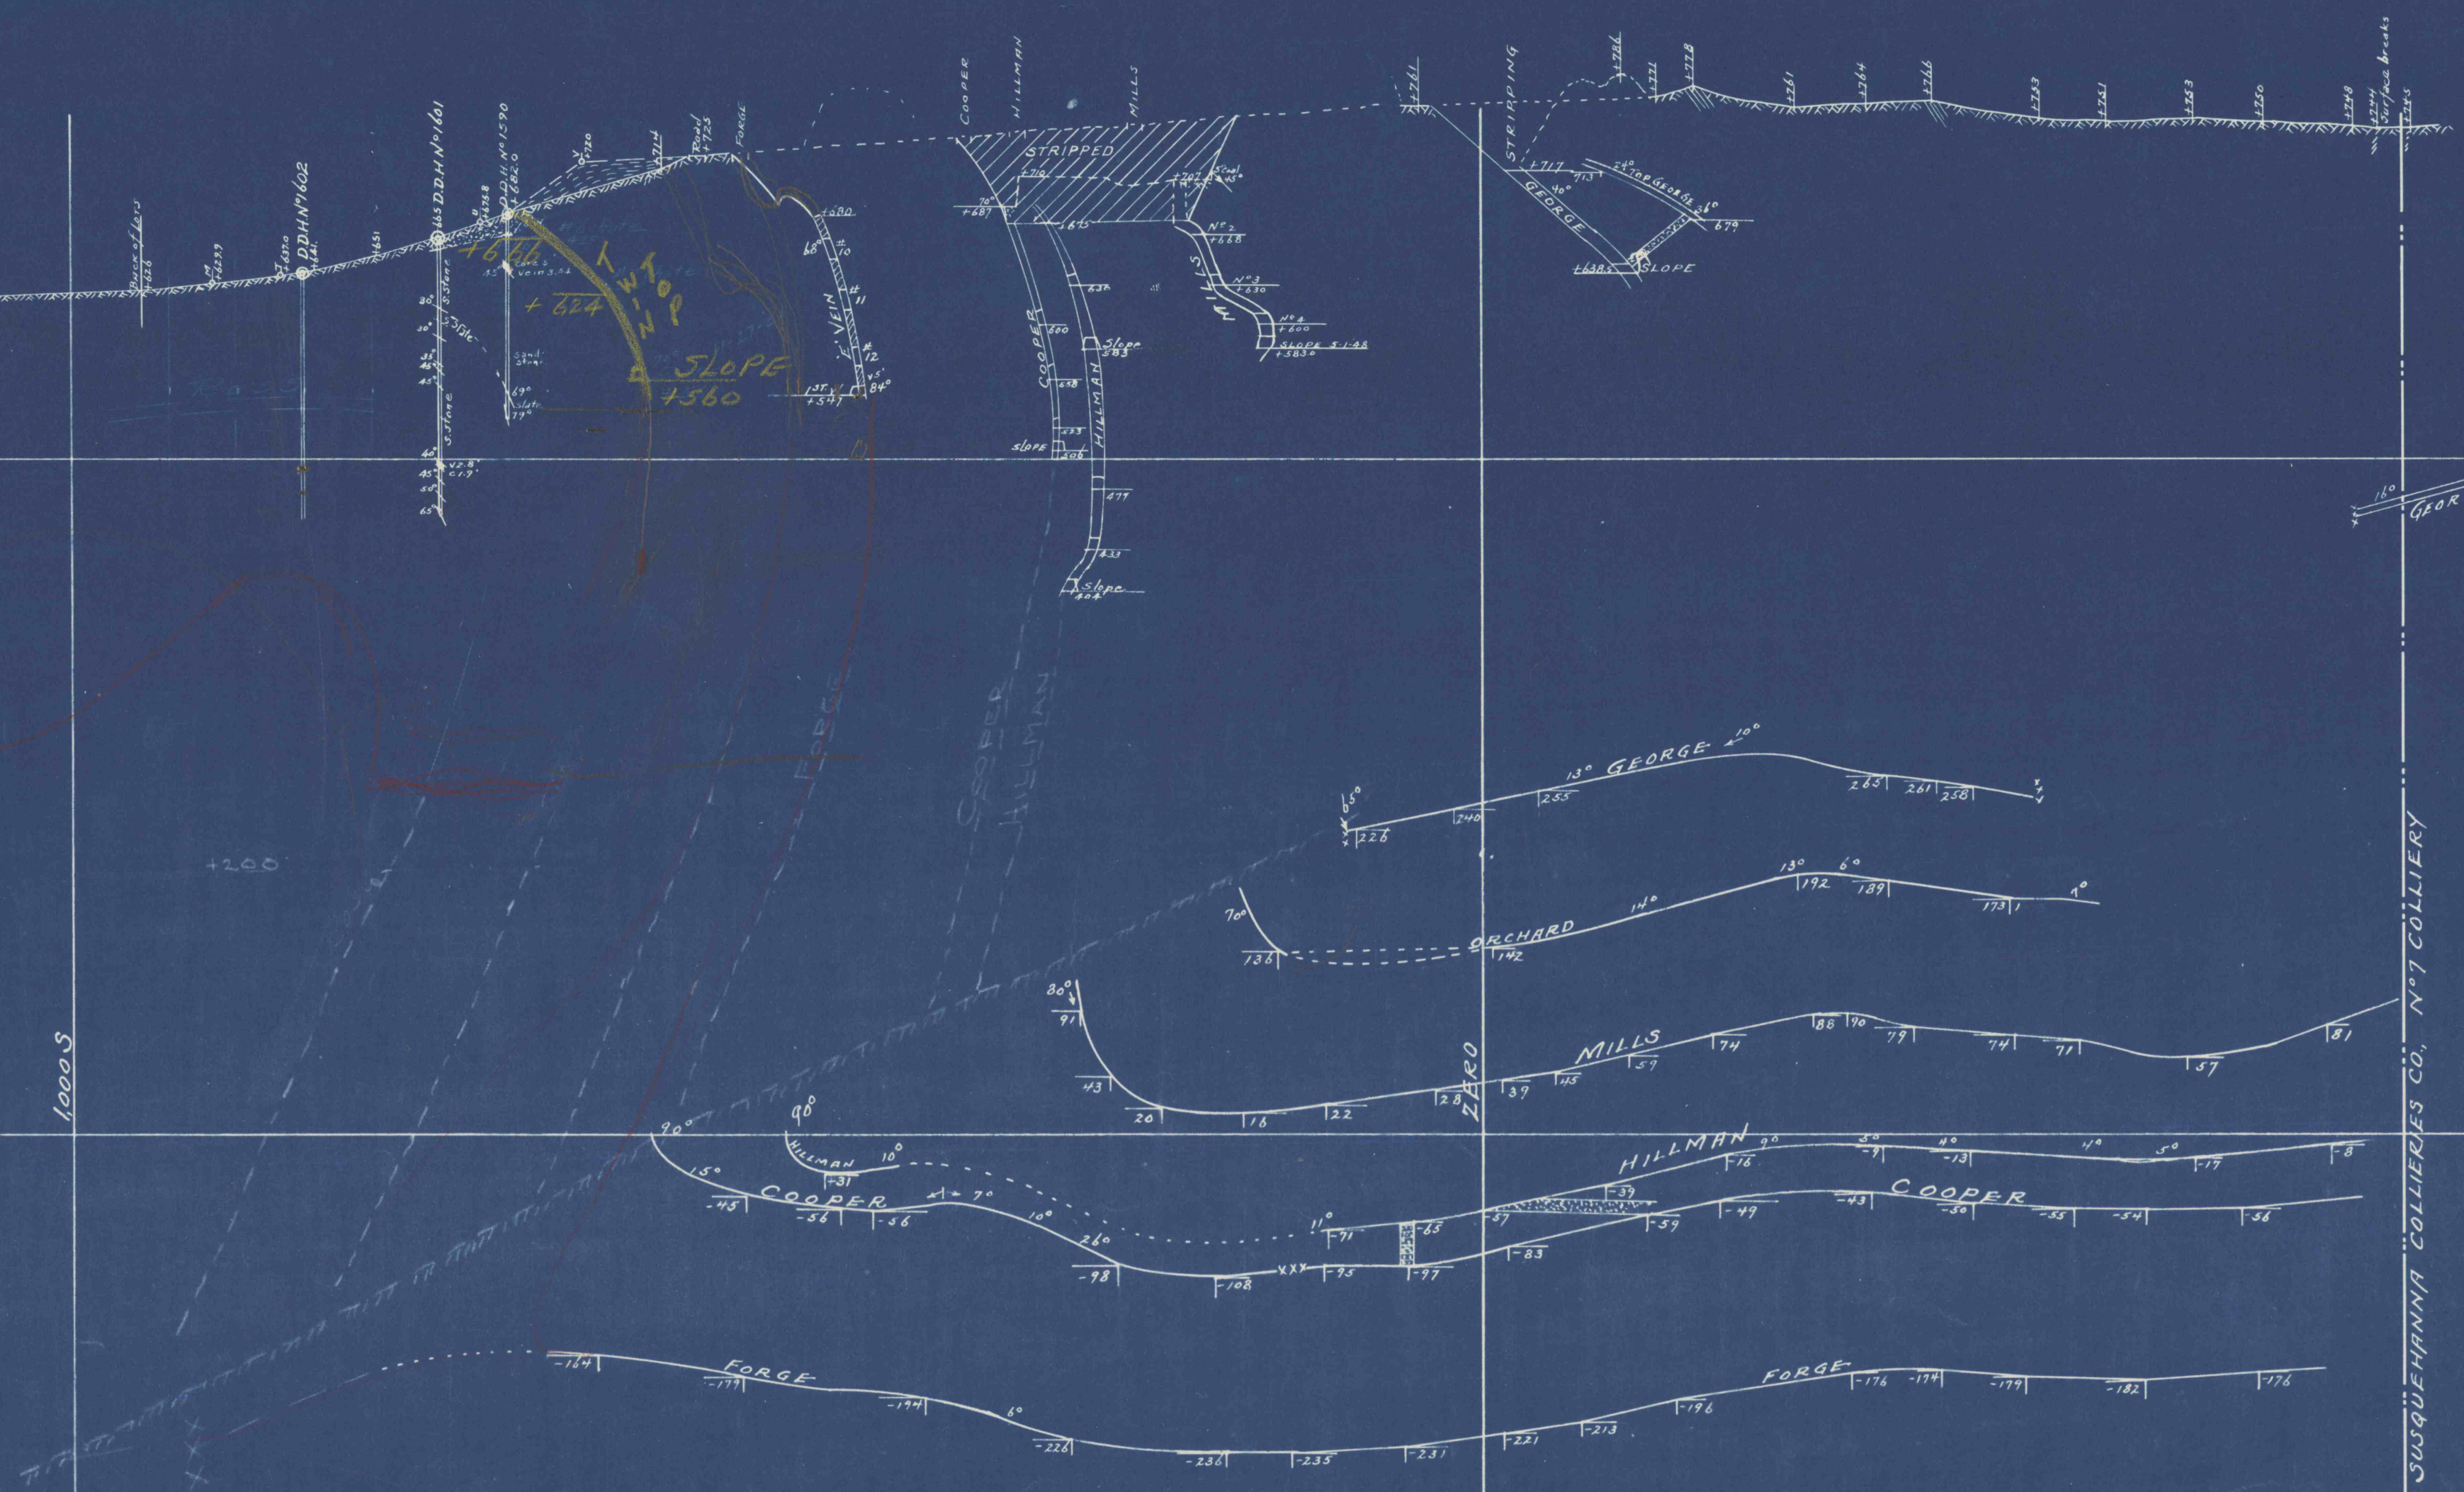

ADAM COAL CO. 2B-5