


N 70° 37' E

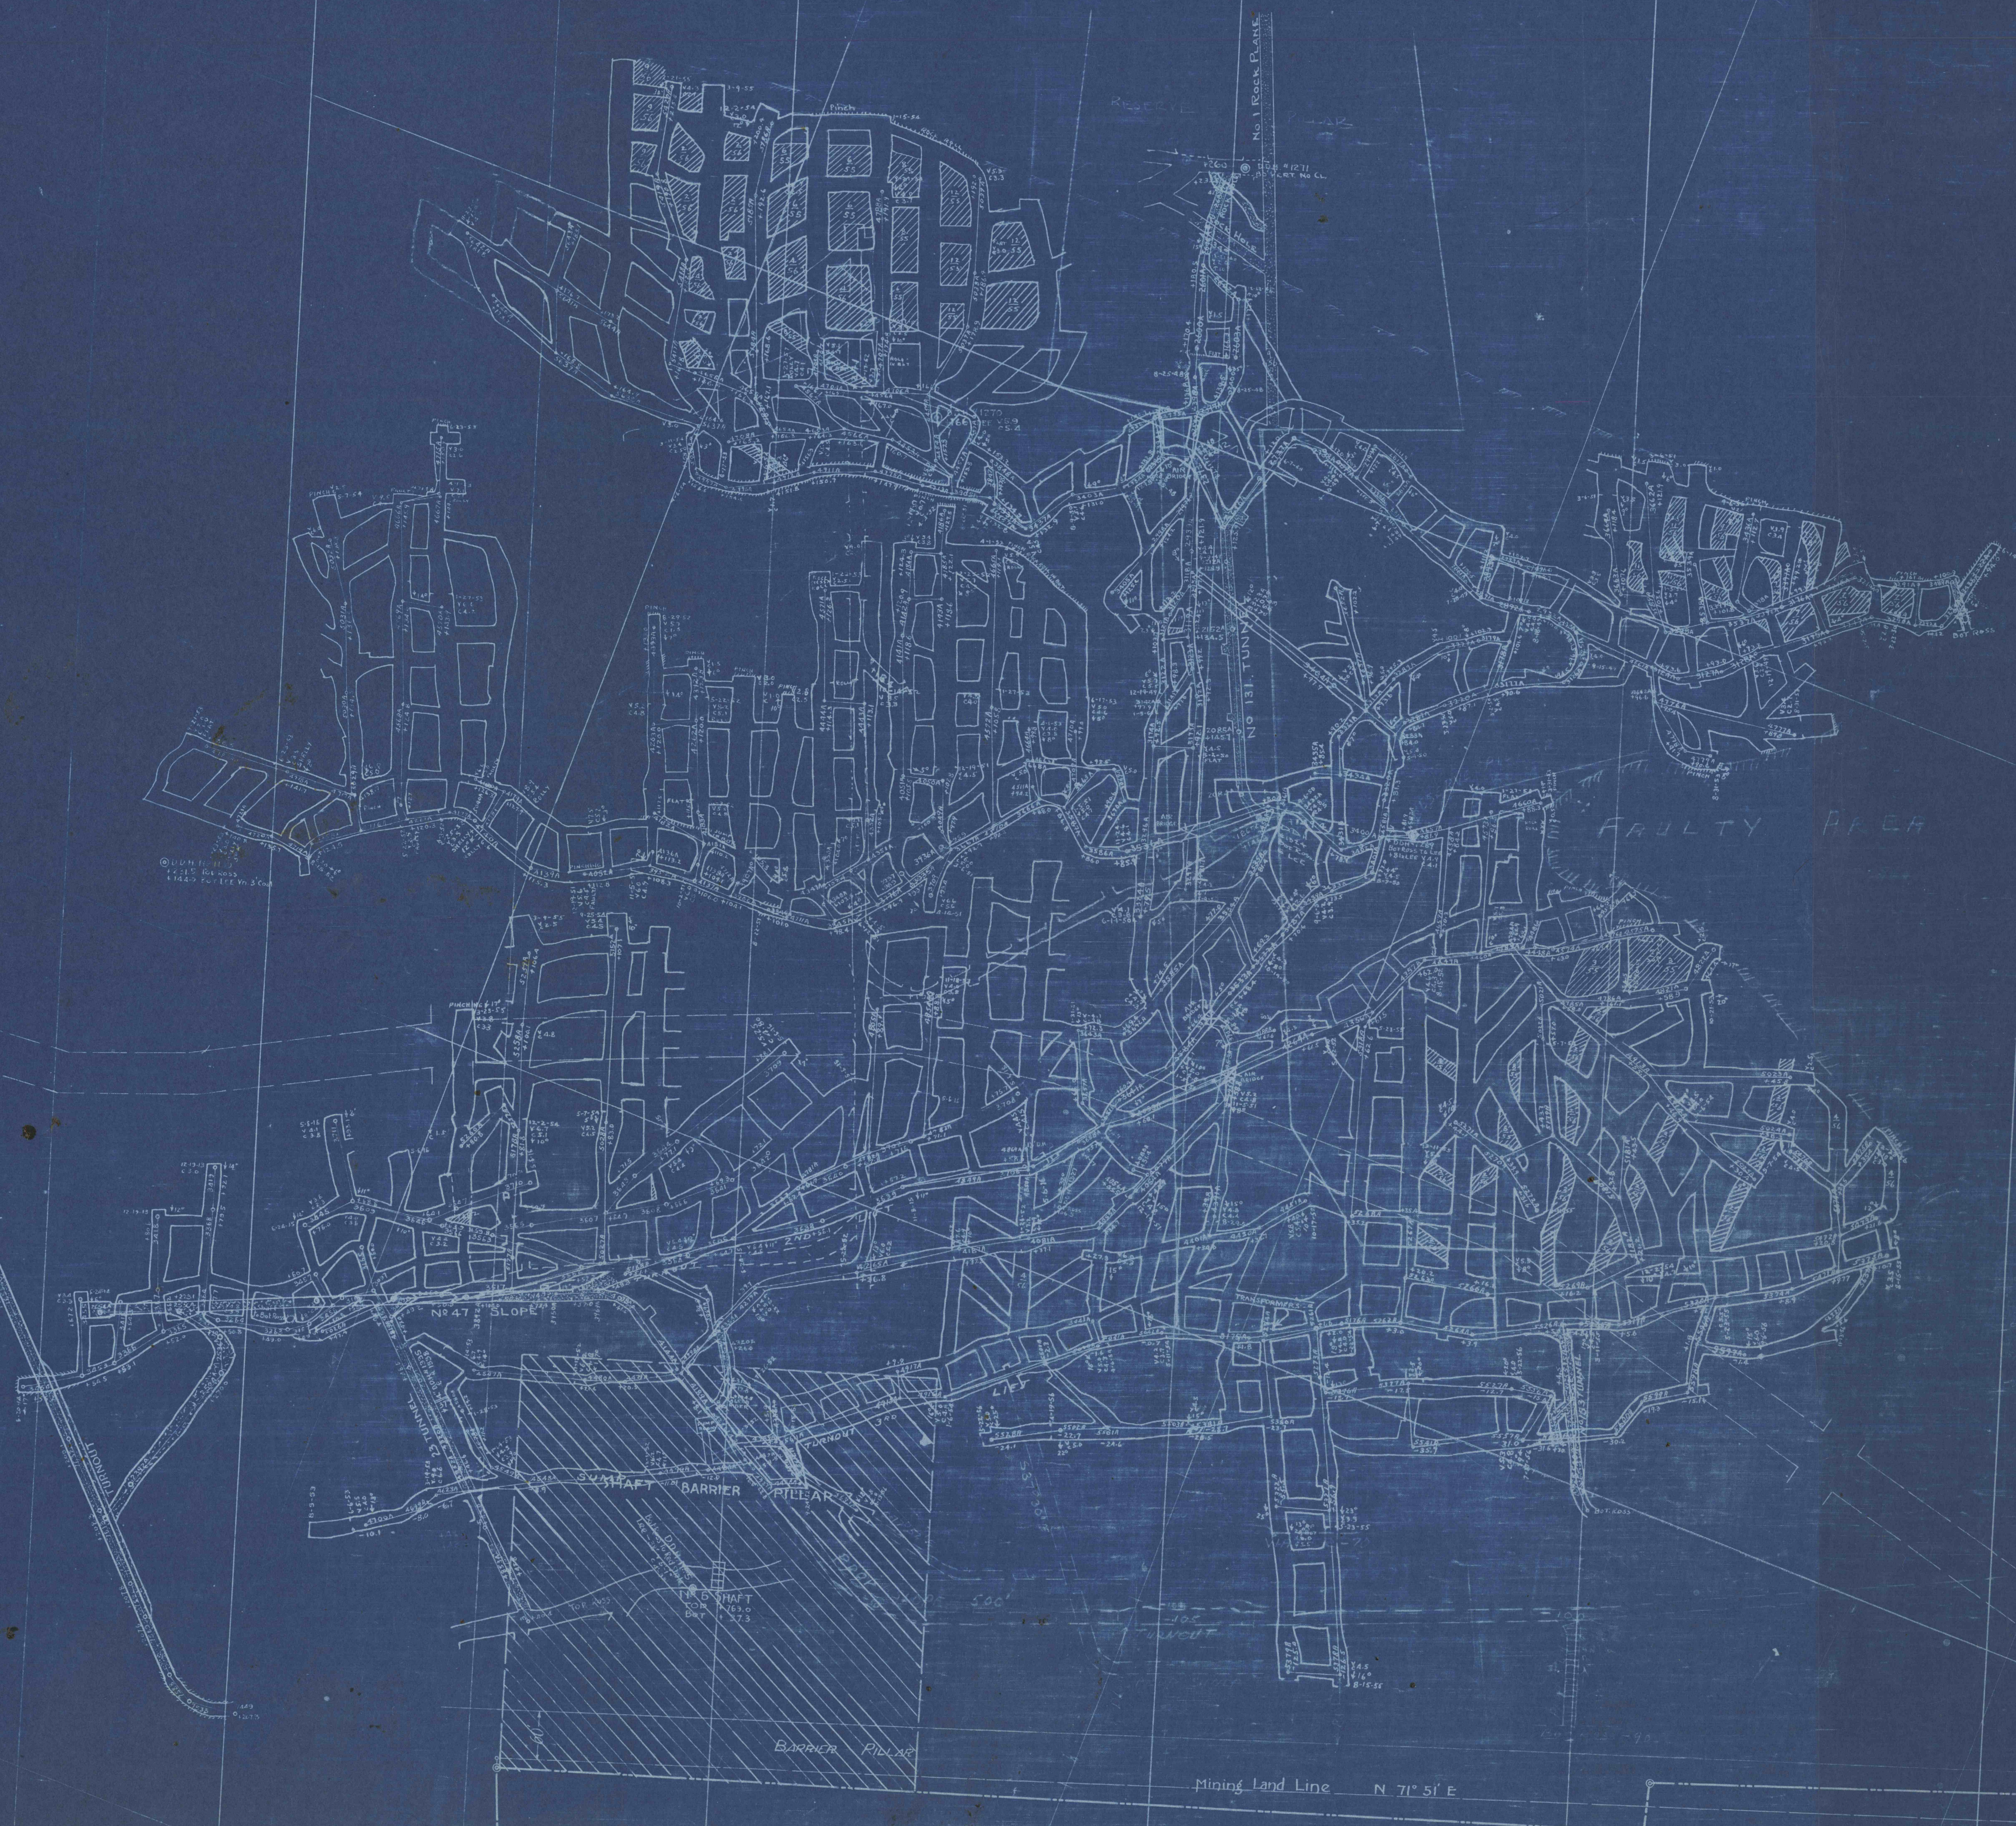

11,000 S

Barrier Pillar
N 22° 05' W

60

12,000 S

Mining Land Line N 71° 51' E

Barrier Pillar

60

SUSQUEHANNA COLLIERIES
No. 6 COLLIER

LEE SEAM - NORTHERN
Scale 1"=100'

Glen Lyon
R.W.
RAIL ELEVATIONS

Match
Line