


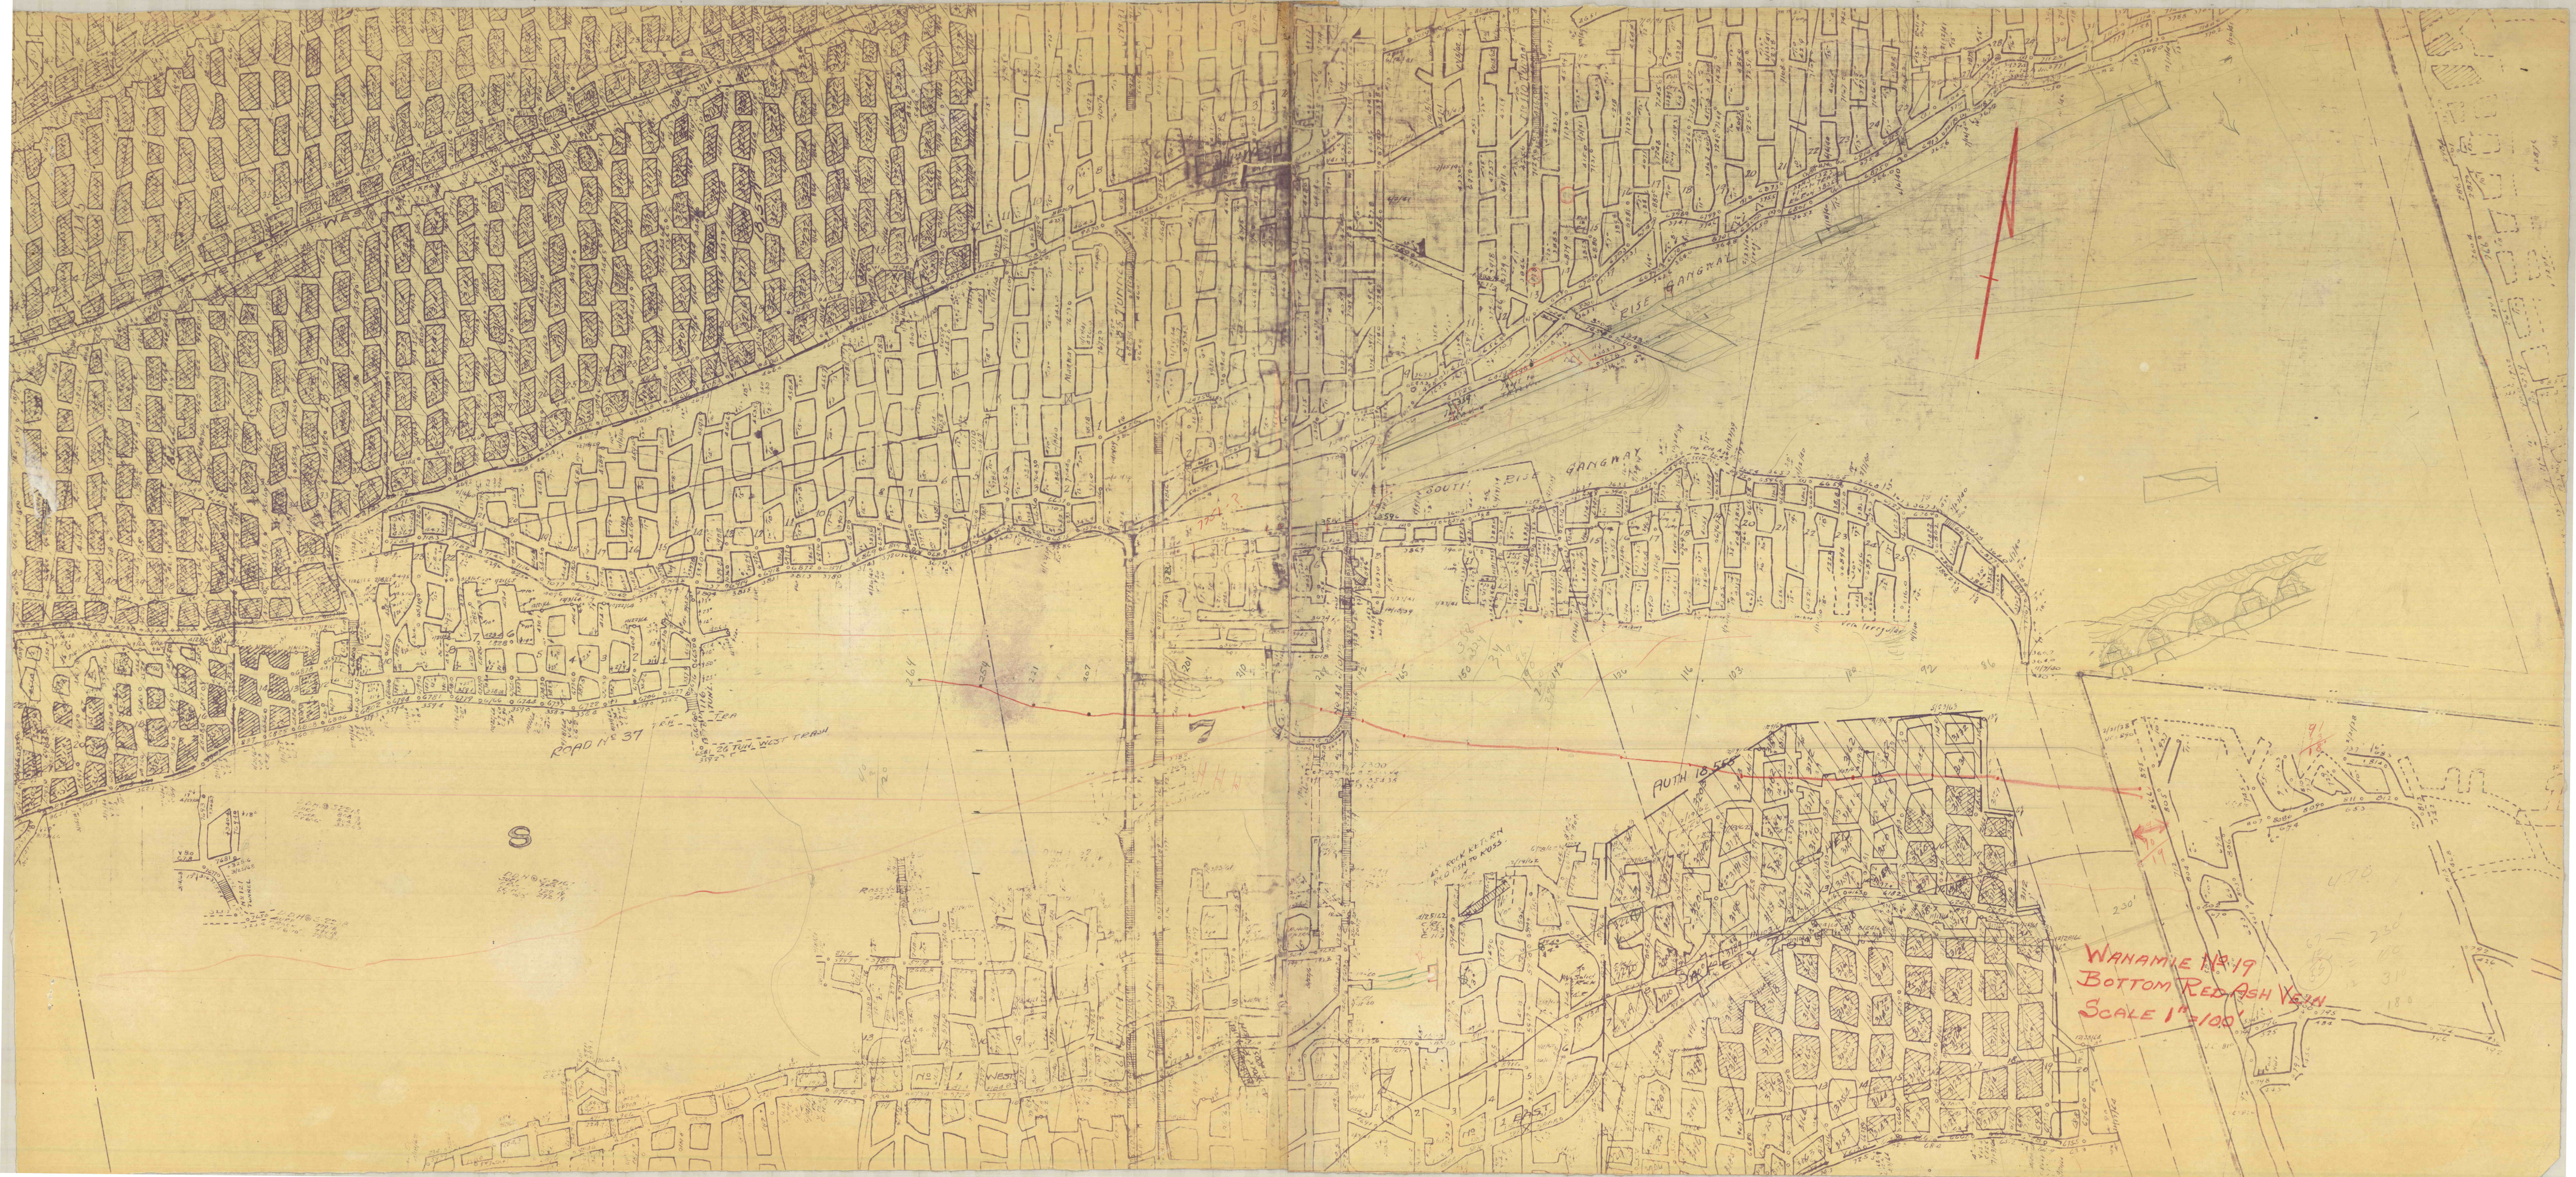

ROAD NO 37

26 TH. WEST TRAIL

AUTH 18 500

WANAMIE NO. 19
BOTTOM RED ASH VEIN
SCALE 1"=100'