
F-162-2 F-162-2 F-162-2 F-162-2 F-162-2 F-162-2 F-162-2

WANAMIE COLLIERY
SCALE 1"=100'

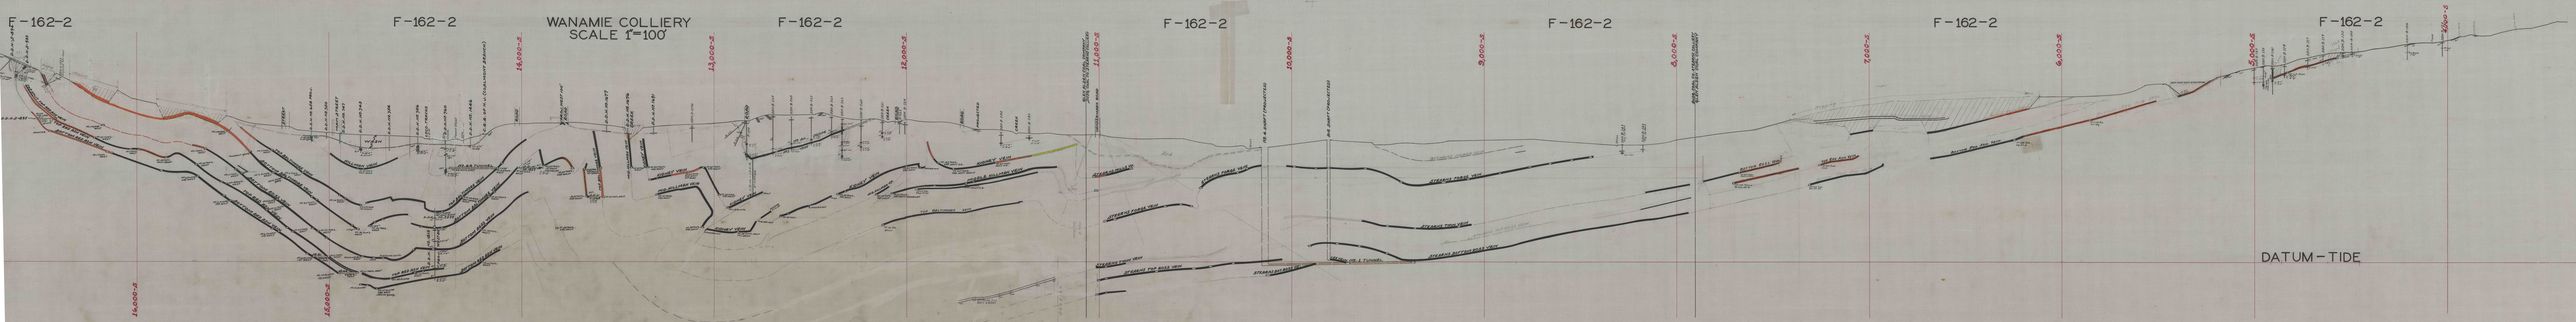

F-162-2 F-162-2 F-162-2 F-162-2 F-162-2 F-162-2