F-231-1

F-231-1

WANAMIE COLLIERY
SCALE 1"=100'

F-231-1

F-231-1

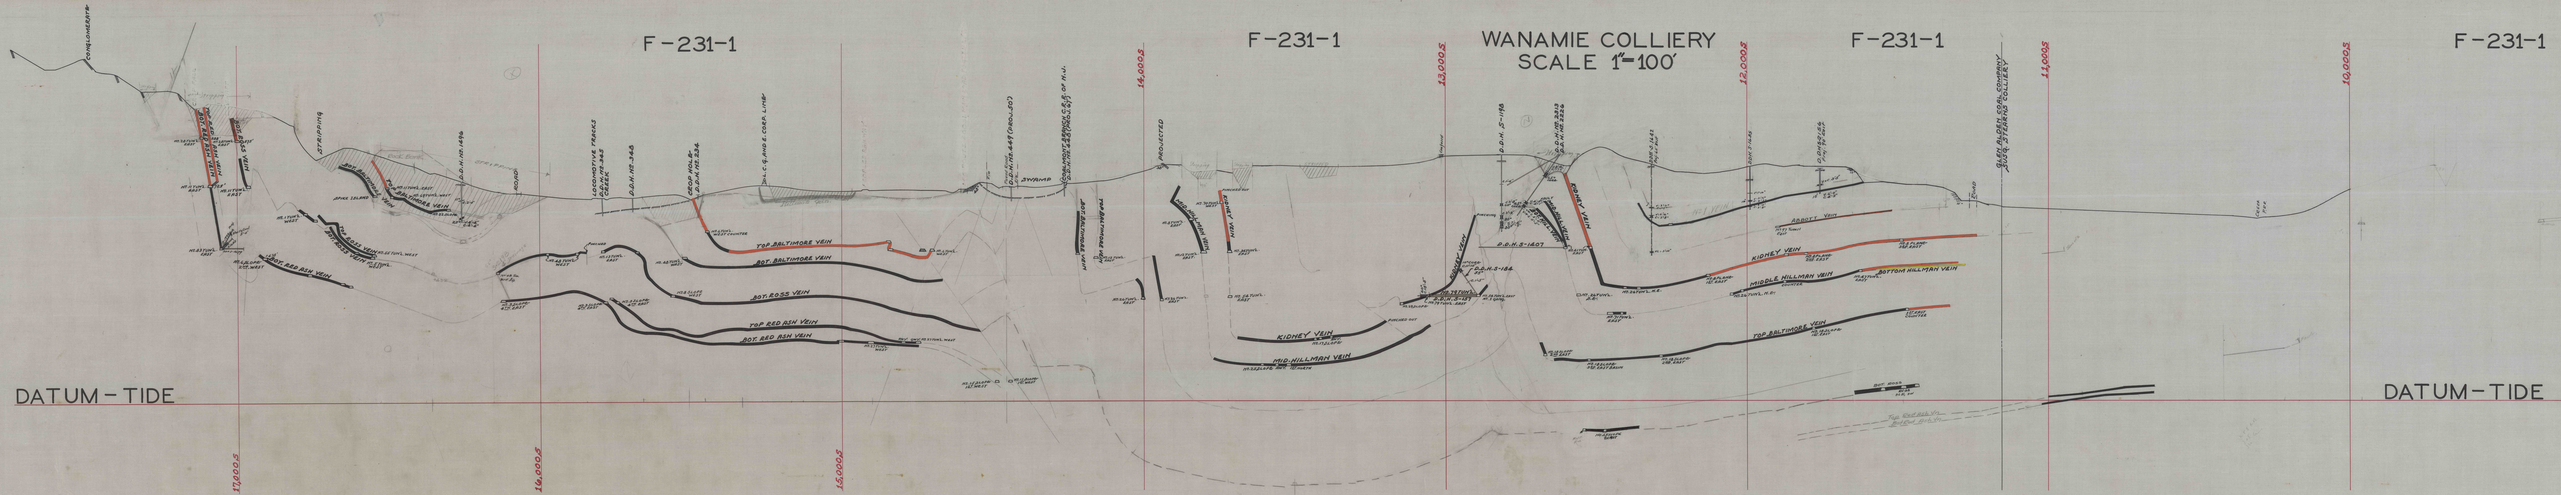

F-231-1

F-231-1

F-231-1

F-231-1