


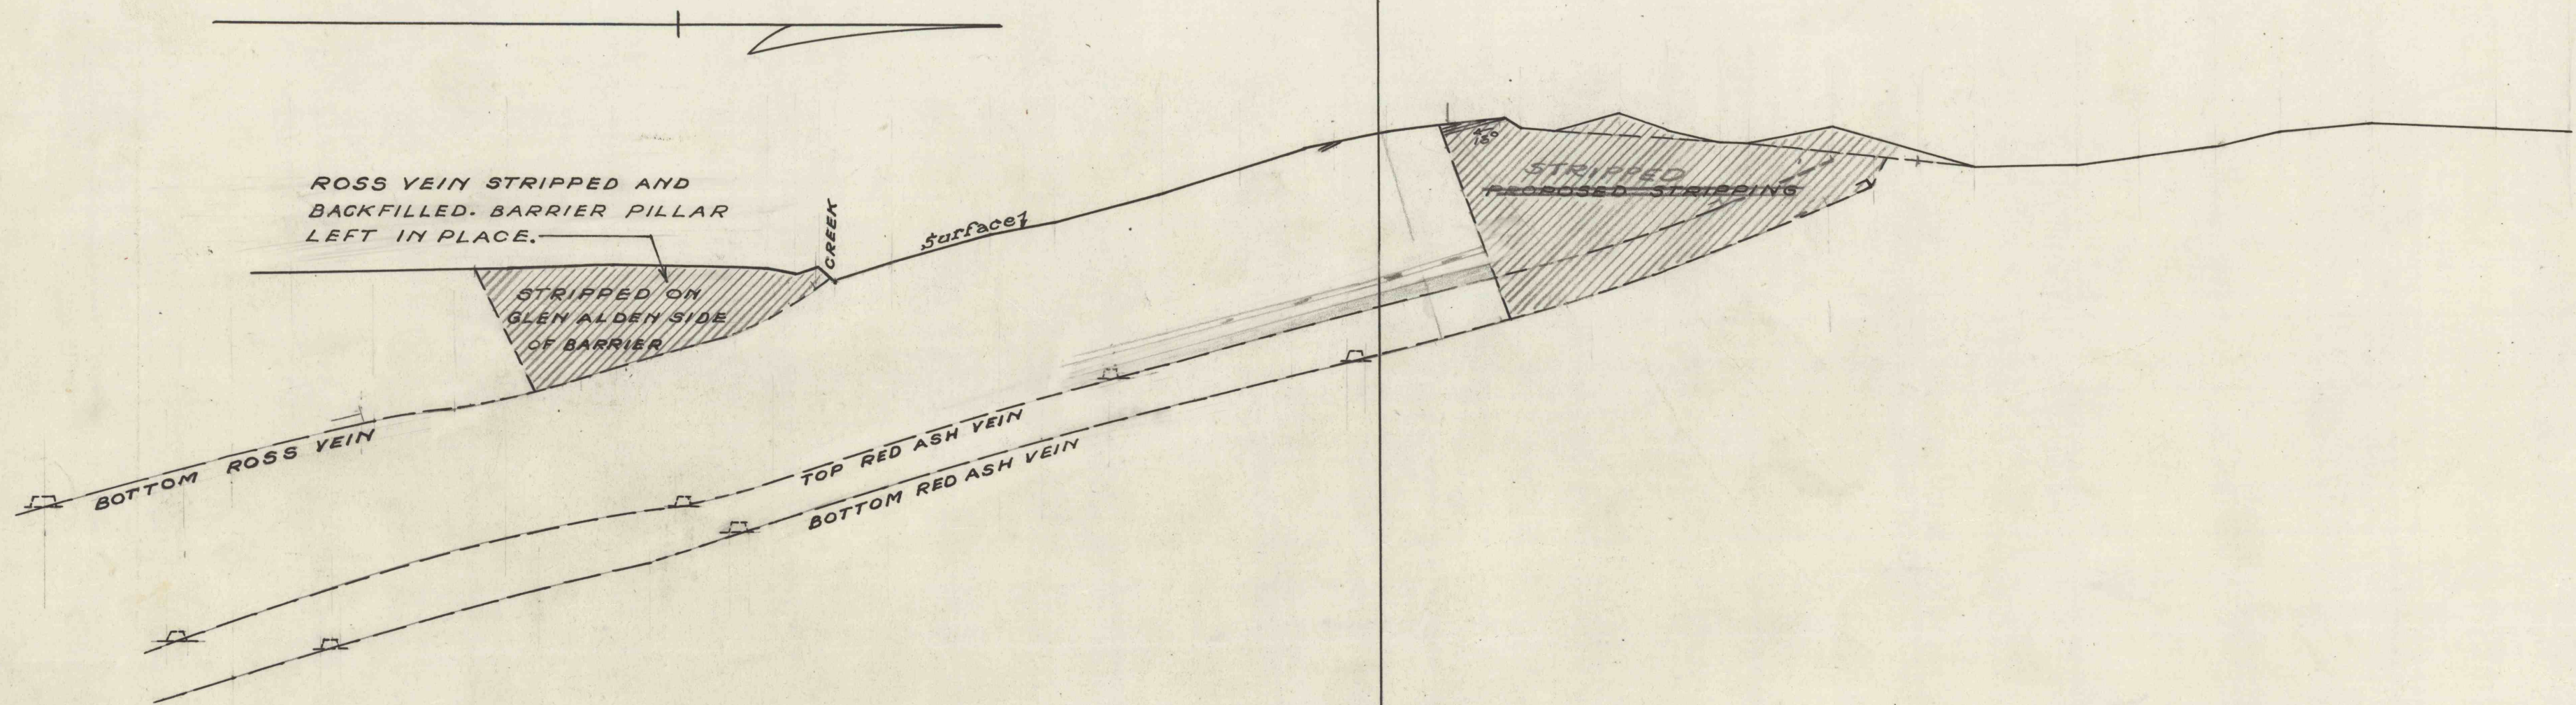

SECTION ALONG LAND LINE DIVIDING
SUSQUEHANNA COAL CO. & GLEN ALDEN COAL CO.
NEWPORT MTN. NORTH OF GLEN LYON
Scale 1"=100'

19,000 SOUTH

DATUM - ZERO 1