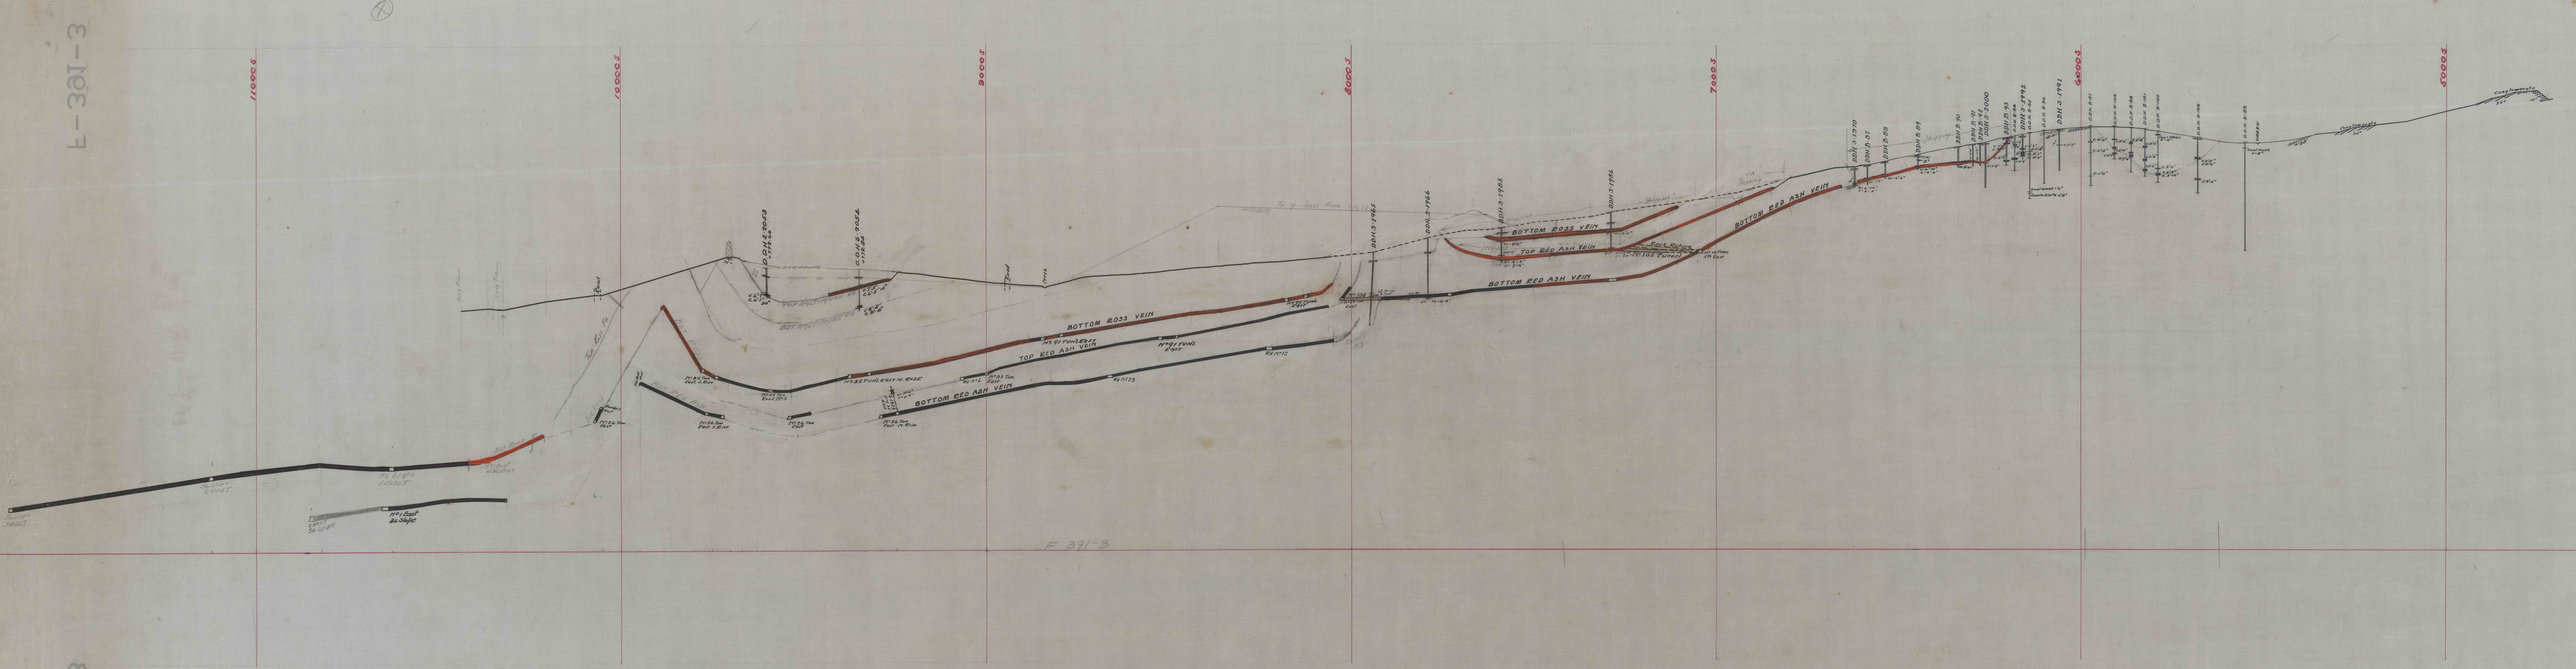
11000 S
10000 S
9000 S
8000 S
7000 S
6000 S
5000 S
BOTTOM ROSS VEIN
TOP RED ASH VEIN
BOTTOM RED ASH VEIN
F 391-3

F-391-3