


E-423

E-423

E-423

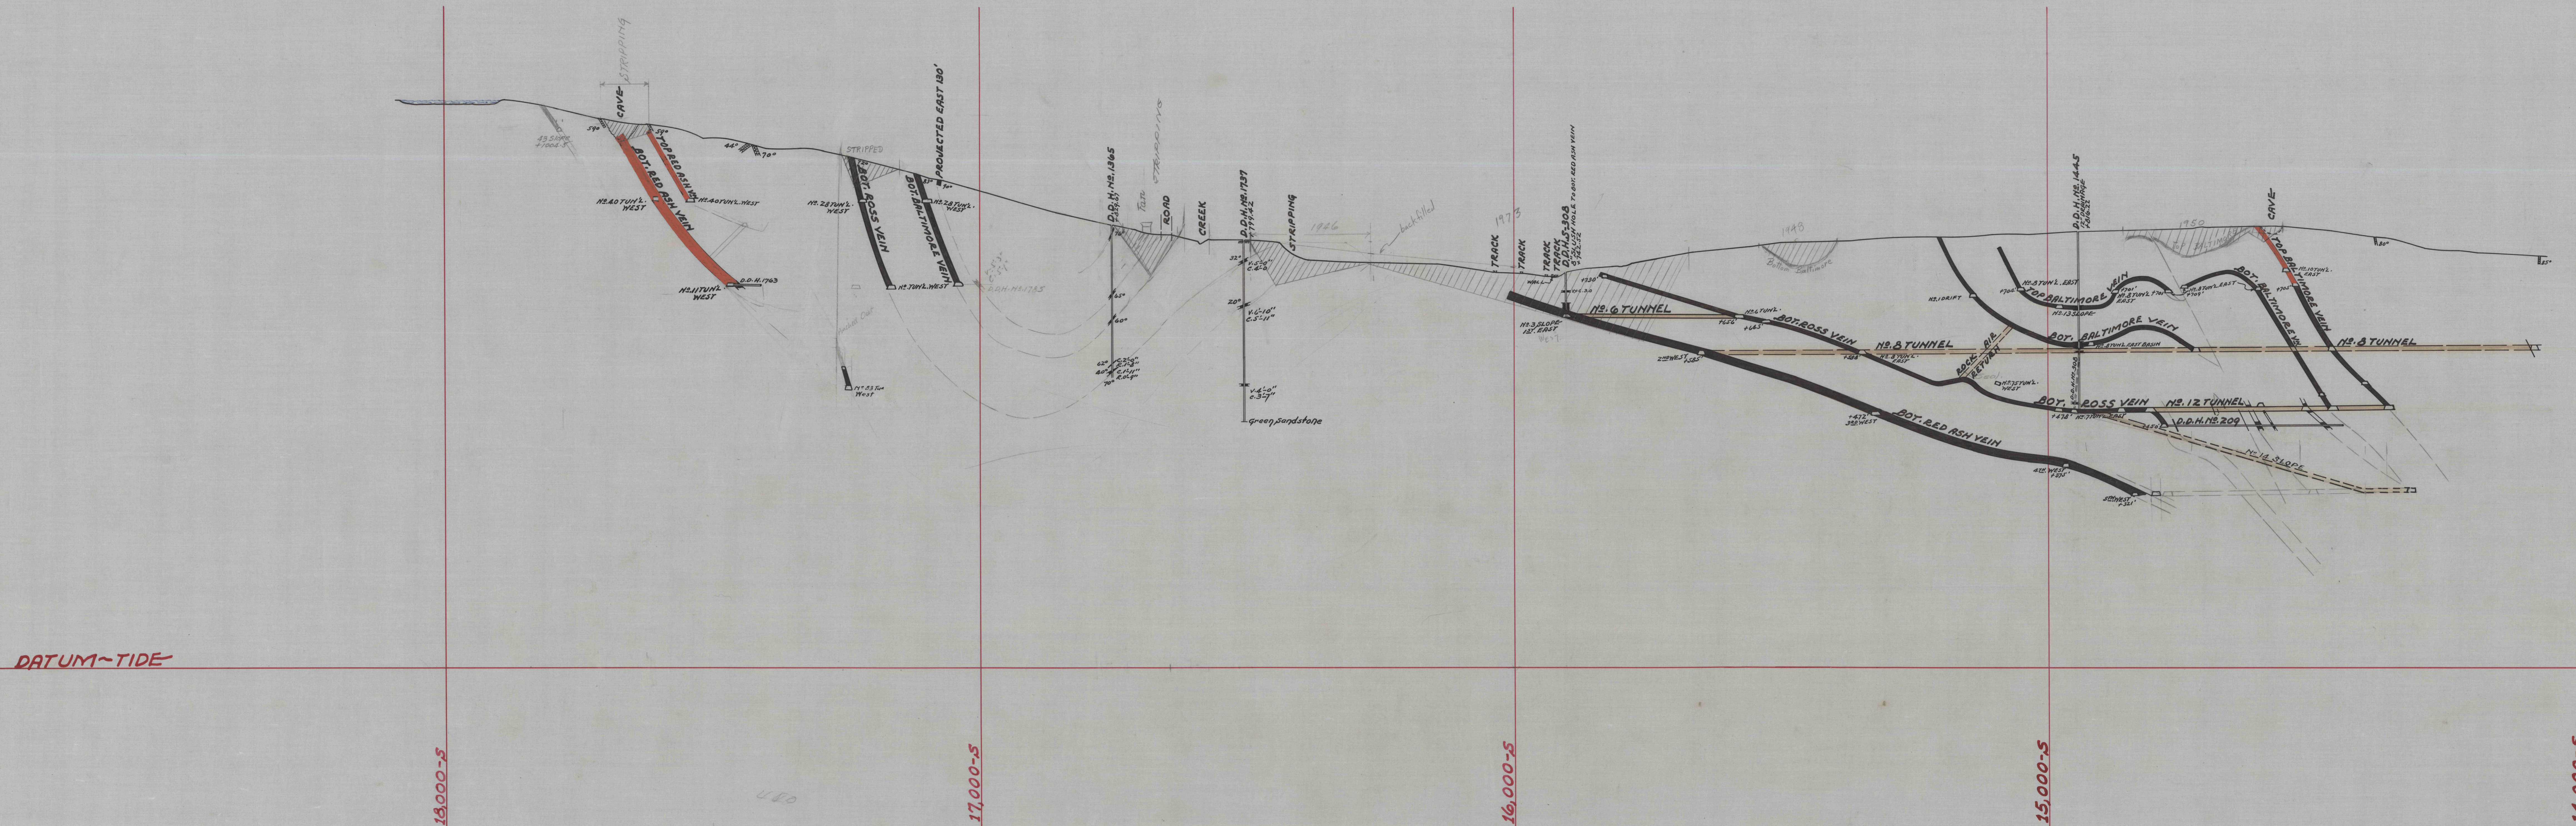

E-423

WANAMIE COLLIERY
SCALE 1"=100'

E-423