


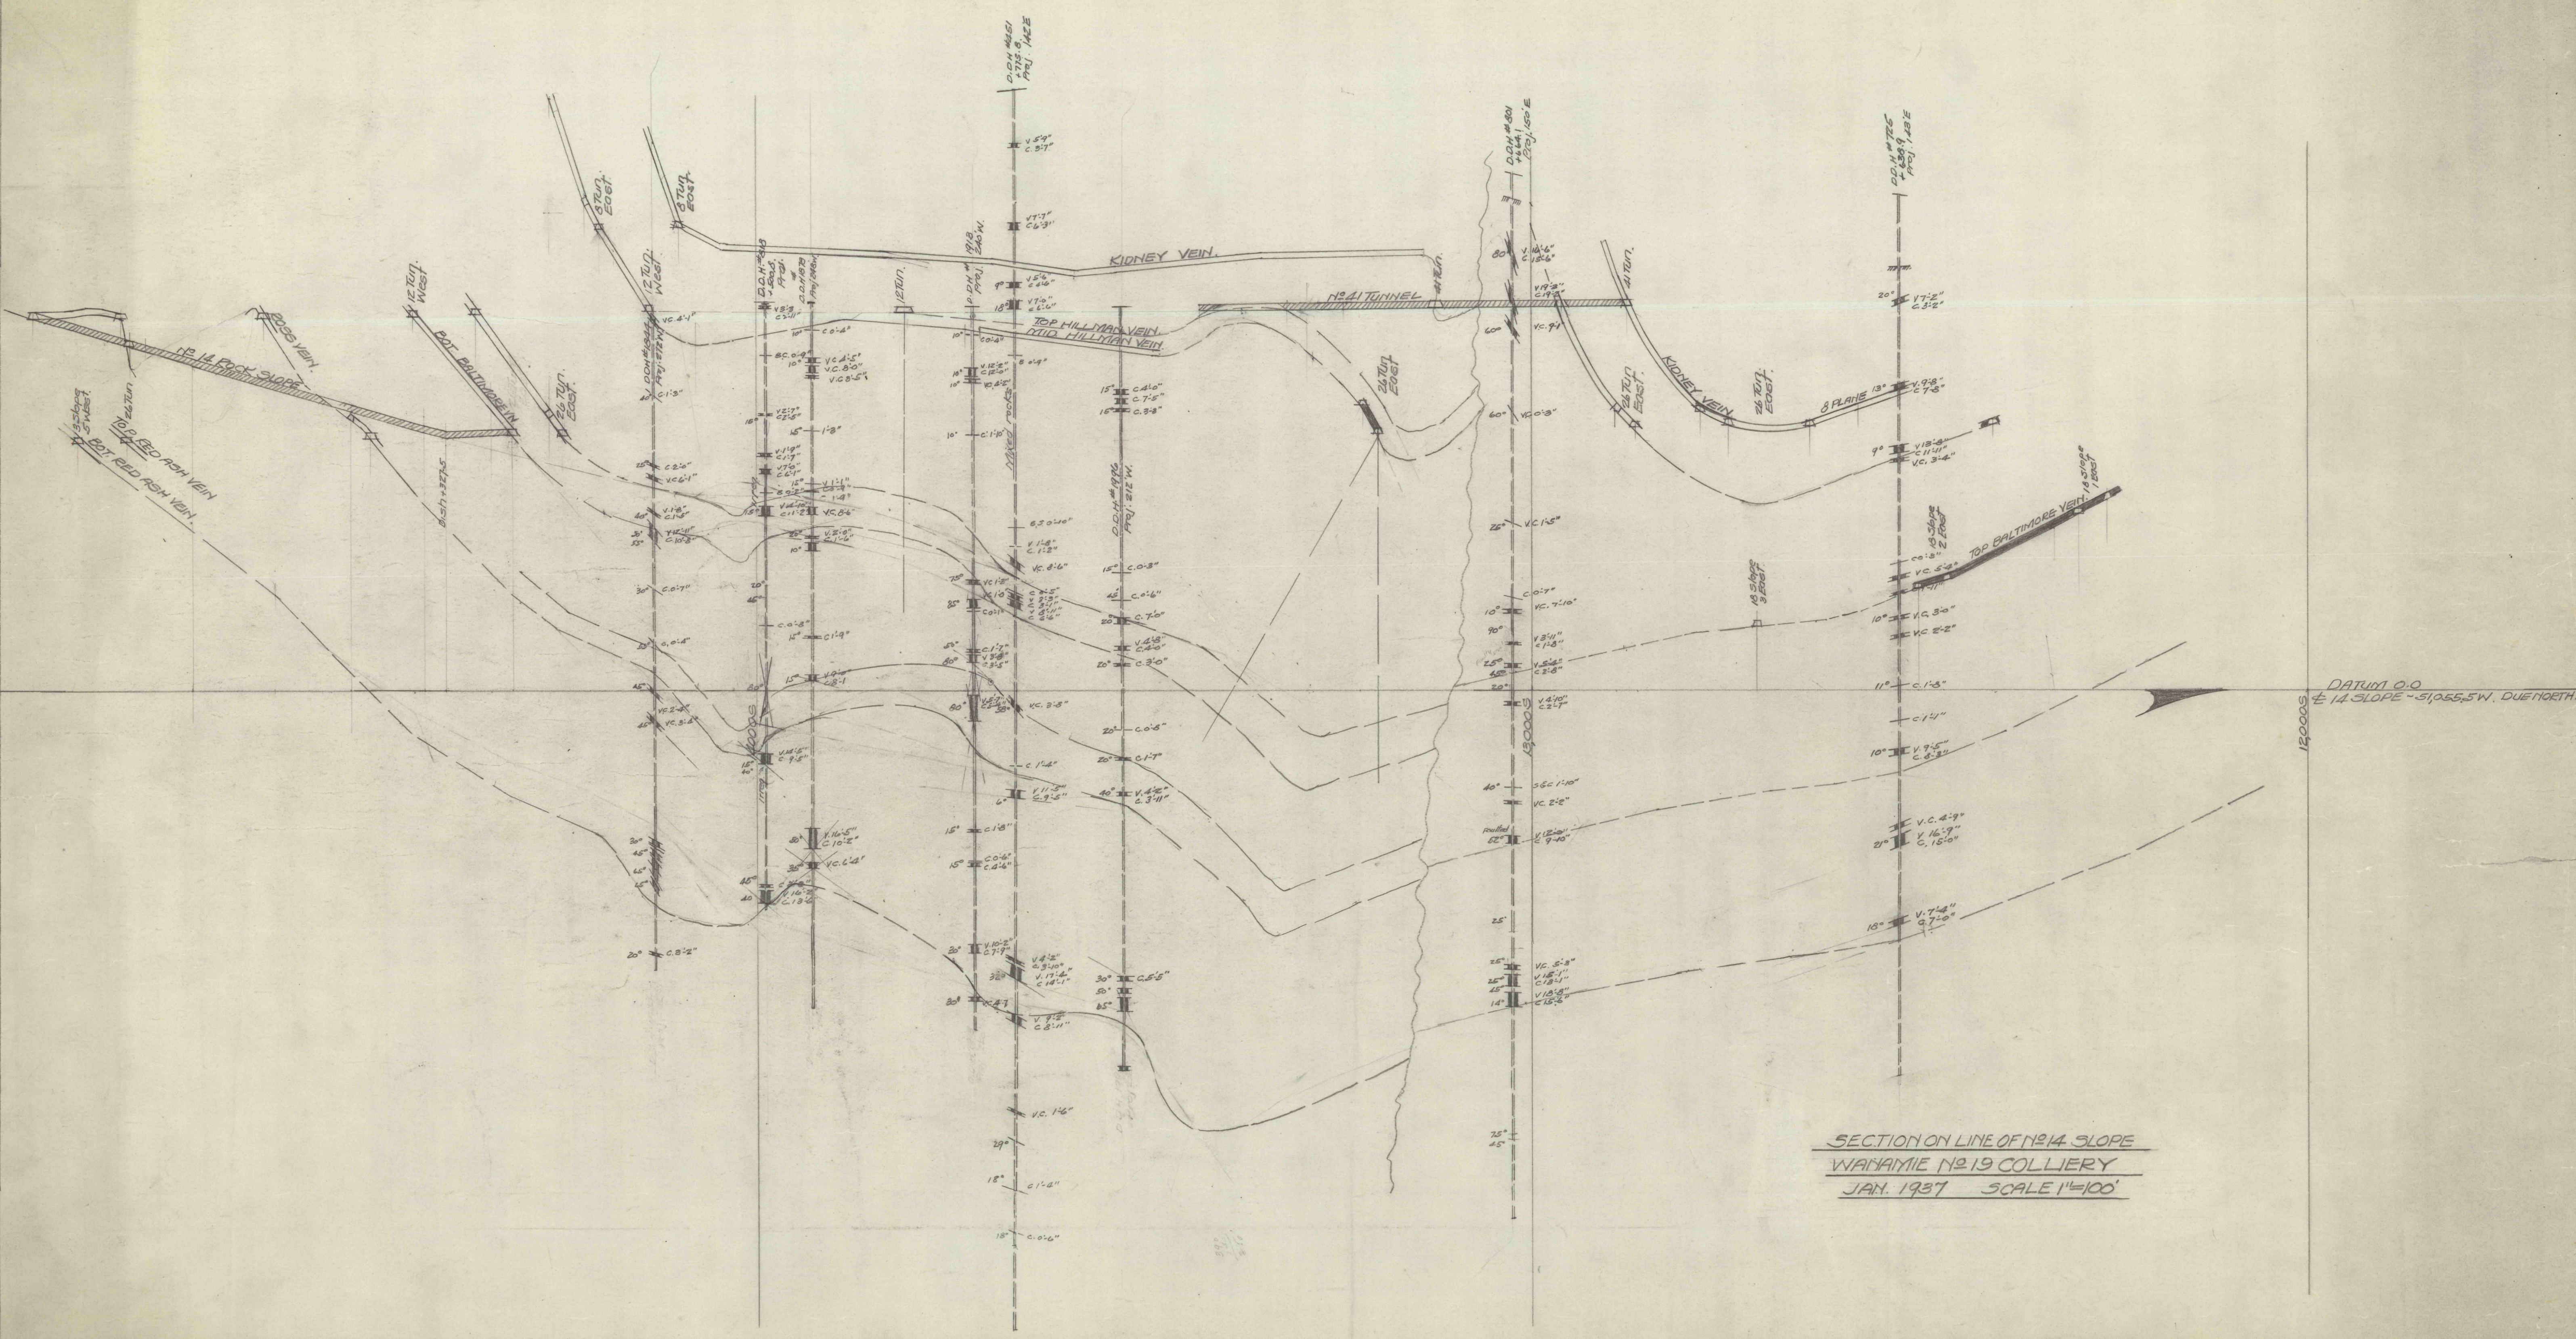

SECTION ON LINE OF NO. 14 SLOPE
WANAMIE NO. 19 COLLIERY
JAN. 1937 SCALE 1"=100'