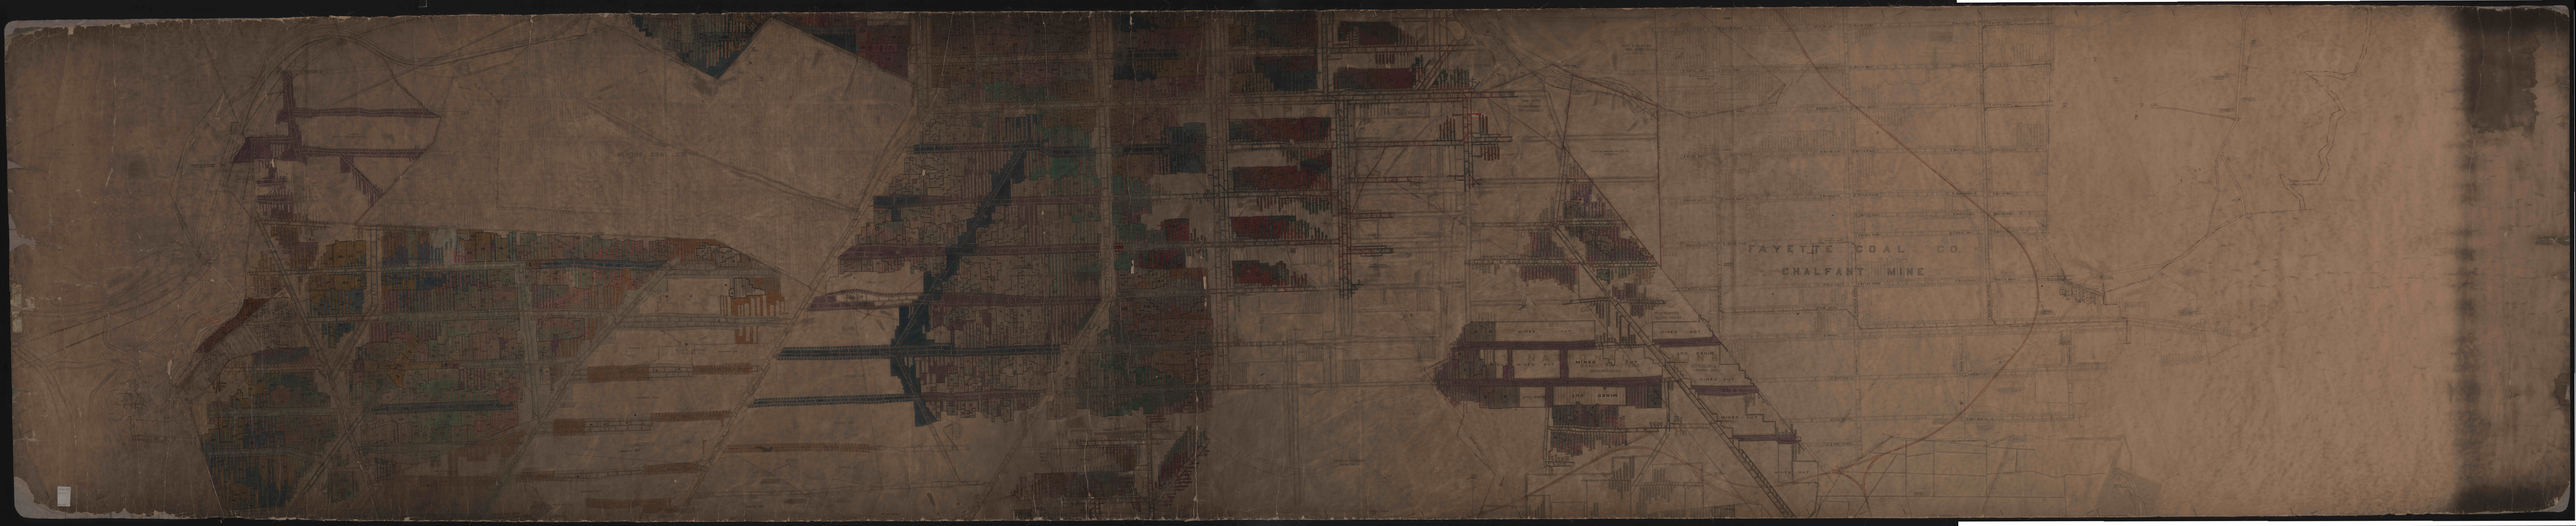
FAYETTE COAL CO.
CHALFANT MINE