


George Dove
Surveyor. 158,669 shares

52
51
50
49
47

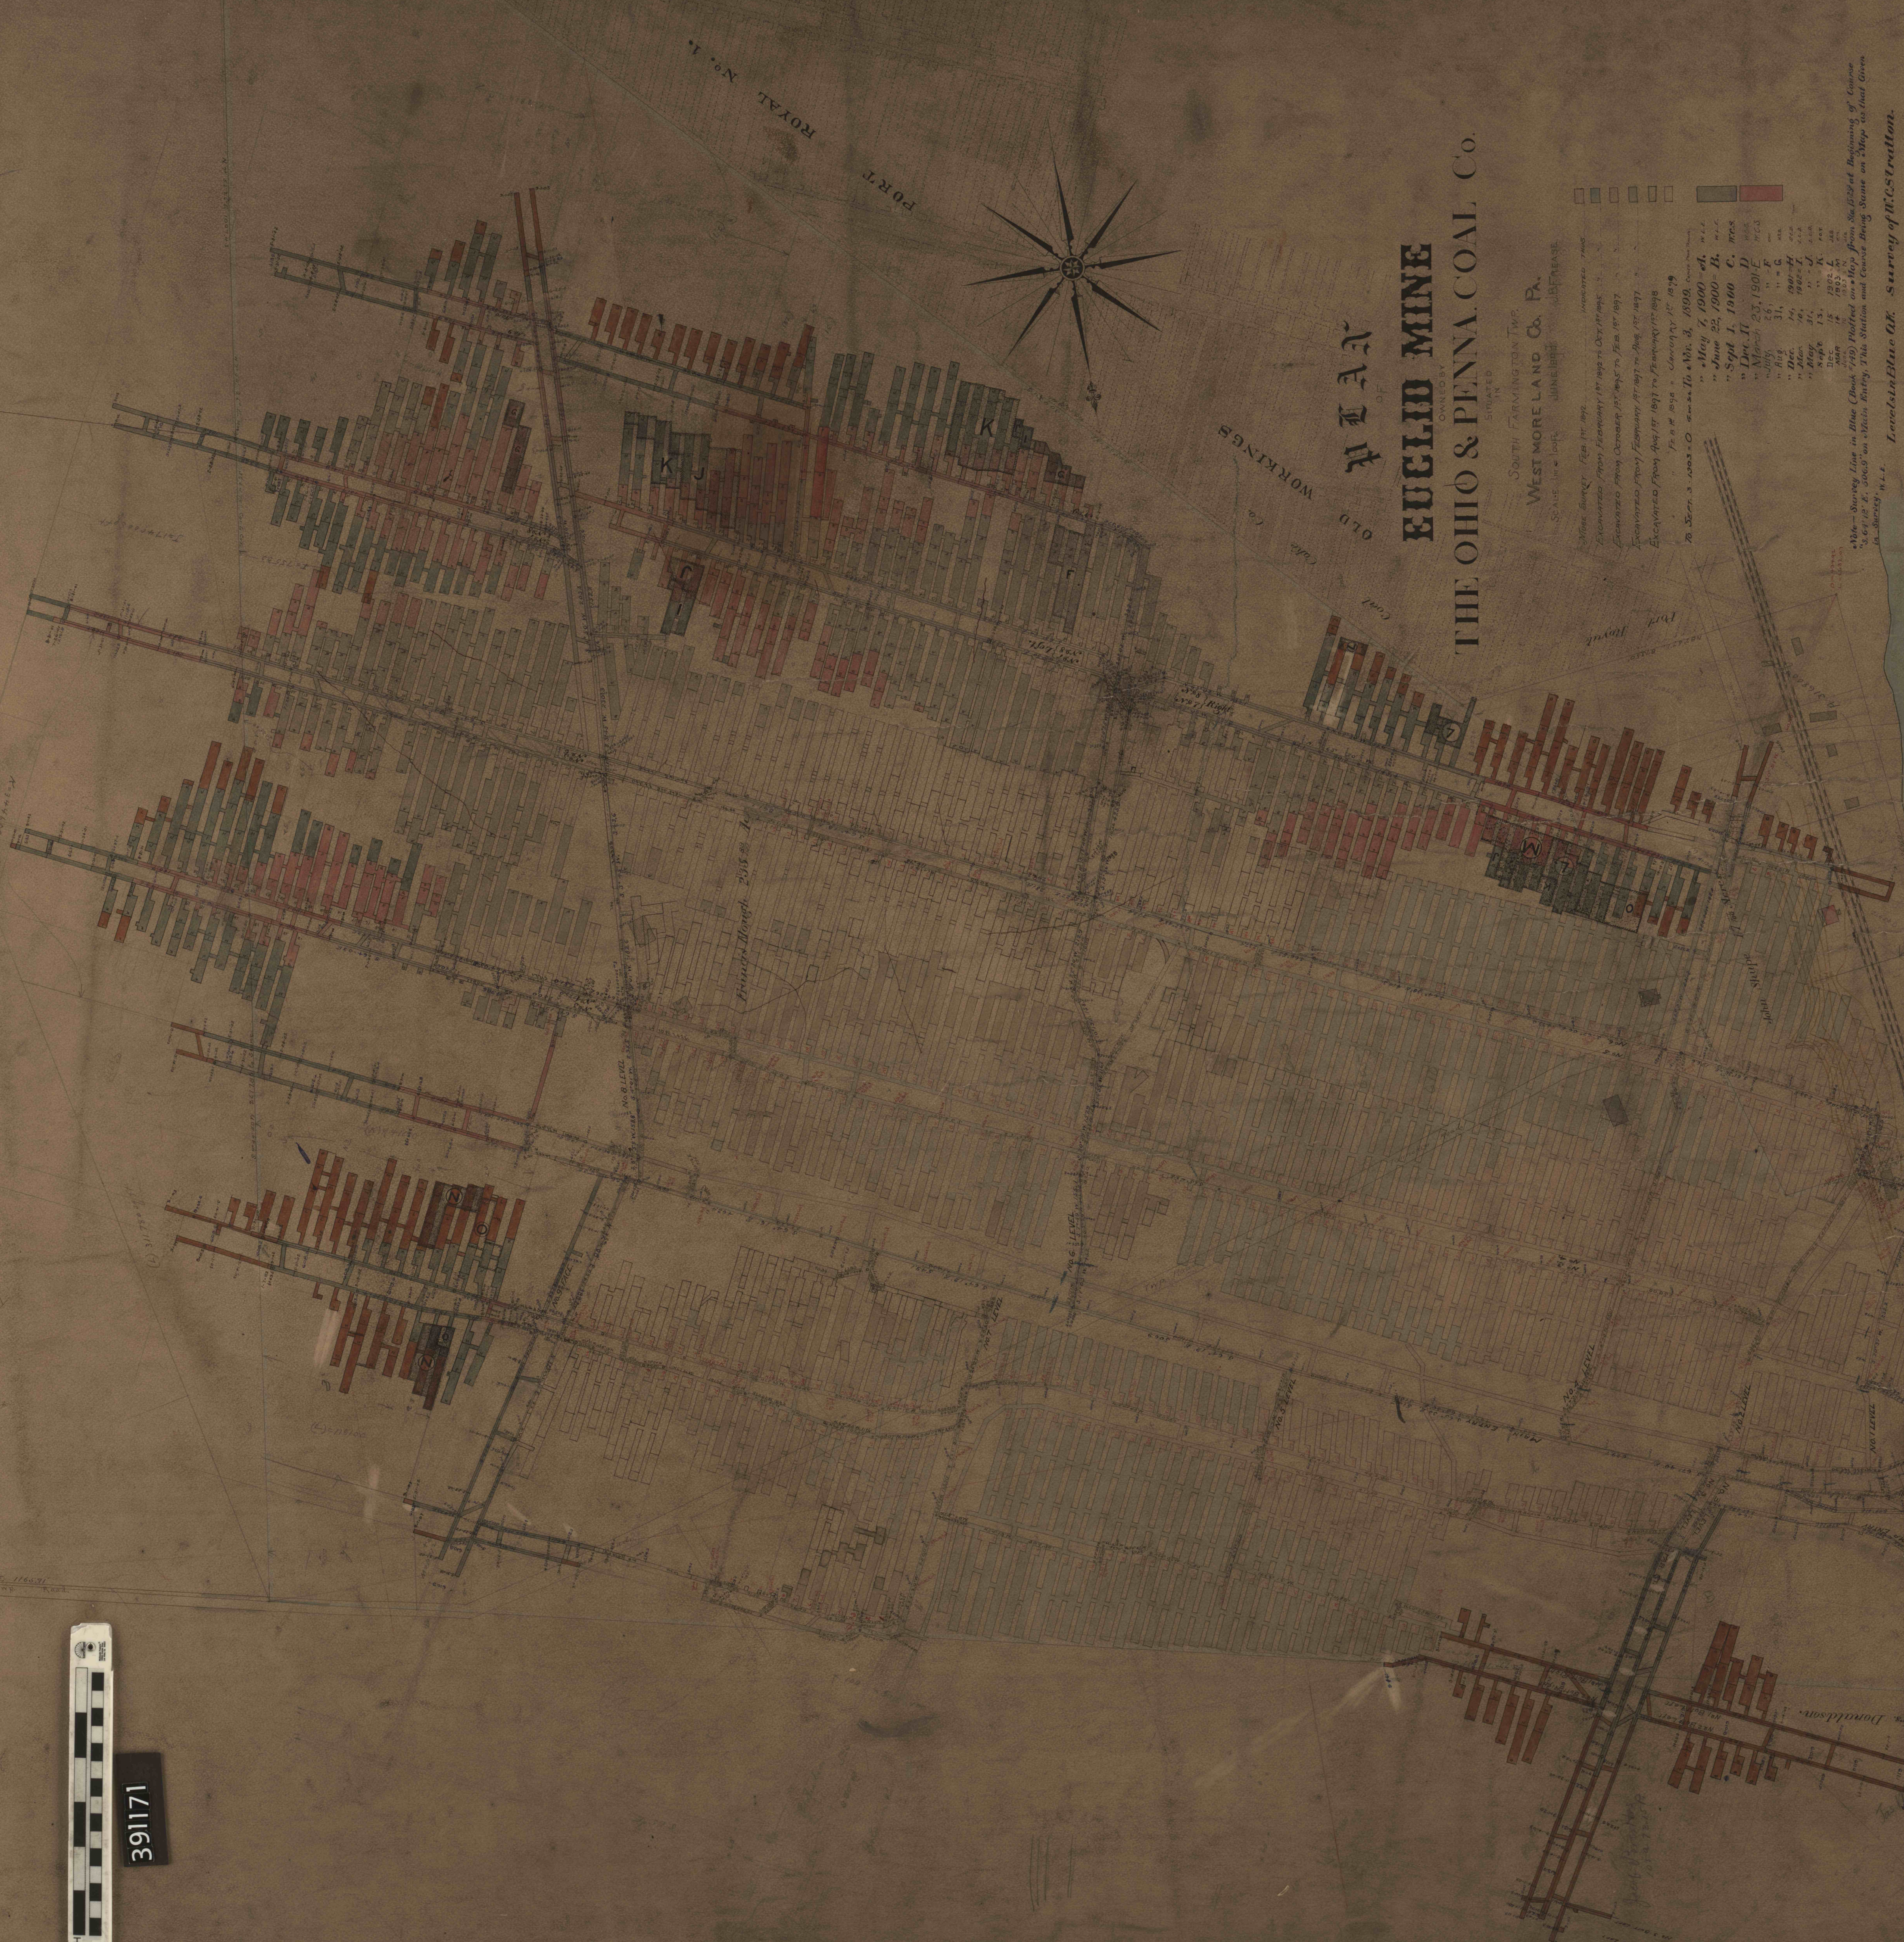


OF
EUCLID MINE
 THE OHIO & PENNA. COAL CO.

WESTMORELAND CO. PA.

Red	Blue	Green	Black
...

Surveyed by
 L. S. ...
 1899

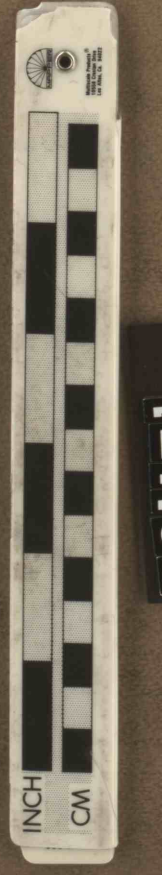

391171

46
49
50
51
52
53

68 70
67 69 71