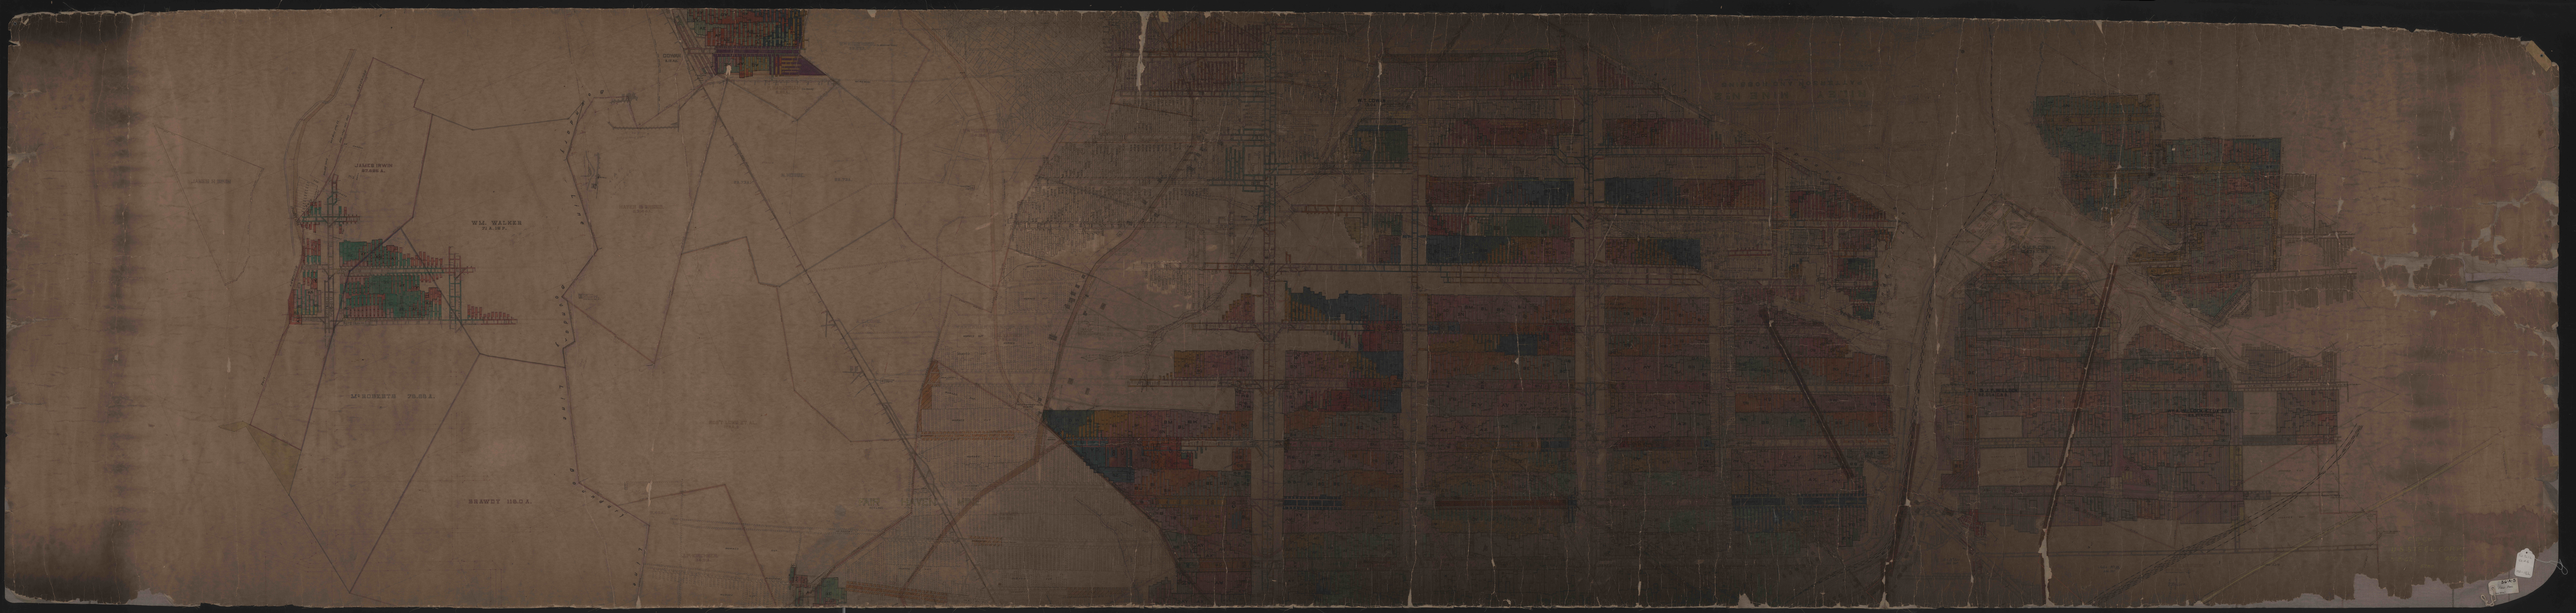
JAMES IRVIN
WM. WALKER
McROBERTS
BEAWDY