


60
59

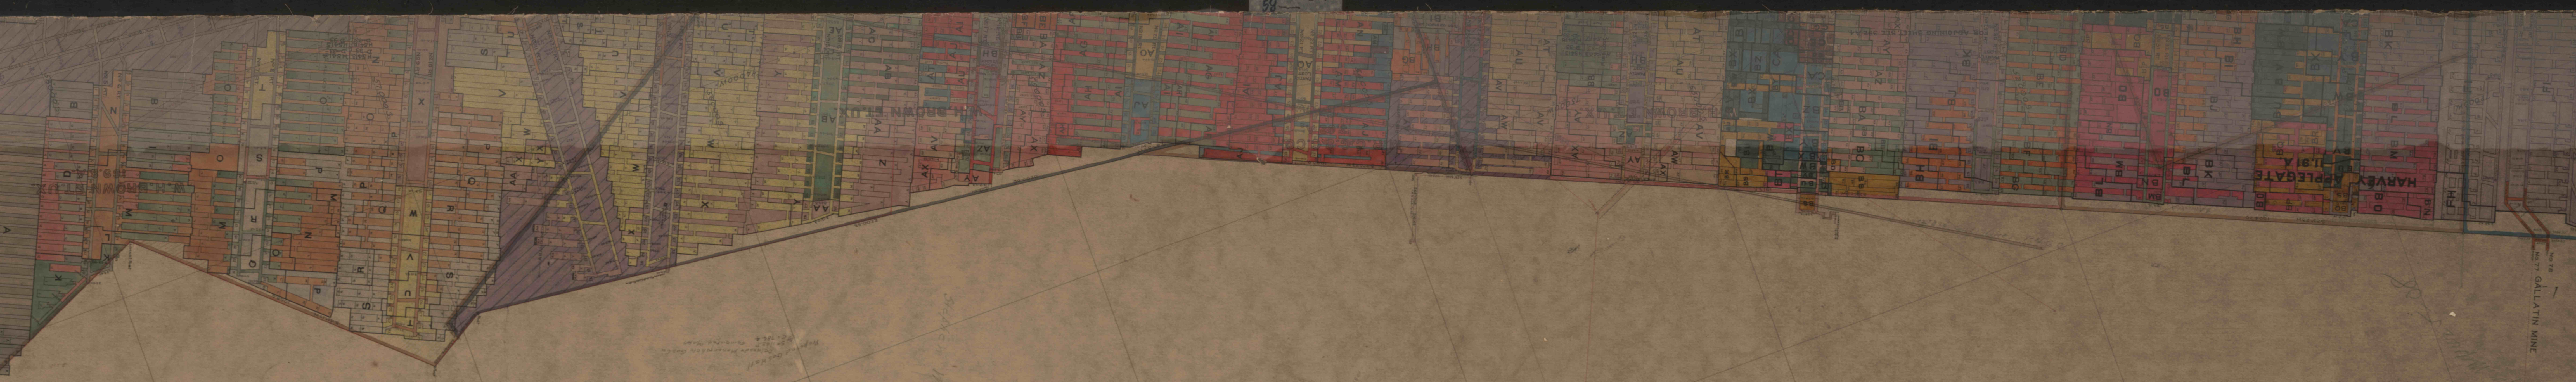

370-57-1000

