
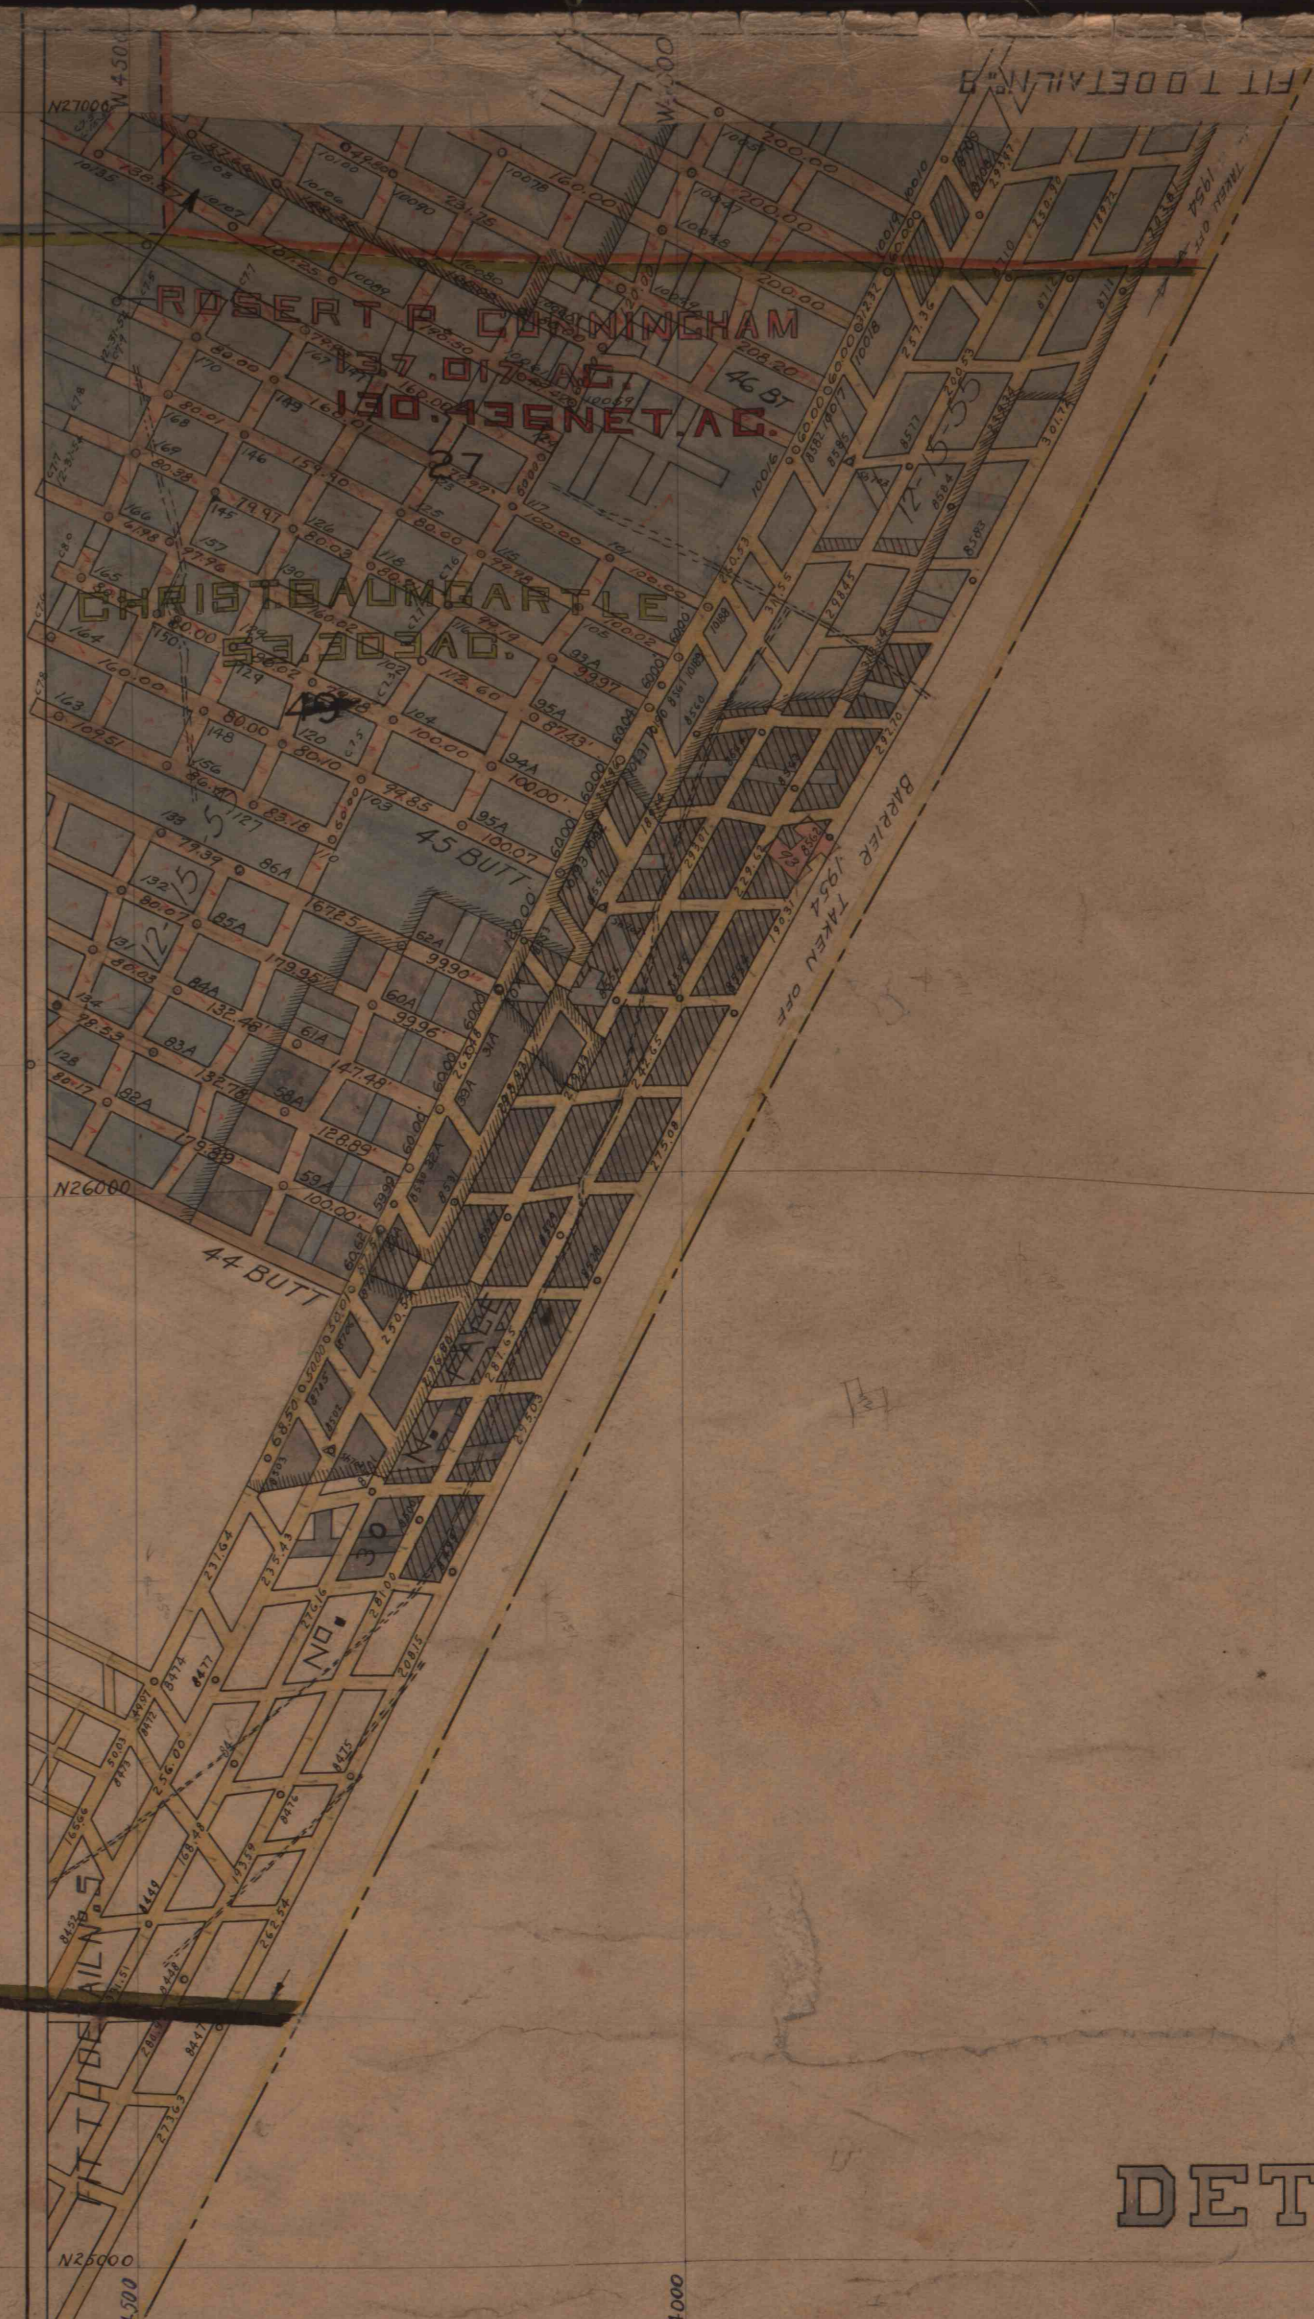


2137

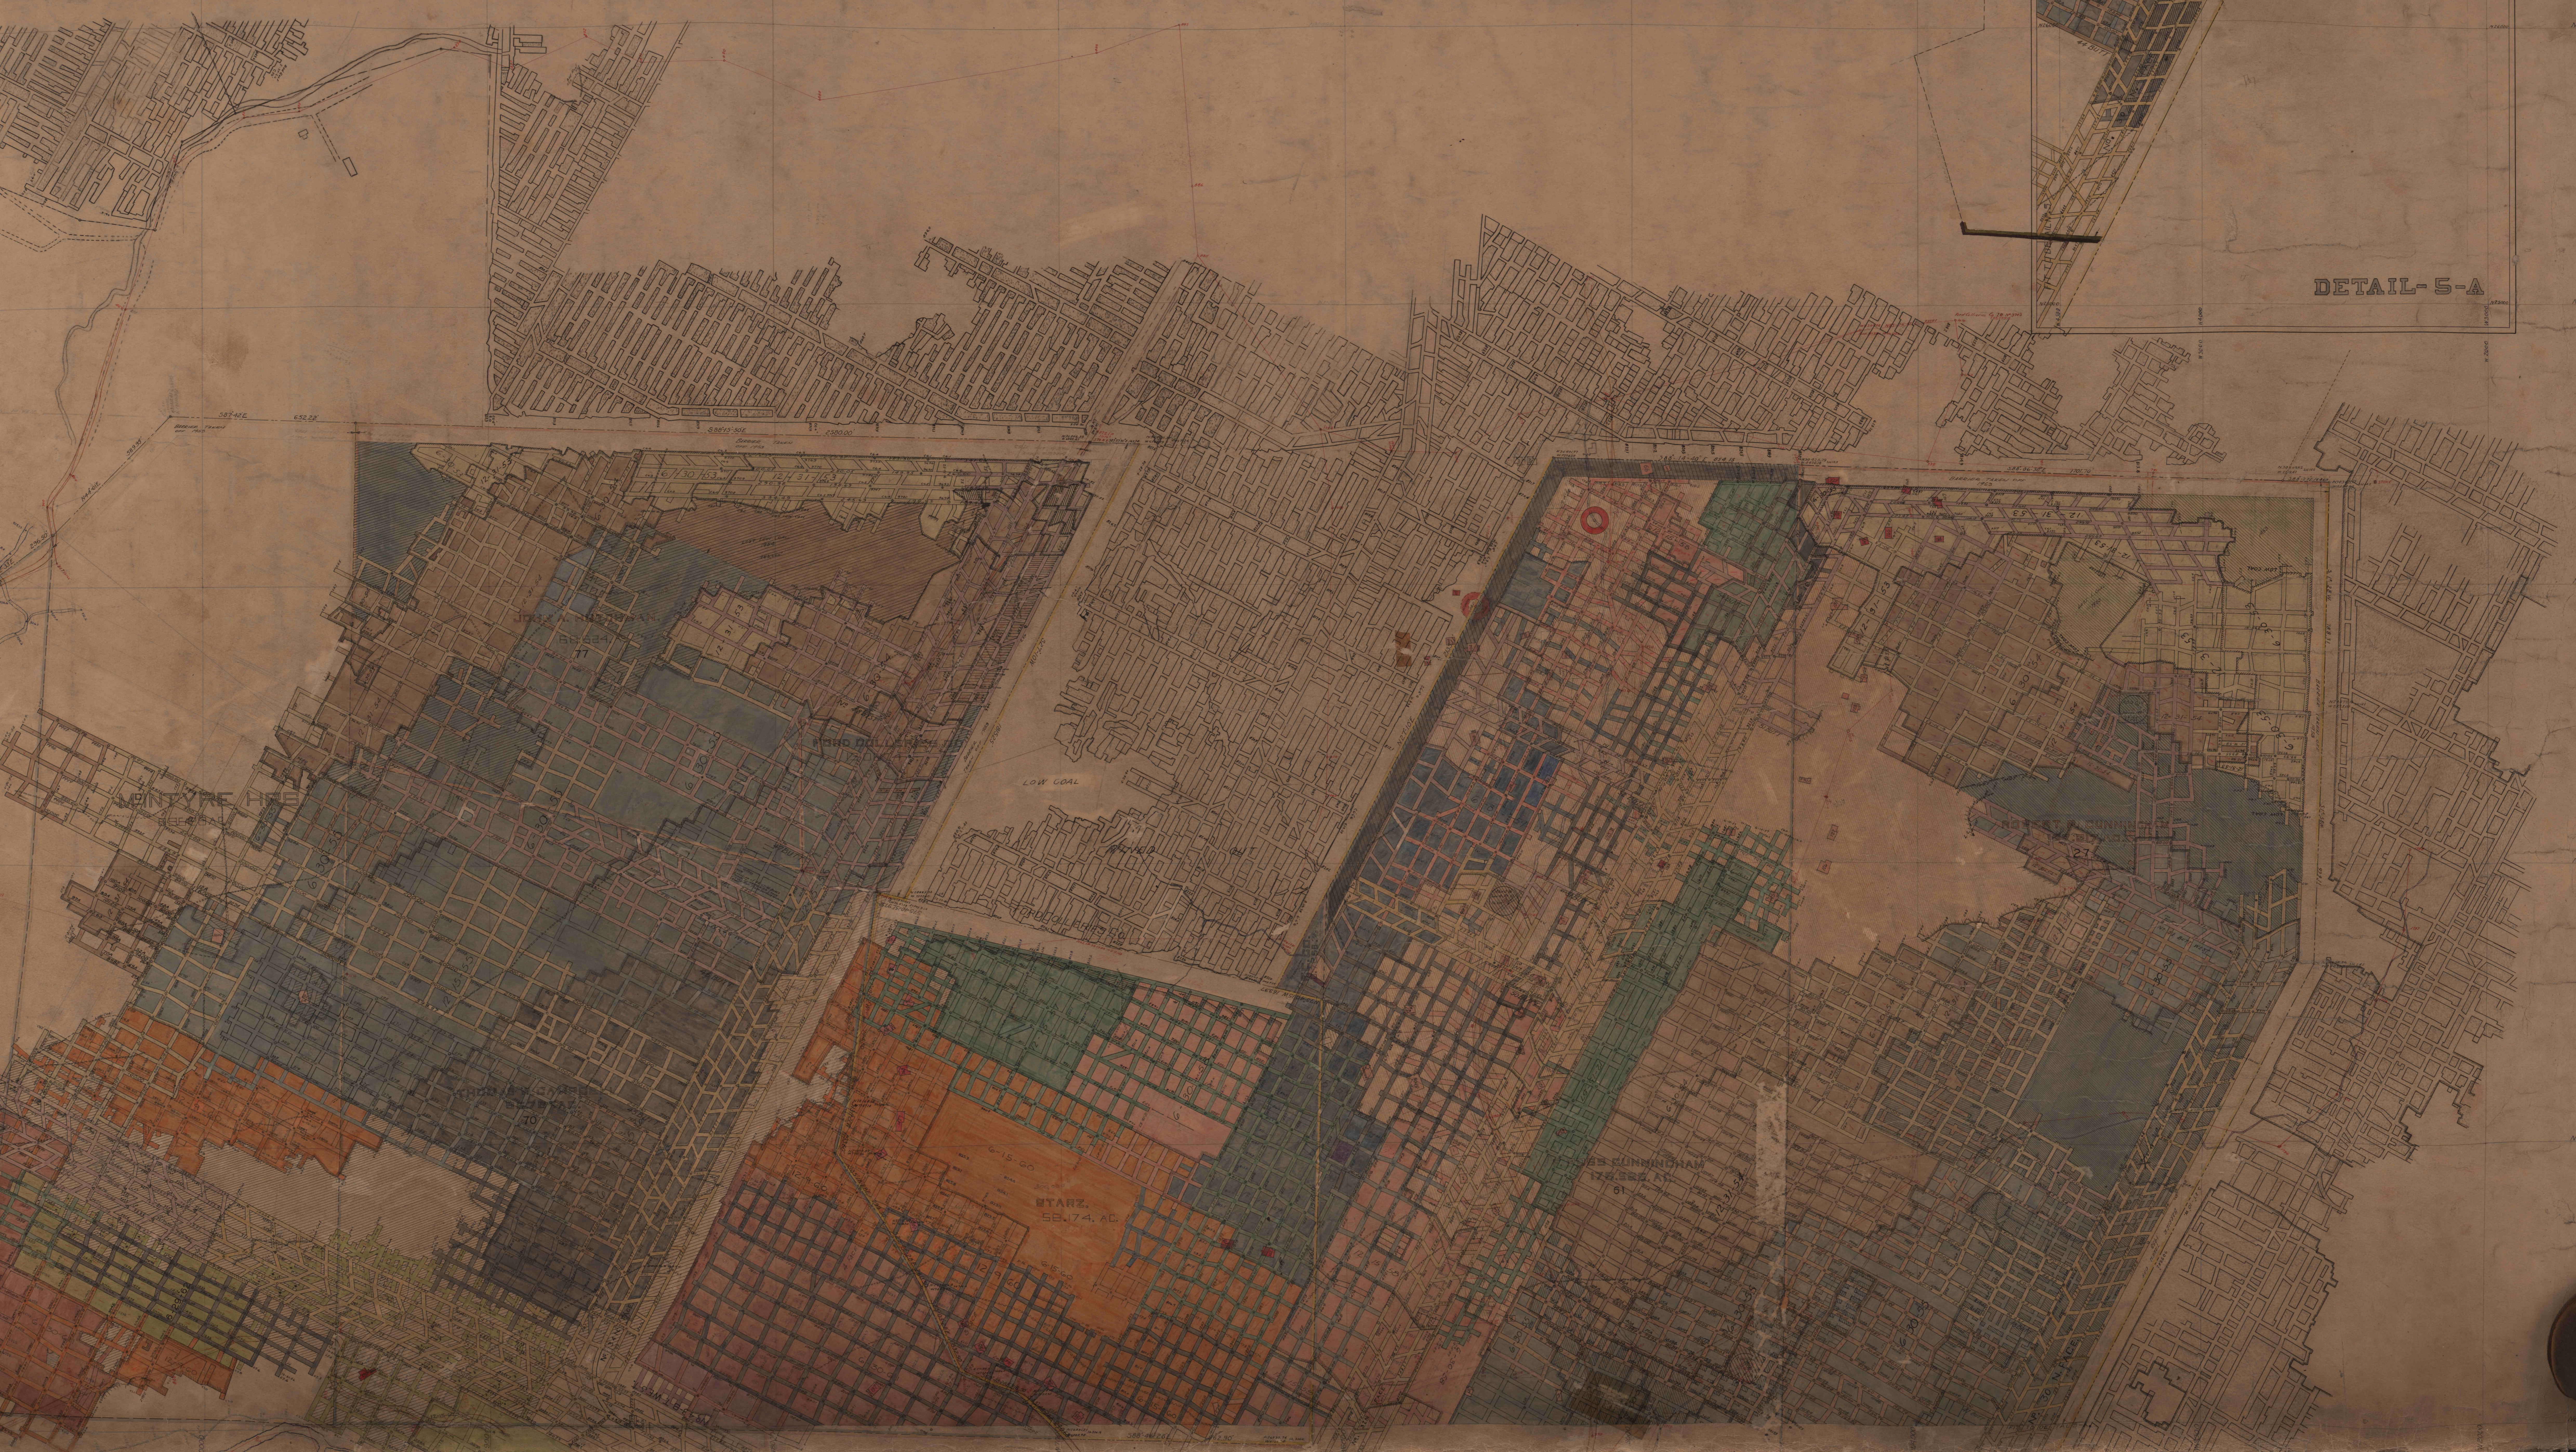

DETAIL-5-A

STARZ
SE. 74. AC

SE MINNICHAN
74. 01


