

60  
59



**MAP**  
OF  
**SHAFT N° 2 DIPS**  
Belonging to the  
**Penn Gas Coal Co**


SCALE  
1 INCH = 100 FEET

**EXPLANATORY NOTE**

DIPS STARTED OCTOBER 1899

AGES OF COAL MINED FROM OCTOBER 1899 TO JANUARY 1899	
JANUARY 1899	1899
1900	1901
1901	1902
1902	1903
1903	1904
1904	1905
1905	1906

OCTOBER 31<sup>st</sup> 1910    OCTOBER 31<sup>st</sup> 1911

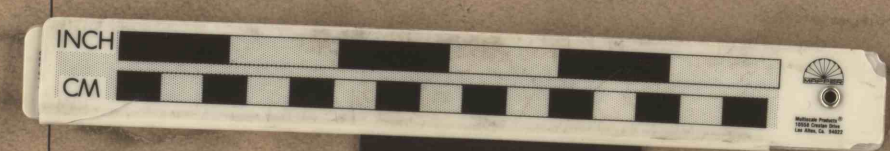

390816

50  
59  
60  
61