
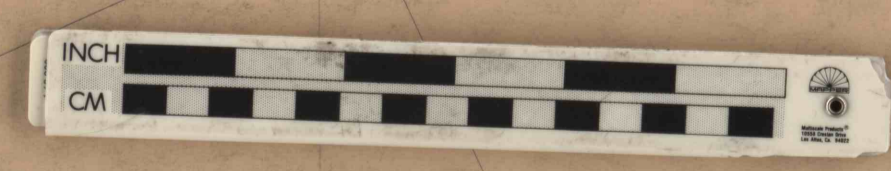


38
37
36

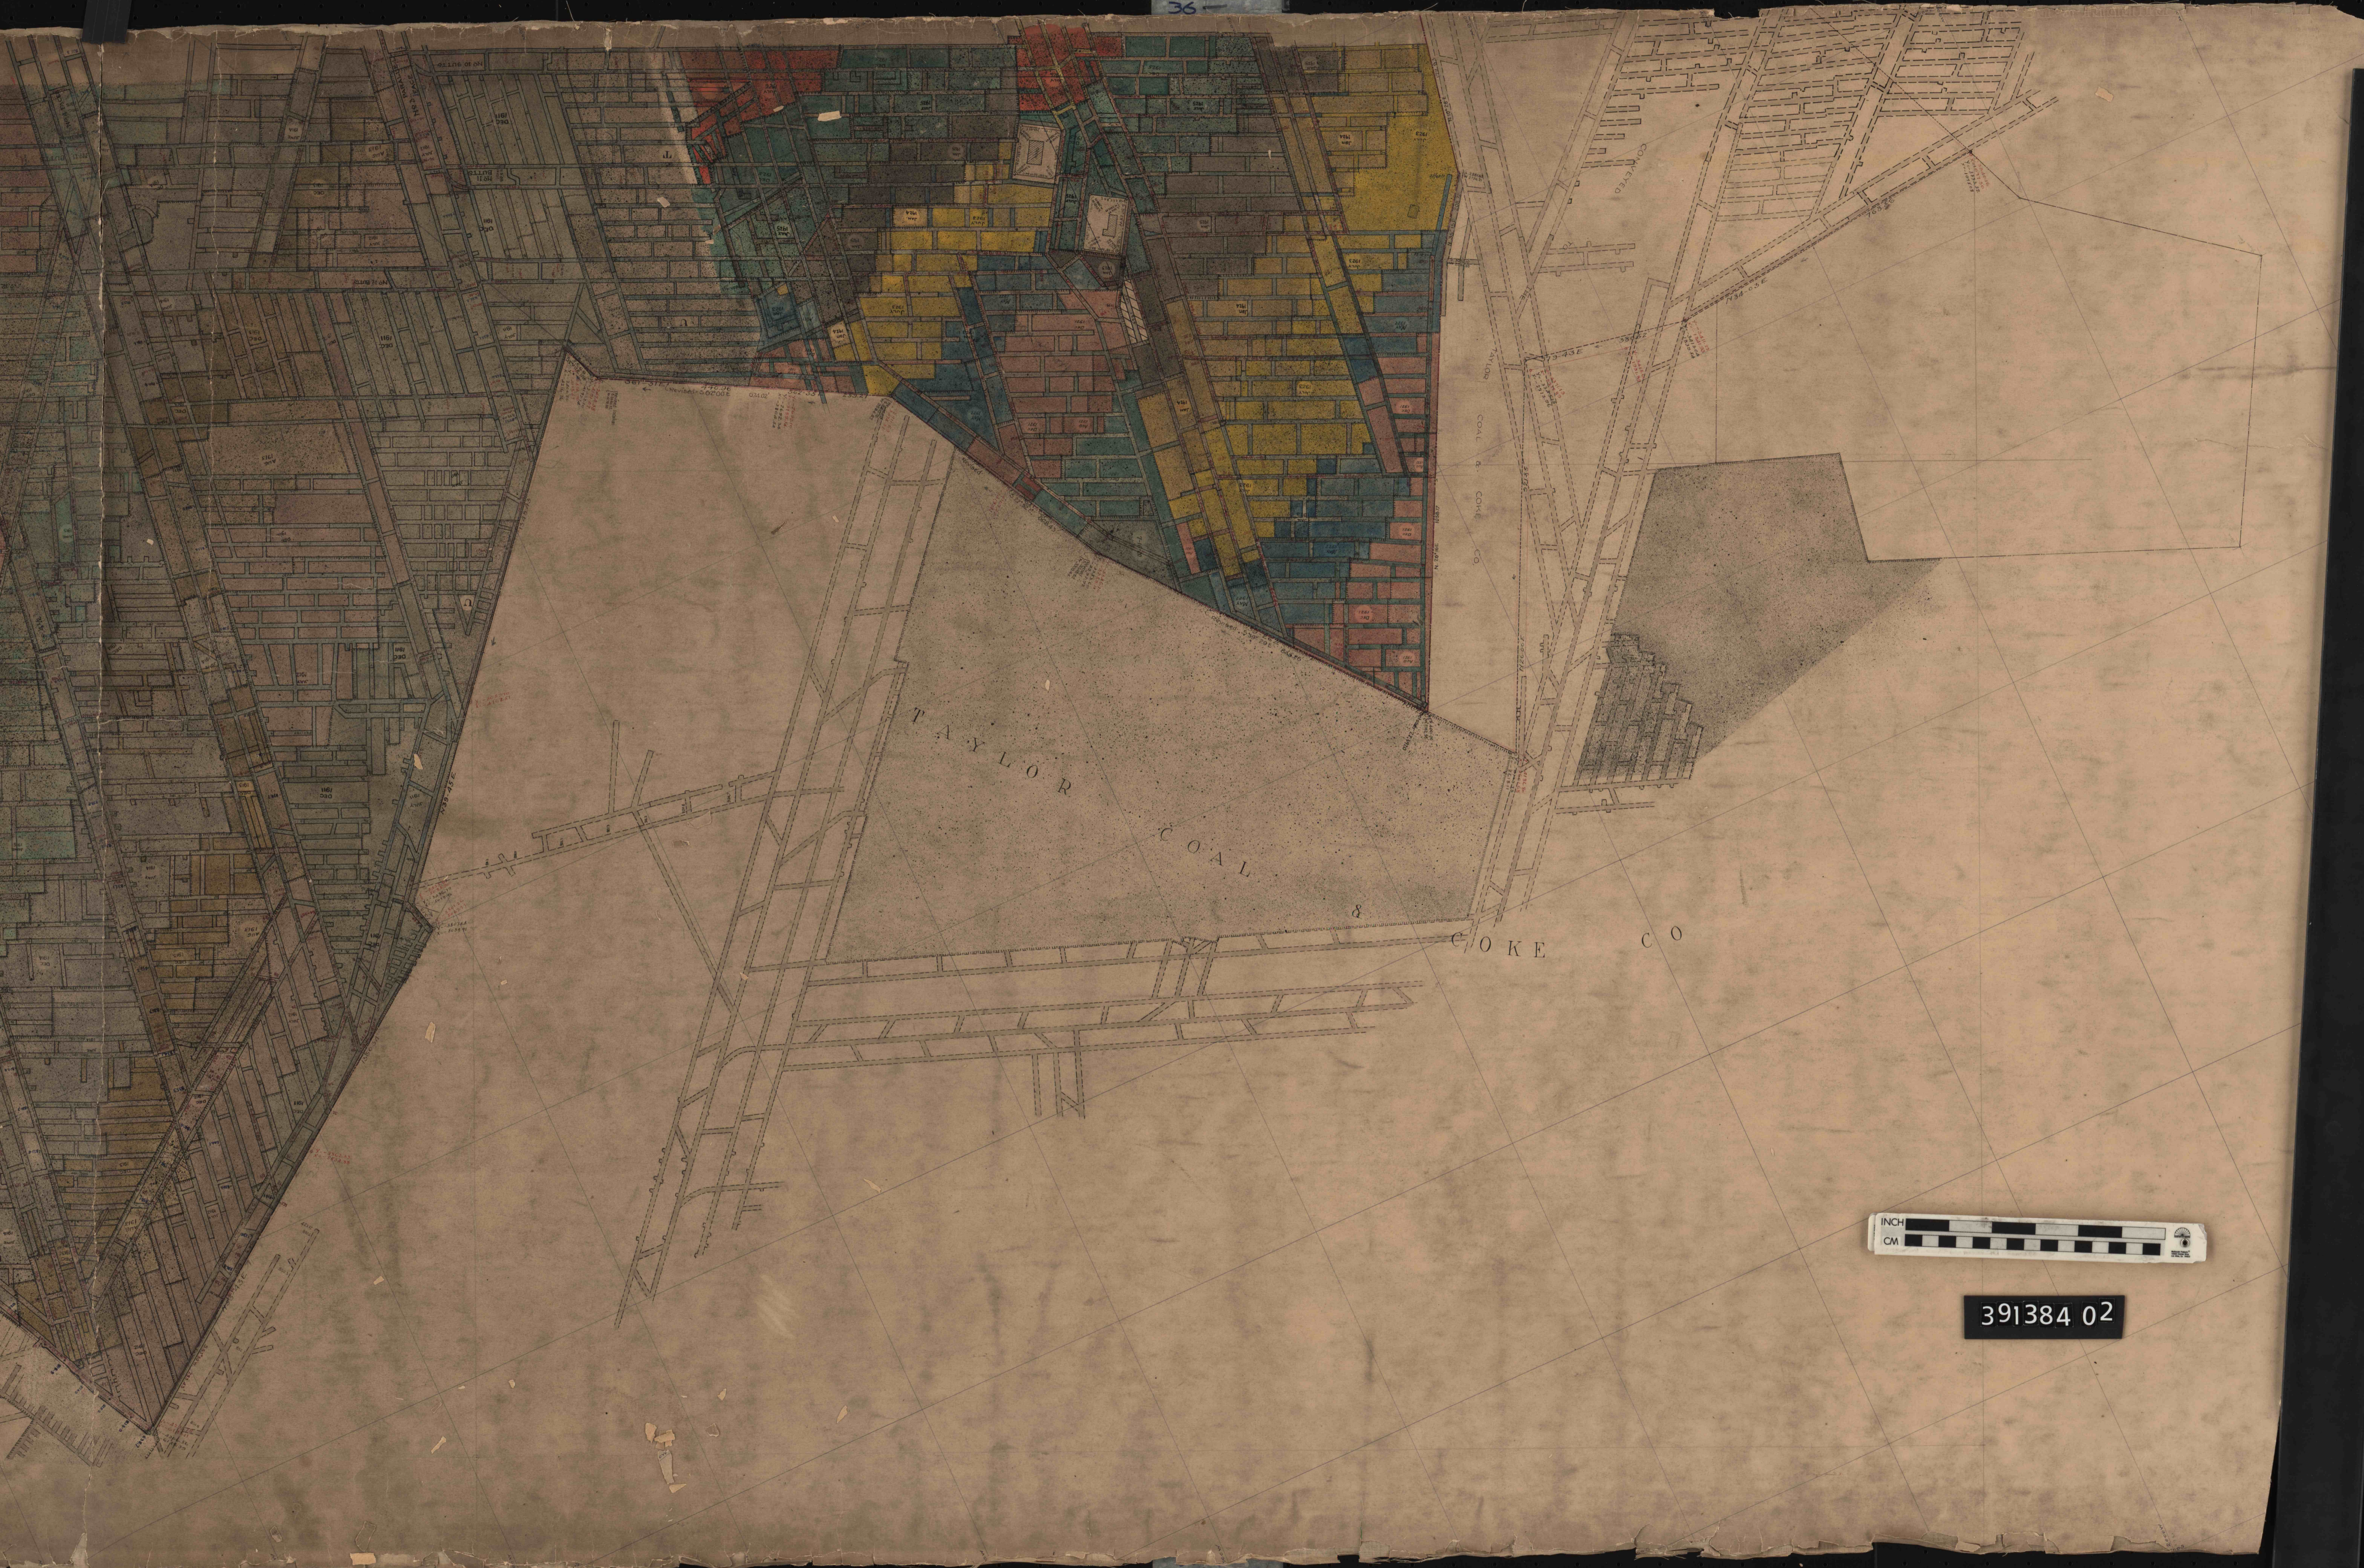

391384 02

37