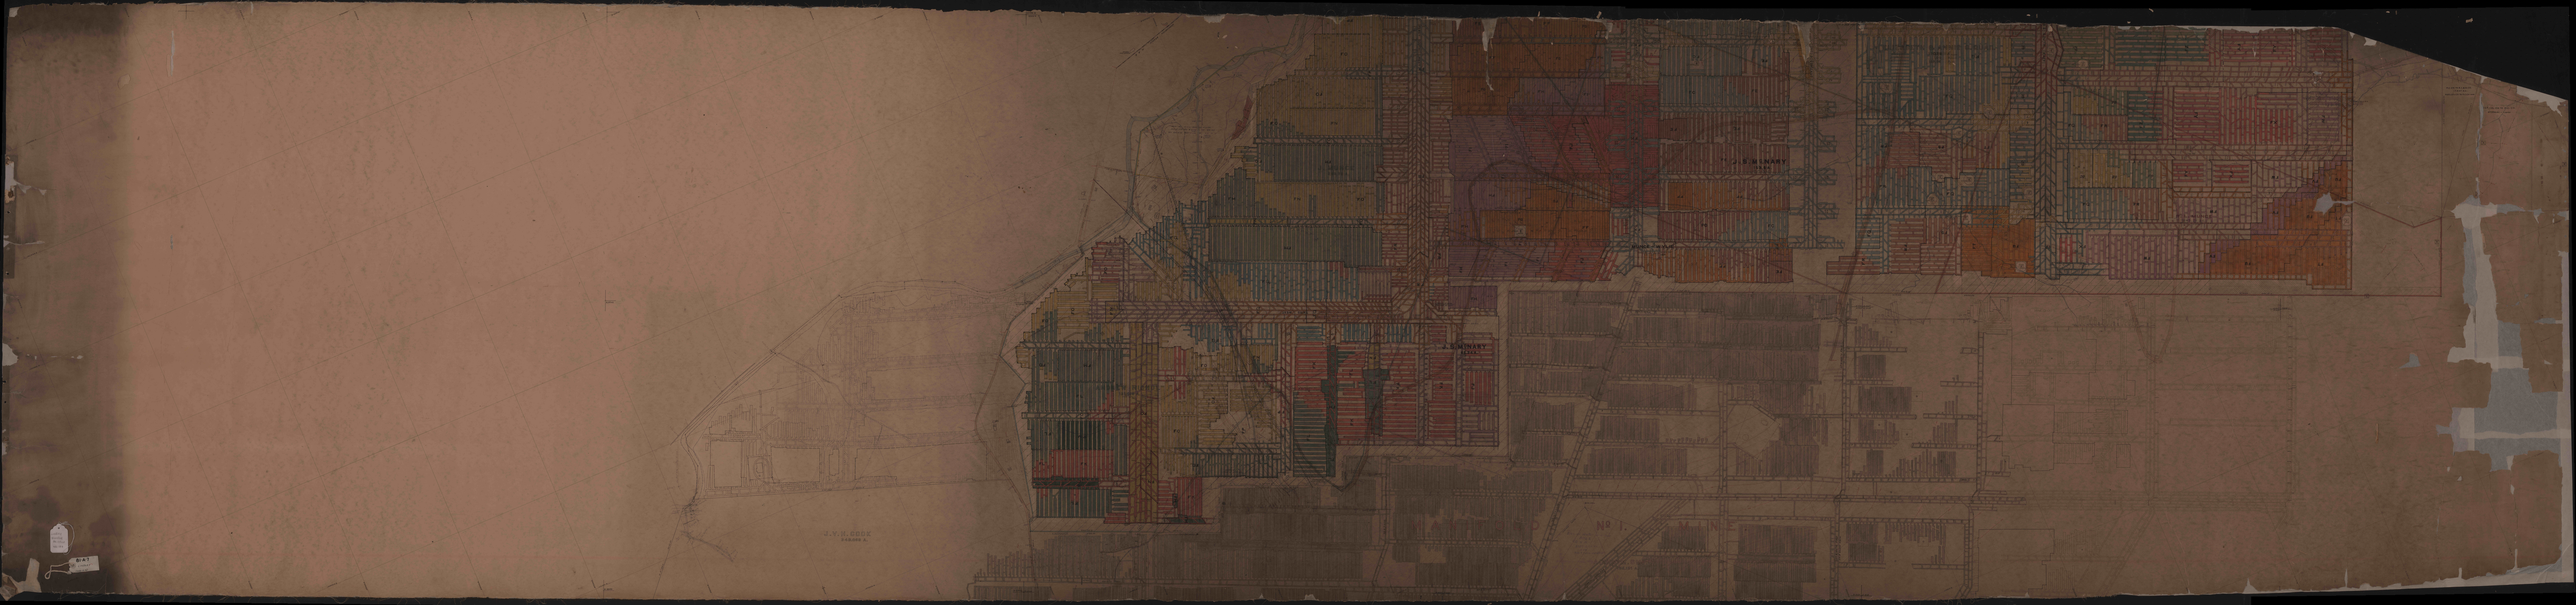
J. V. H. COOK
J. V. H. CHAVY
J. V. H. CHAVY
No. 1