


60
59

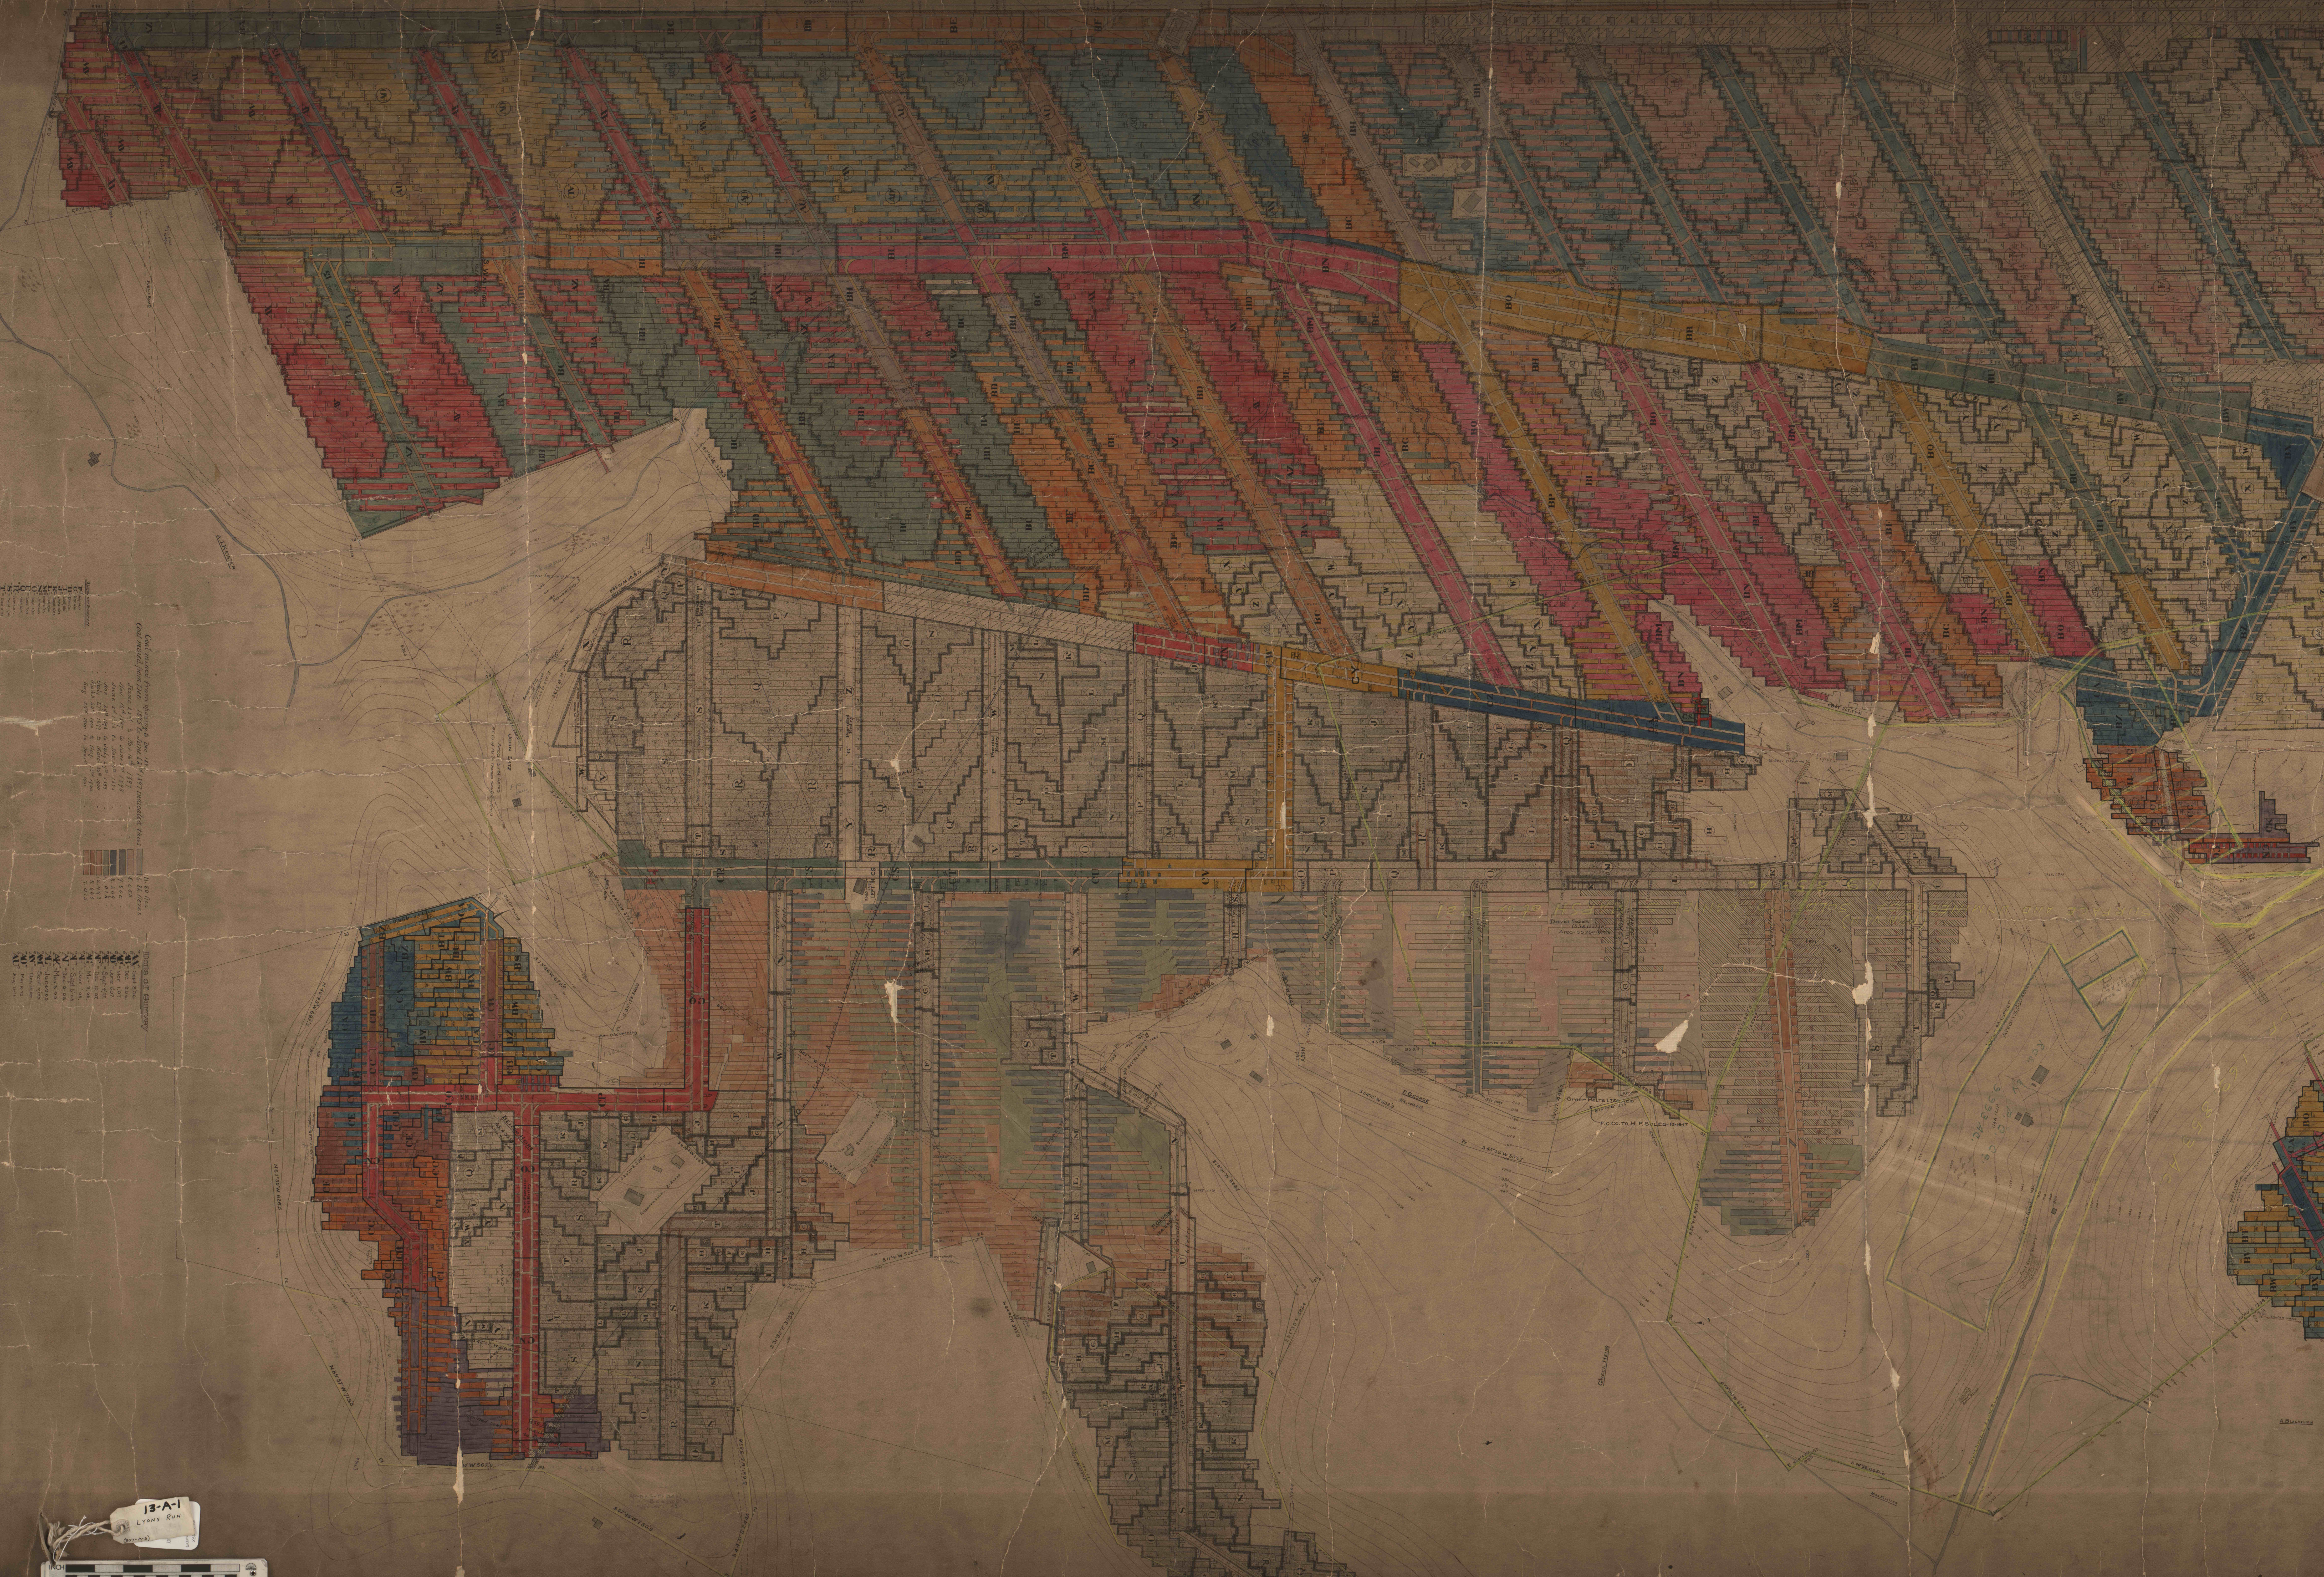

83-81

Cont. from page 58
 Cont. from page 59
13-A-1
 Lyon's Run

60
59