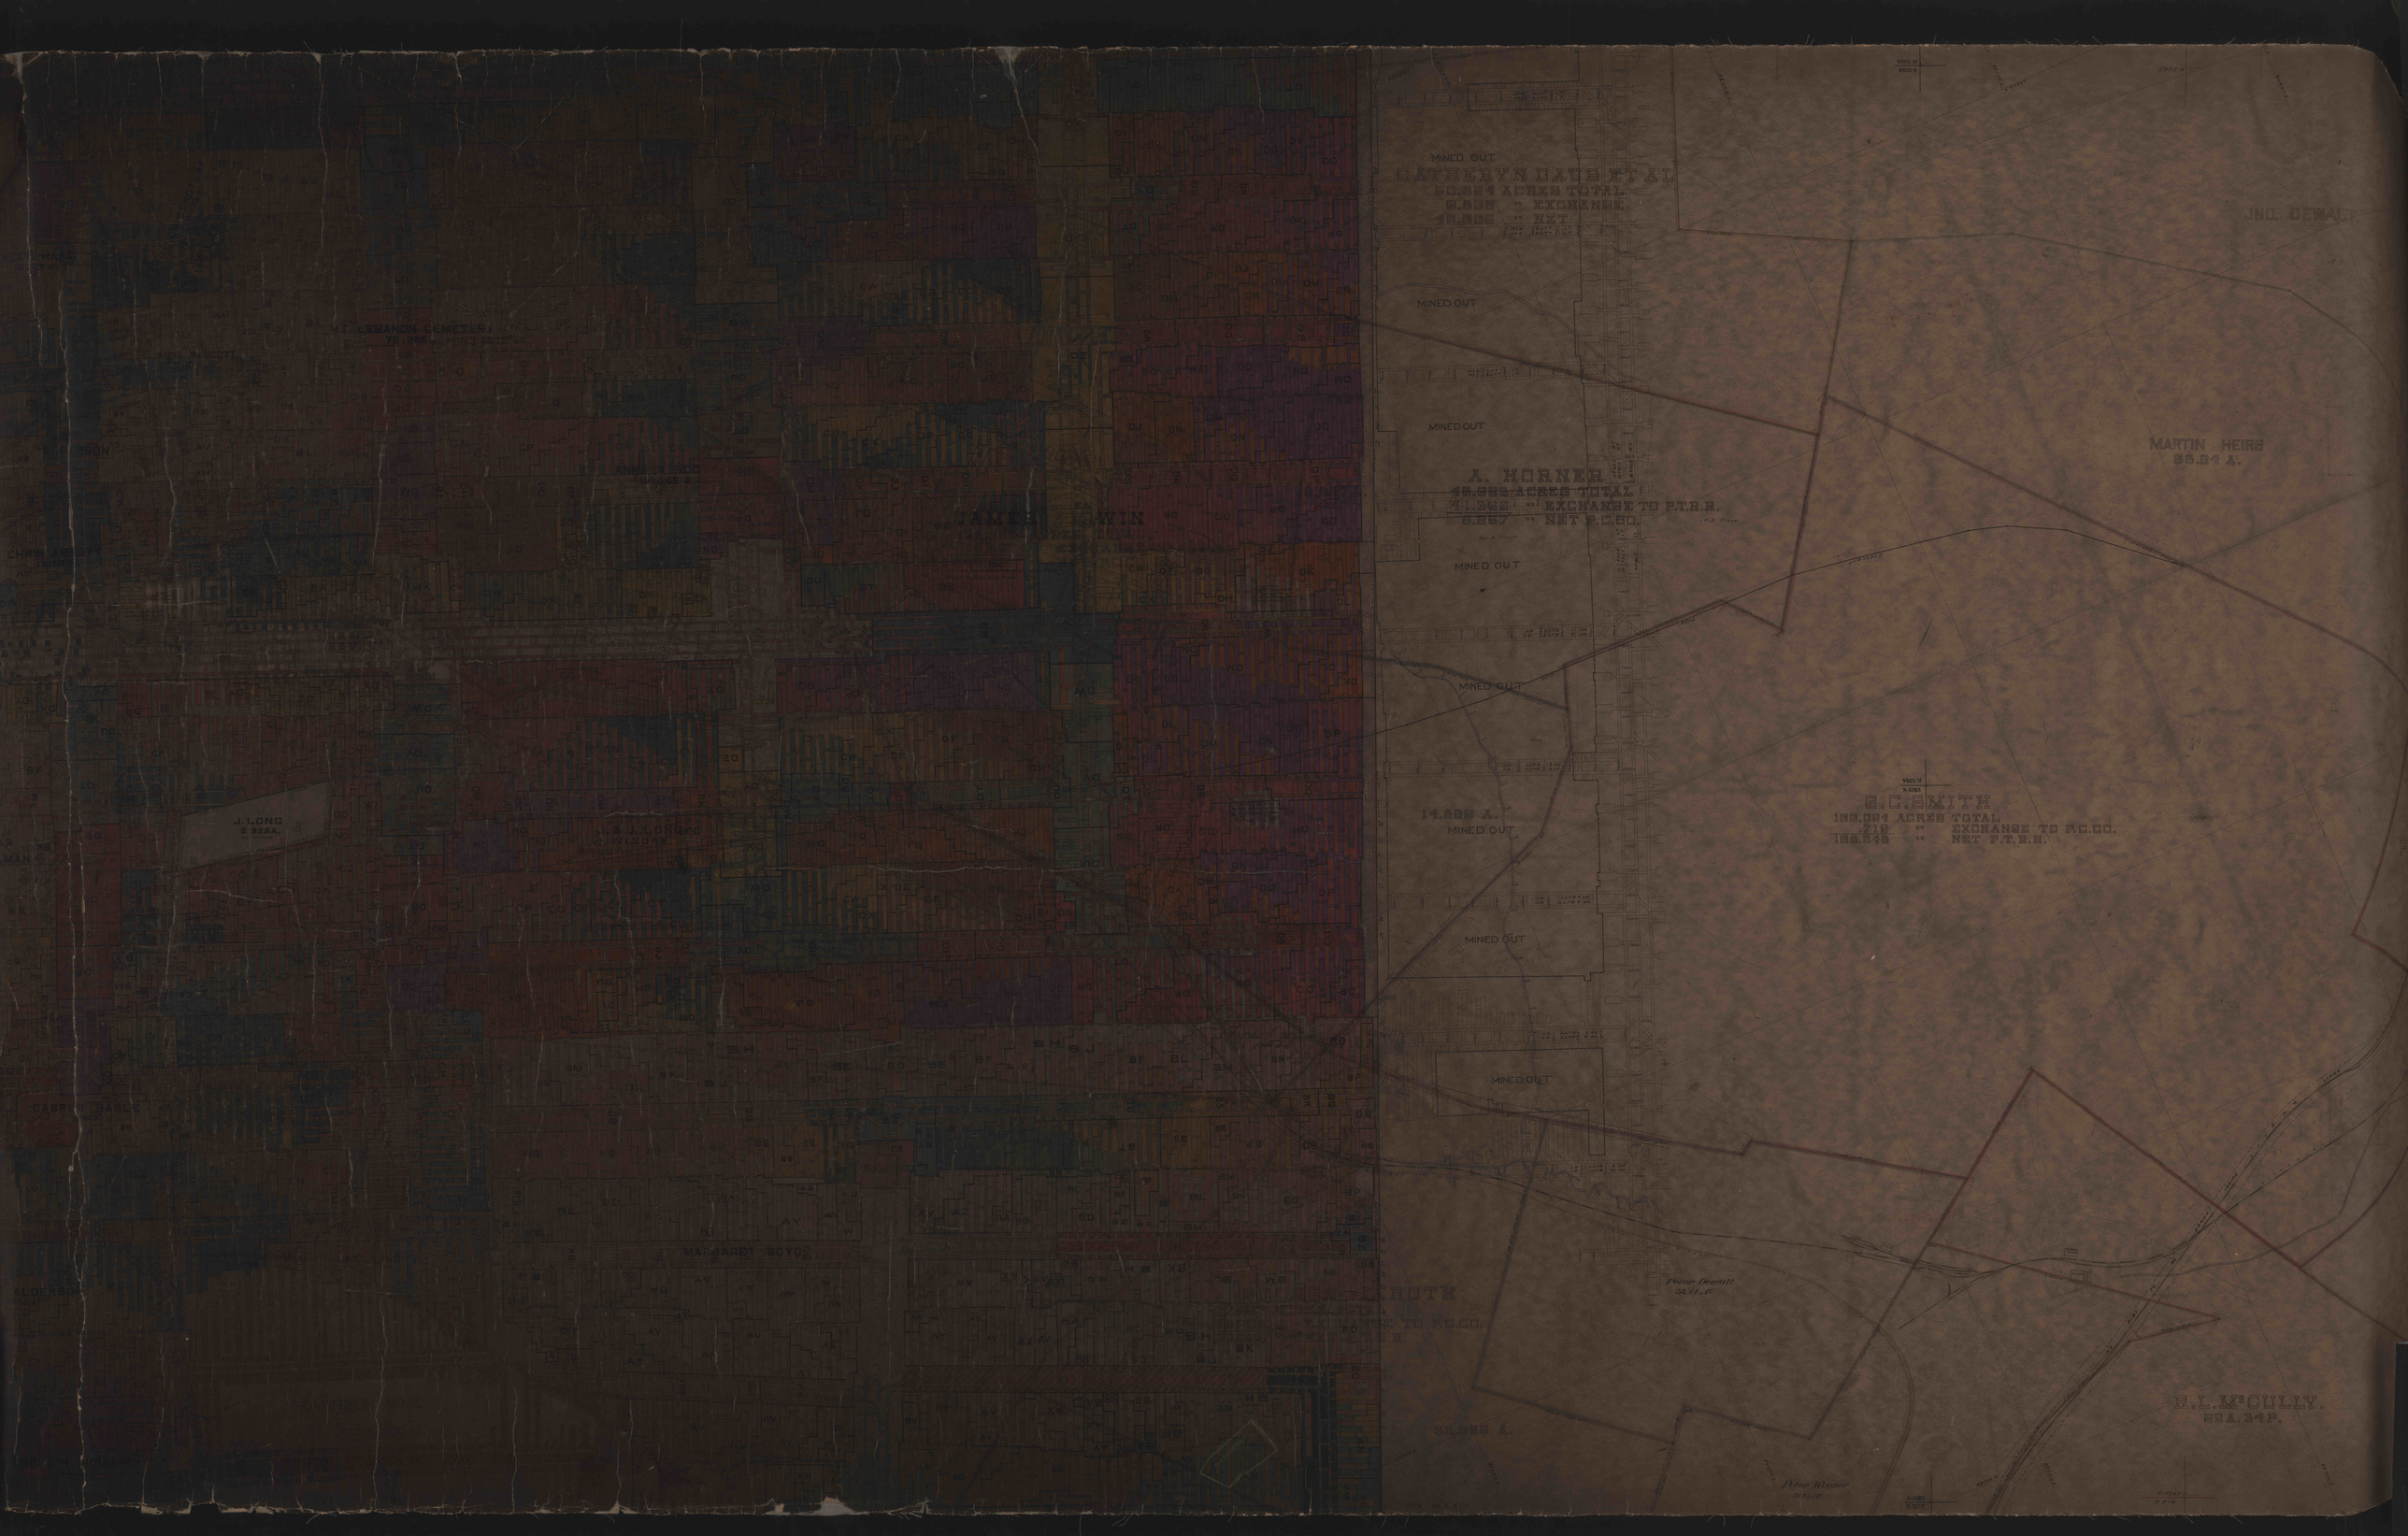
MINED OUT
CATHERYN HAUG ET AL
80.884 ACRES TOTAL
81.000 " EXCHANGE
10.000 " NET
P.T.R.R.
JNO. DEWALT
MINED OUT
MINED OUT
A. HORNER
18.883 ACRES TOTAL
8.000 " EXCHANGE TO P.T.R.R.
8.267 " NET P.C.CO.
MARTIN HEIRS
95.84 A.
MINED OUT
MINED OUT
14.000 A.
MINED OUT
B.B.SMITH
180.084 ACRES TOTAL
21.0 " EXCHANGE TO RC.CO.
159.538 " NET P.T.R.R.
MINED OUT
MINED OUT
H.L. McCULLY
89 A. 34 P.
J. LONG
2 9254
MT. LEBANON CEMETERY
MARGARET BOYD