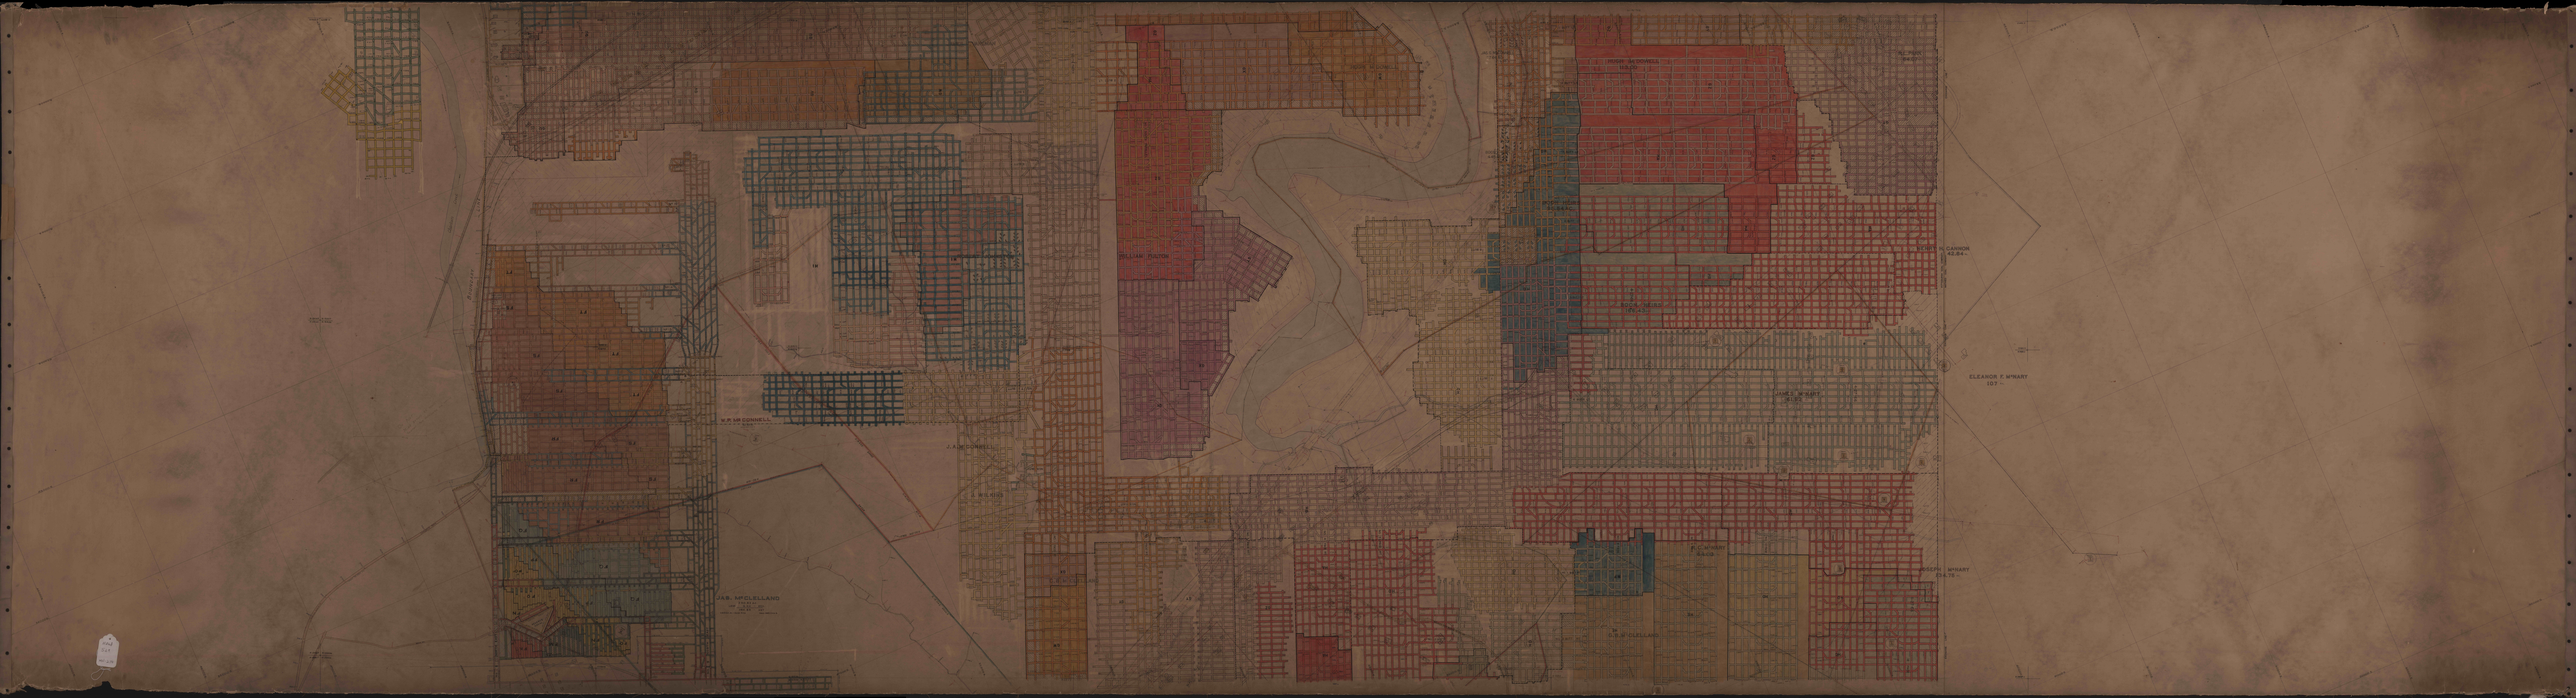

HUGH McDOWELL
HUGH McDOWELL
BOGIE HEAD
BOGIE HEAD
WILLIAM FULTON
ROBERT H. CANNON
42.64
ELEANOR F. McNARY
107
JAMES McNARY
W.P. McCONNELL
J.A.McCONNELL
J. WILKINS
JAS. McCLELLAND
JOSEPH McNARY
134.75