


60  
50 59

no 88 86 84 82 80  
|||  
8 8 85 83 81 79

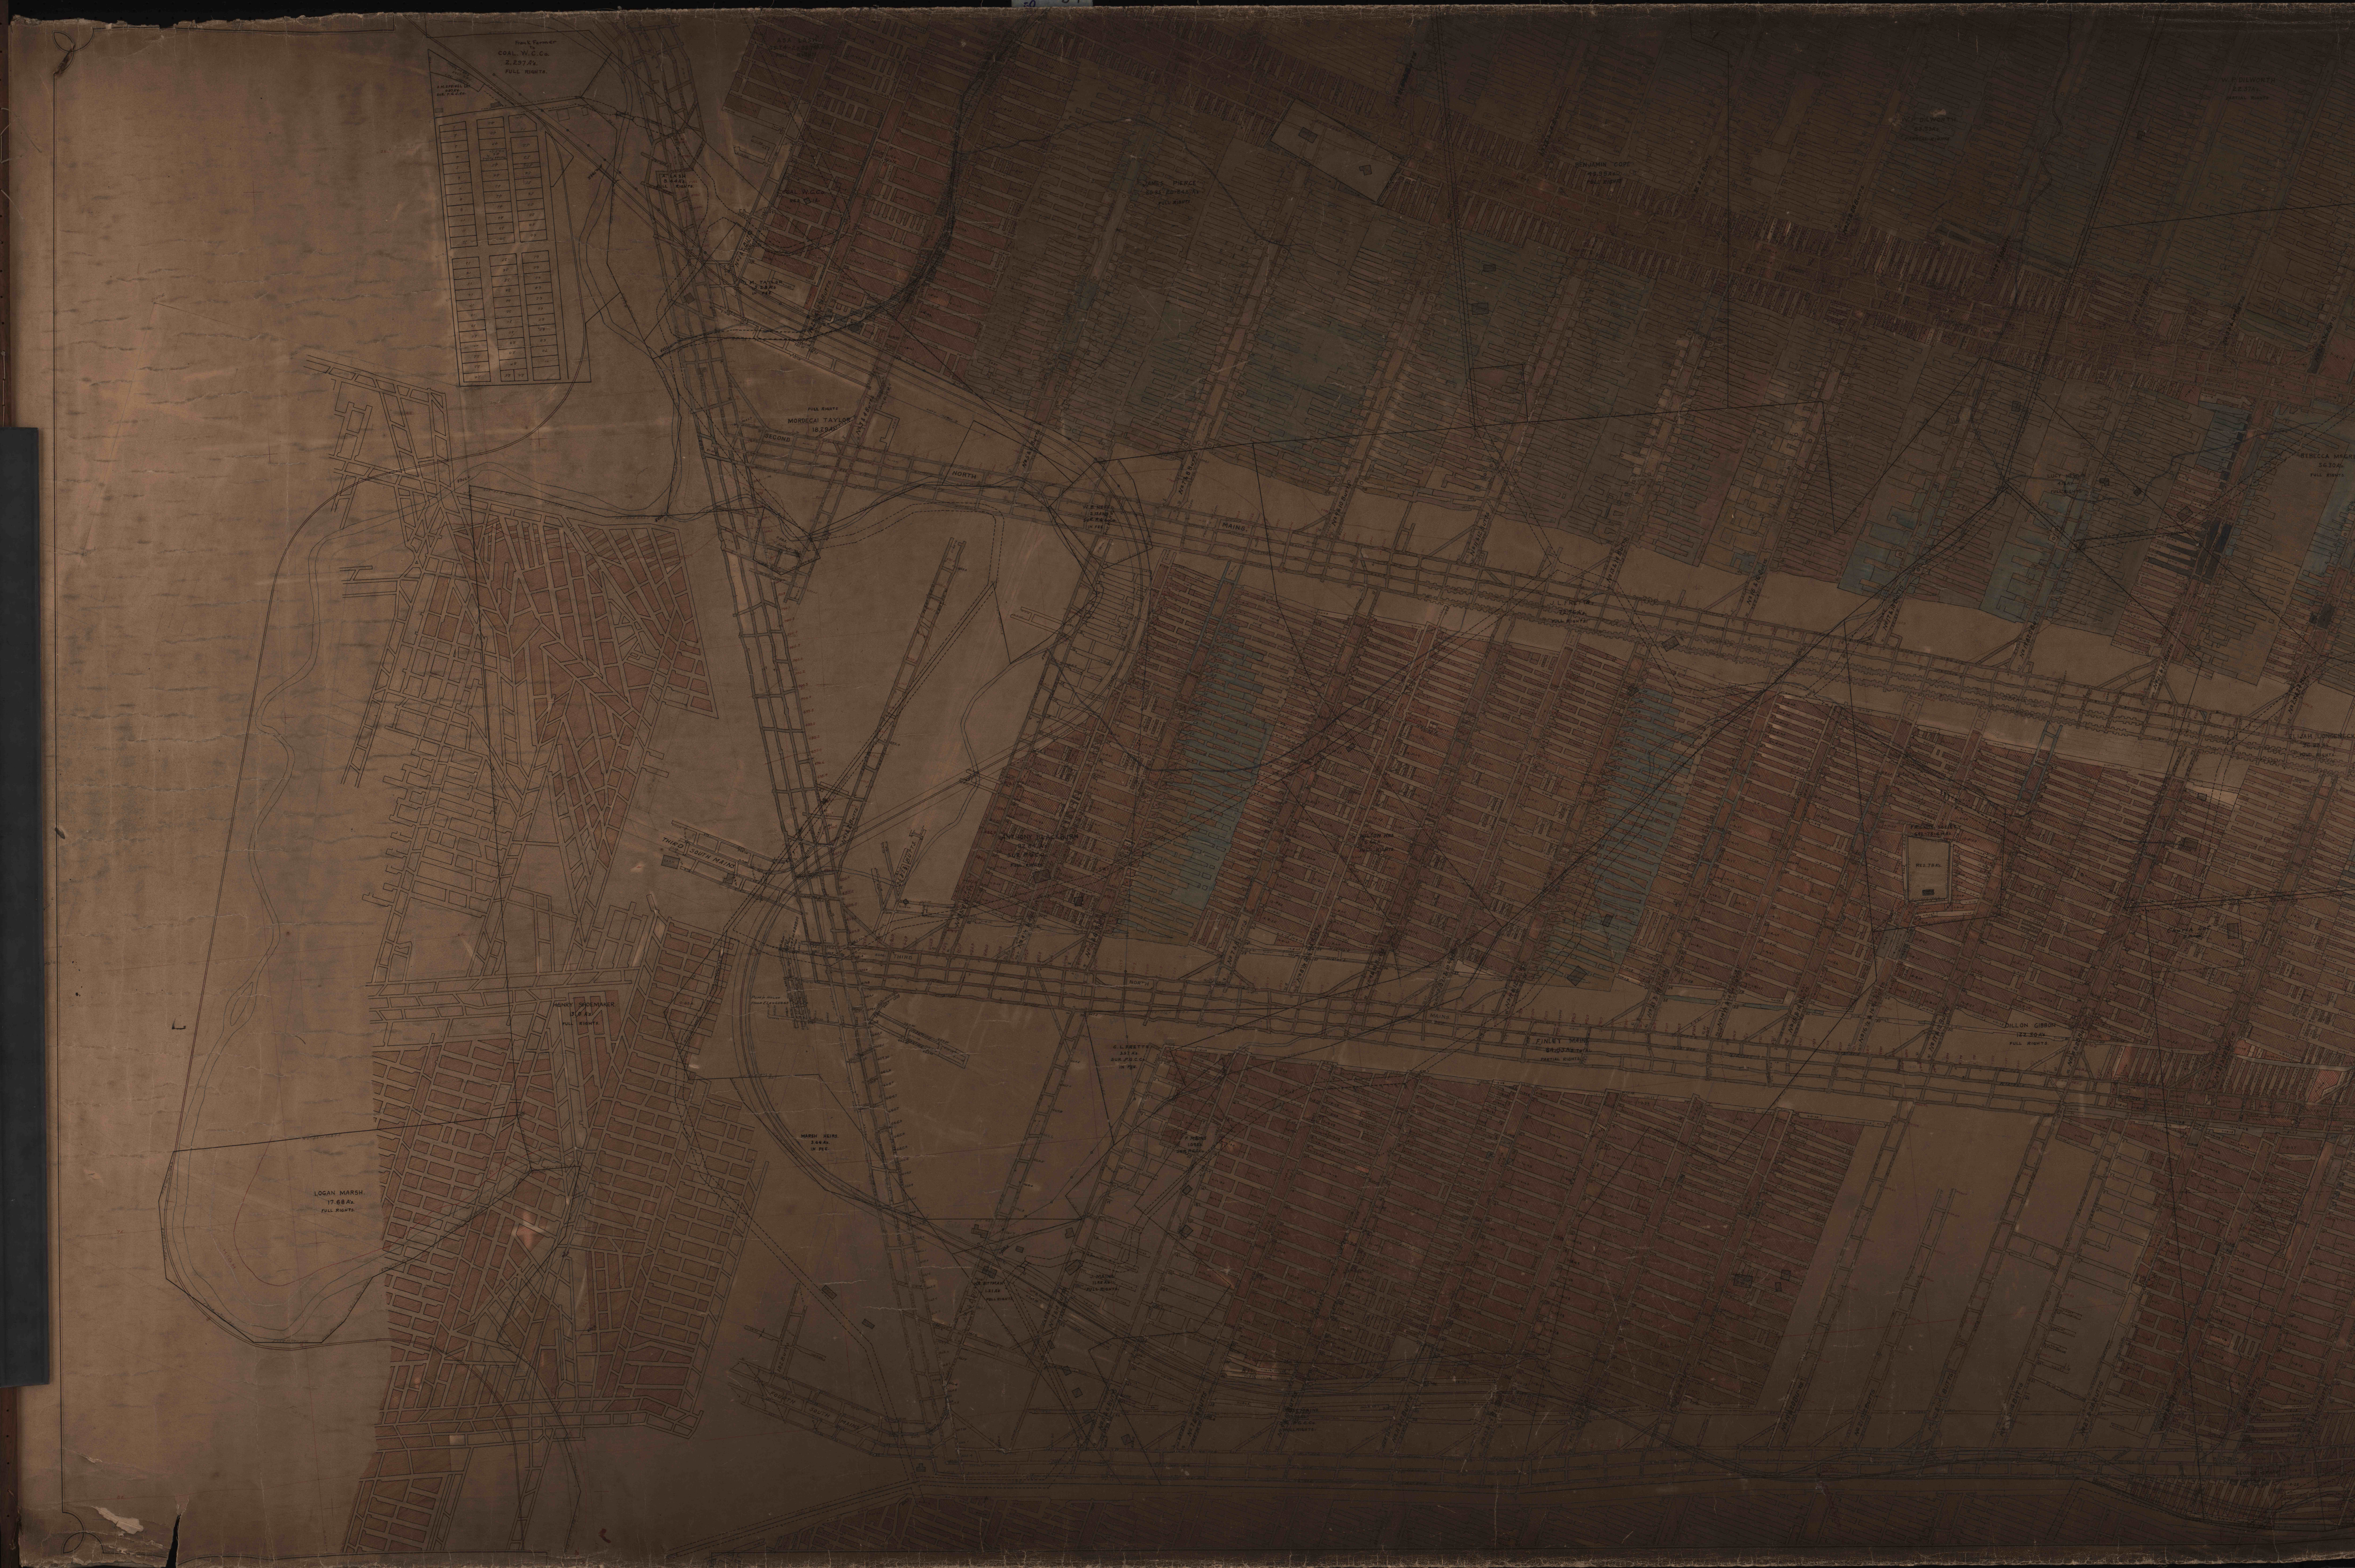

Block 1000  
EVAL. W.C. Co.  
1877 A.  
FULL NORTH

MORDECAI TAYLOR  
1852 A.  
SECOND

LOGAN MARSH  
17 88 A.  
FULL NORTH


