


PLAN  
OF  
ATLANTIC MINE  
OF  
LAKE ERIE COAL & COKE CO.

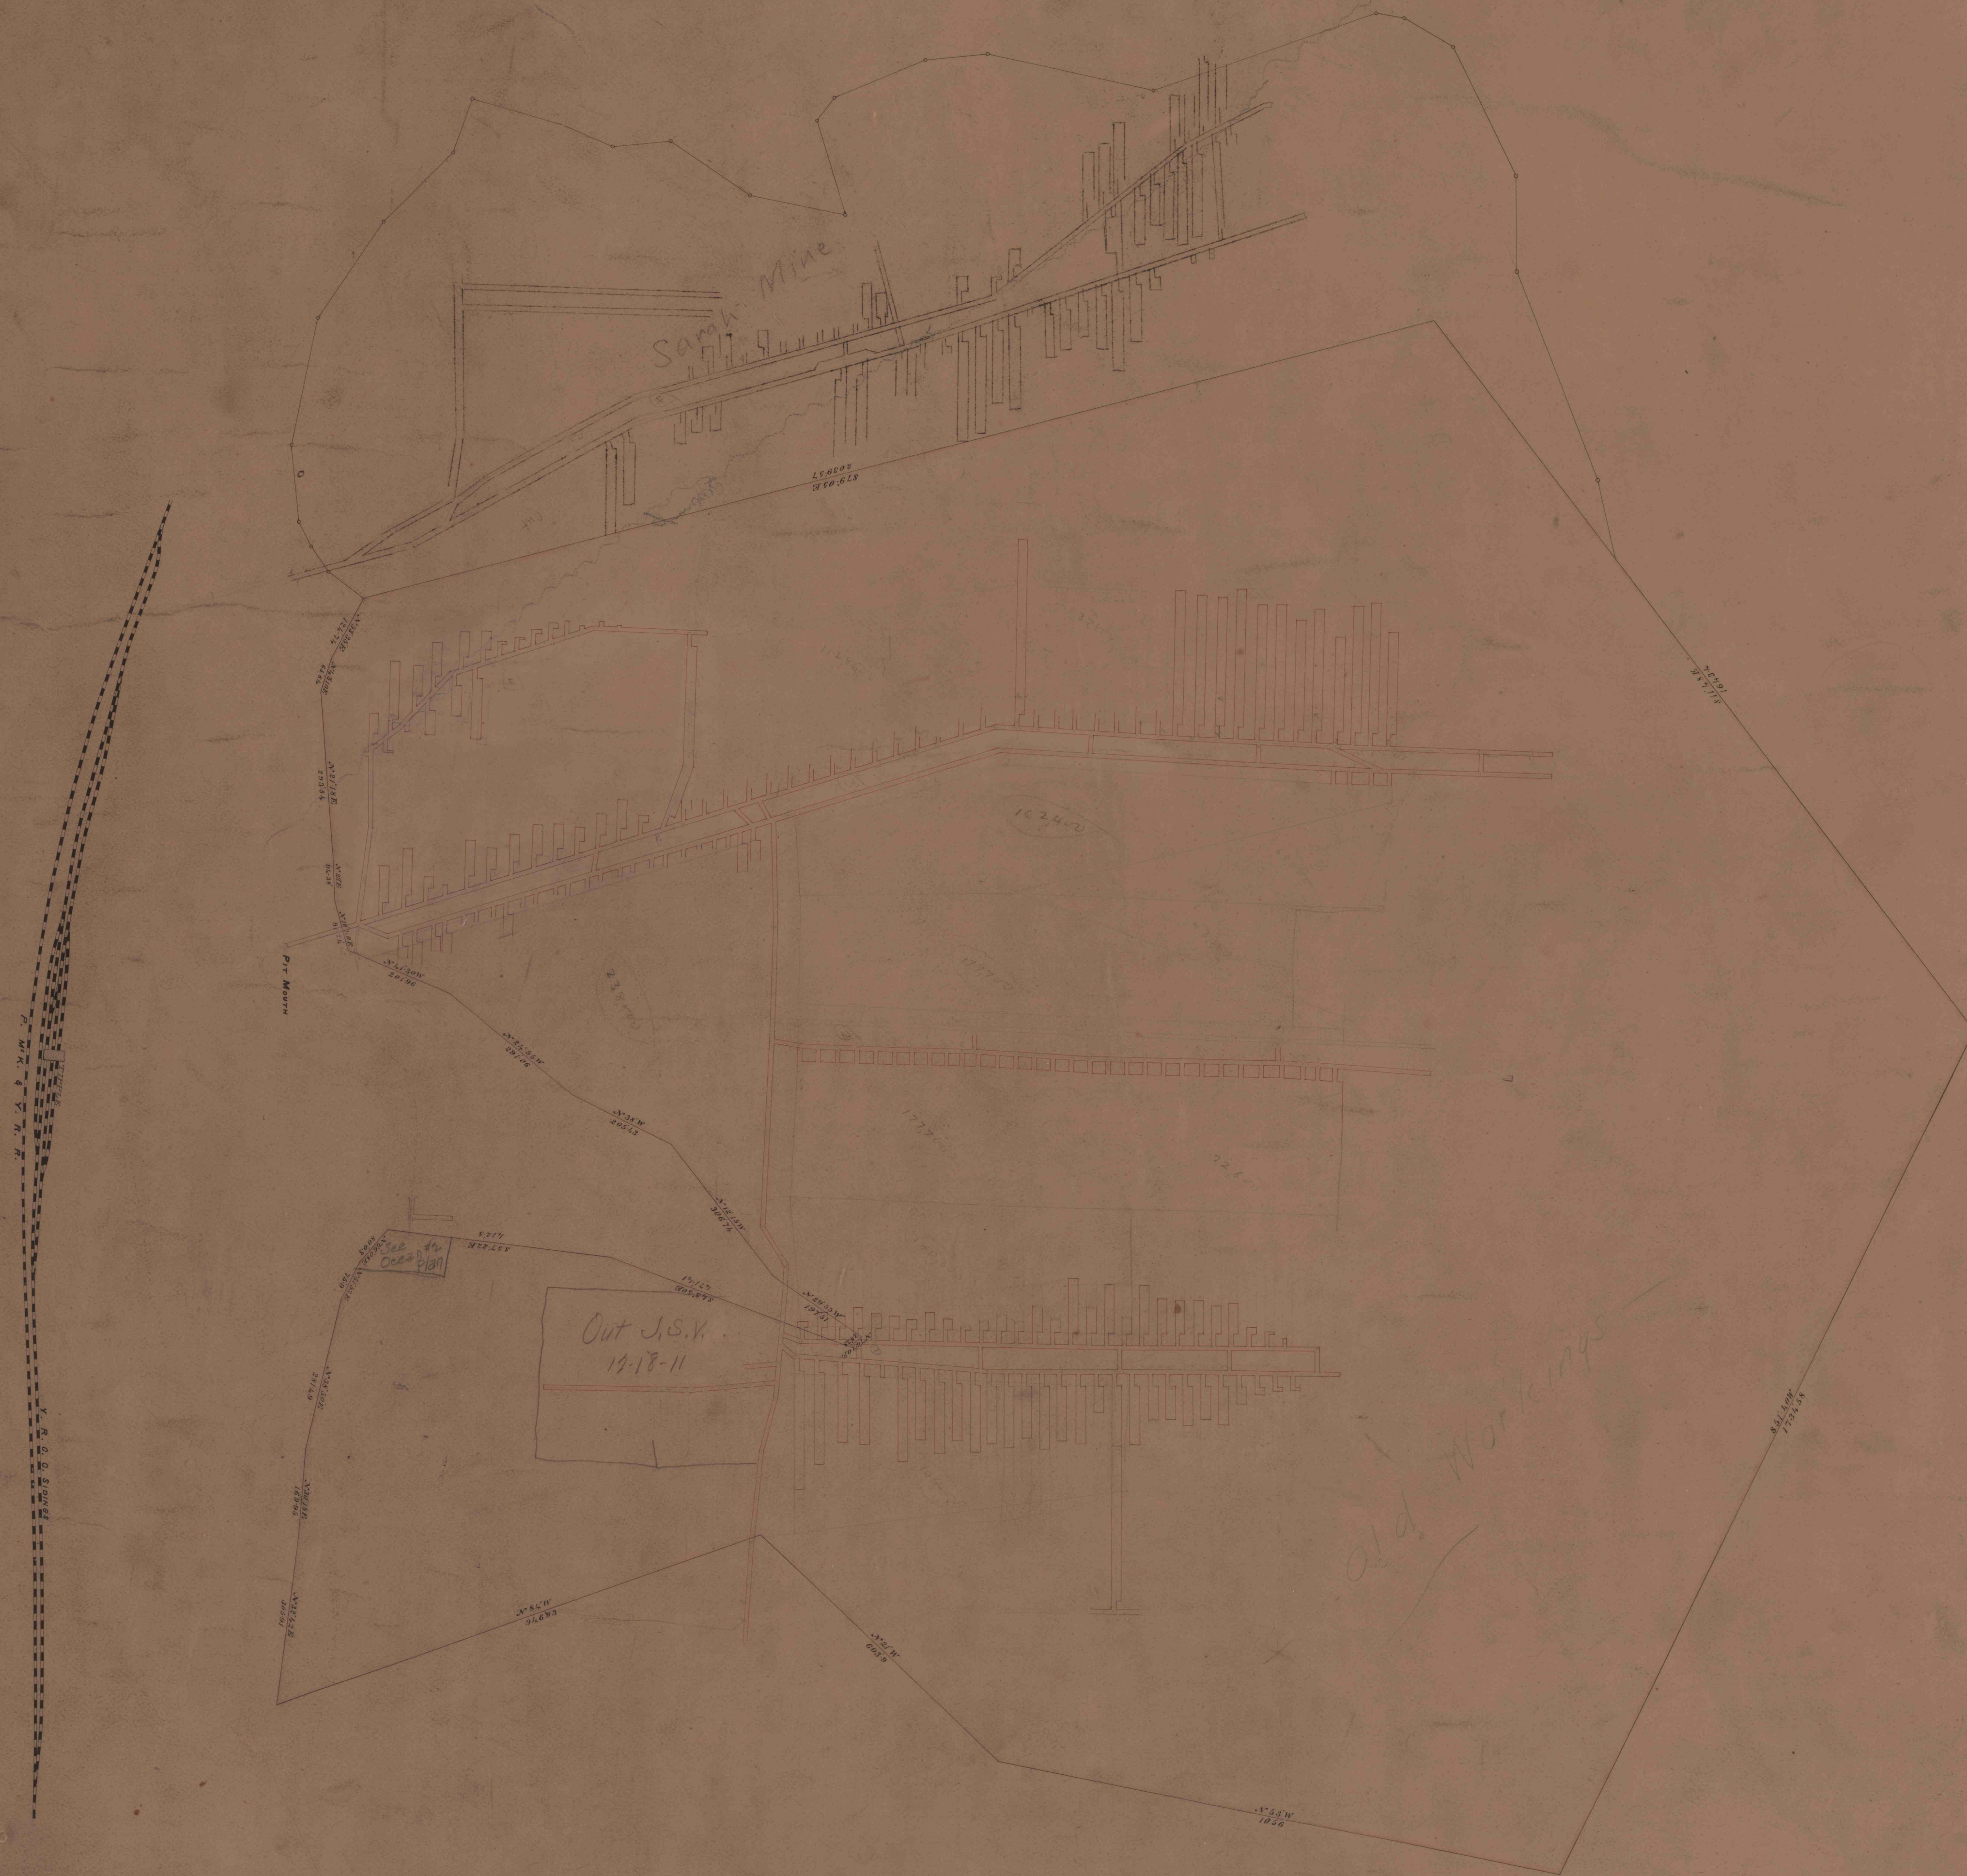

Atlantic  
Mine  
Side 2

BANNING  
17-0-3