


60  
58

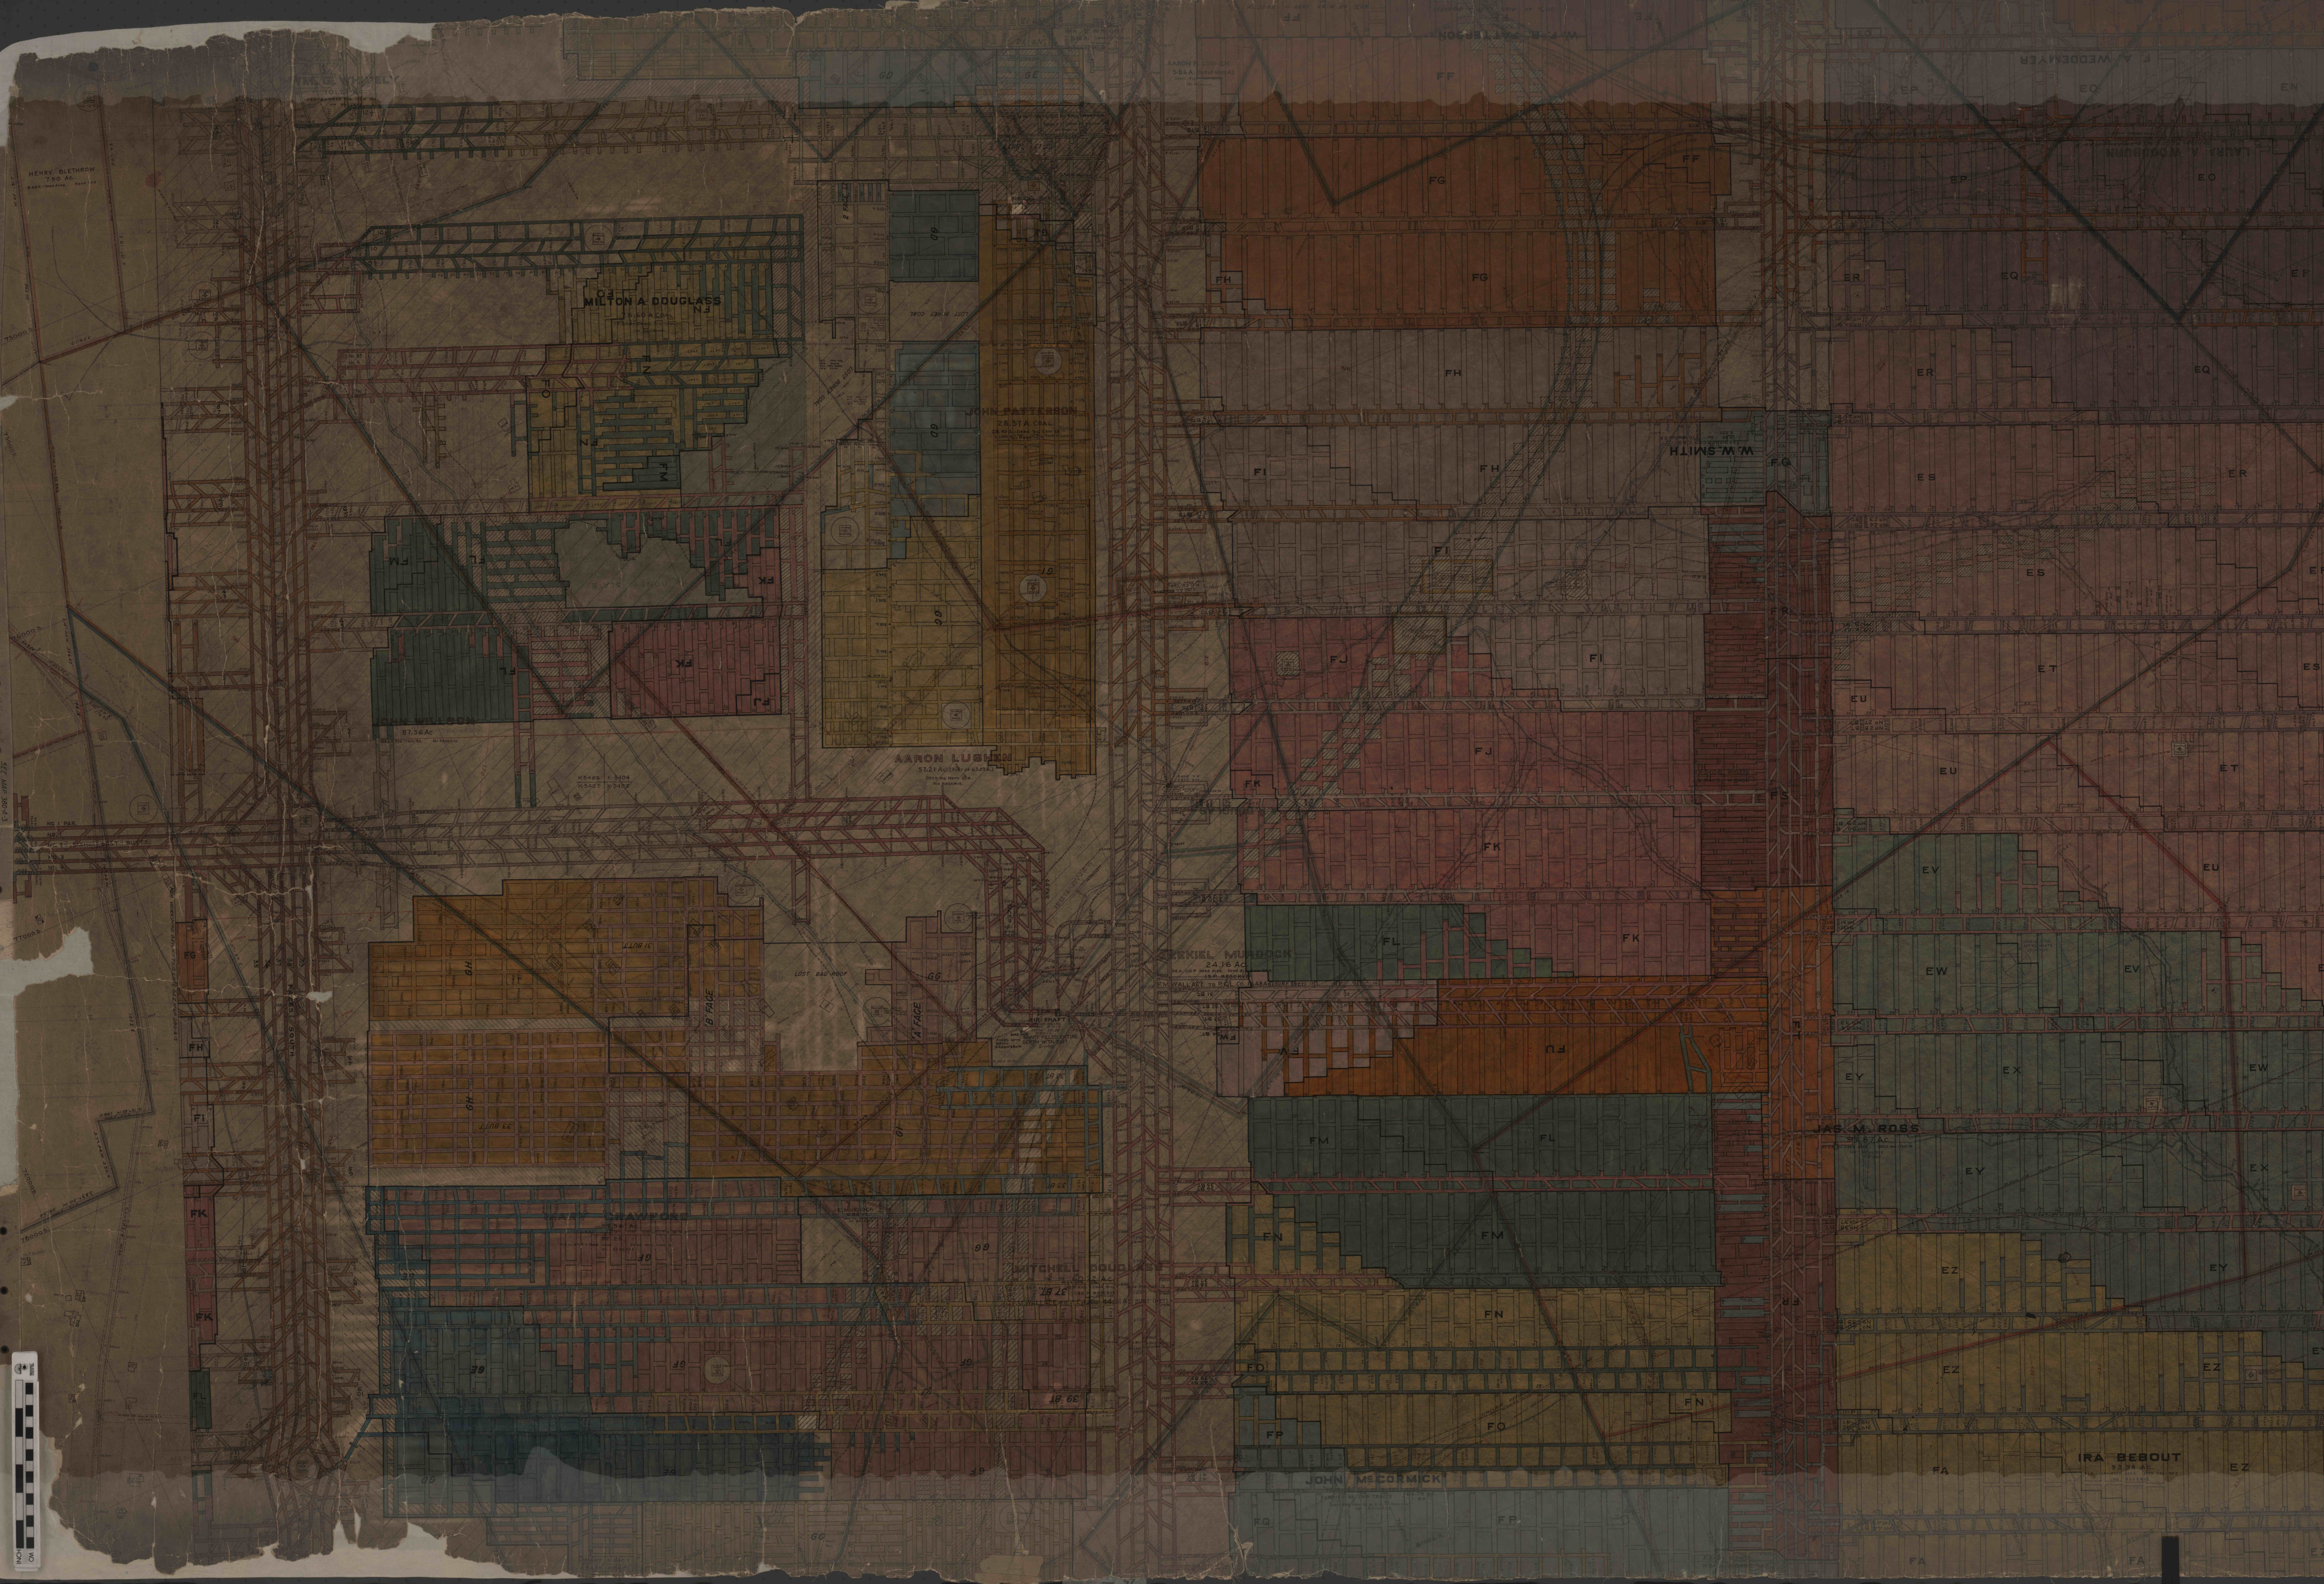

66 84 82  
111111  
85 83 81

50  
59  
60