


54  
53  
52  
51

FIT TO MAP 378 A-4

80 81 82 83 84  
85 86 87 88 89

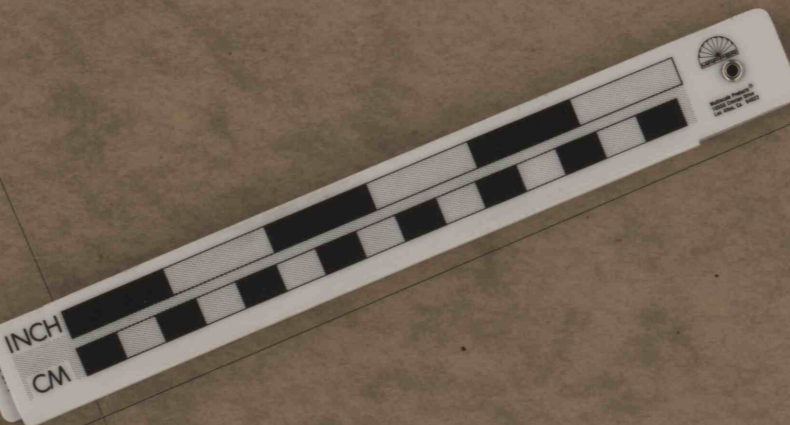

### COVERDALE OR NO. 8 MINE

P. T. C. CORP.

MINED OUT

MINED OUT

MINED OUT

D. B. & J. MCCLAIN  
1872

DOUGLASS  
4.24 AC.

JOHN B. DONALDSON  
4.14 AC.

ROBT. J. POTTER

SADIE E. MILLER

CATHERINE STOLZE  
102.87 A.

J. W. SKEELS  
6.9 A.

A. T. DEWALT  
118.3 C.

MARGARET COWAN

RACHEL L. BOYER

JOS. PHILIP

MONTOUR 10  
NORTH SIDE  
442

51  
52  
53  
54  
55