





BALTIMORE & OHIO  
PAVING ROAD

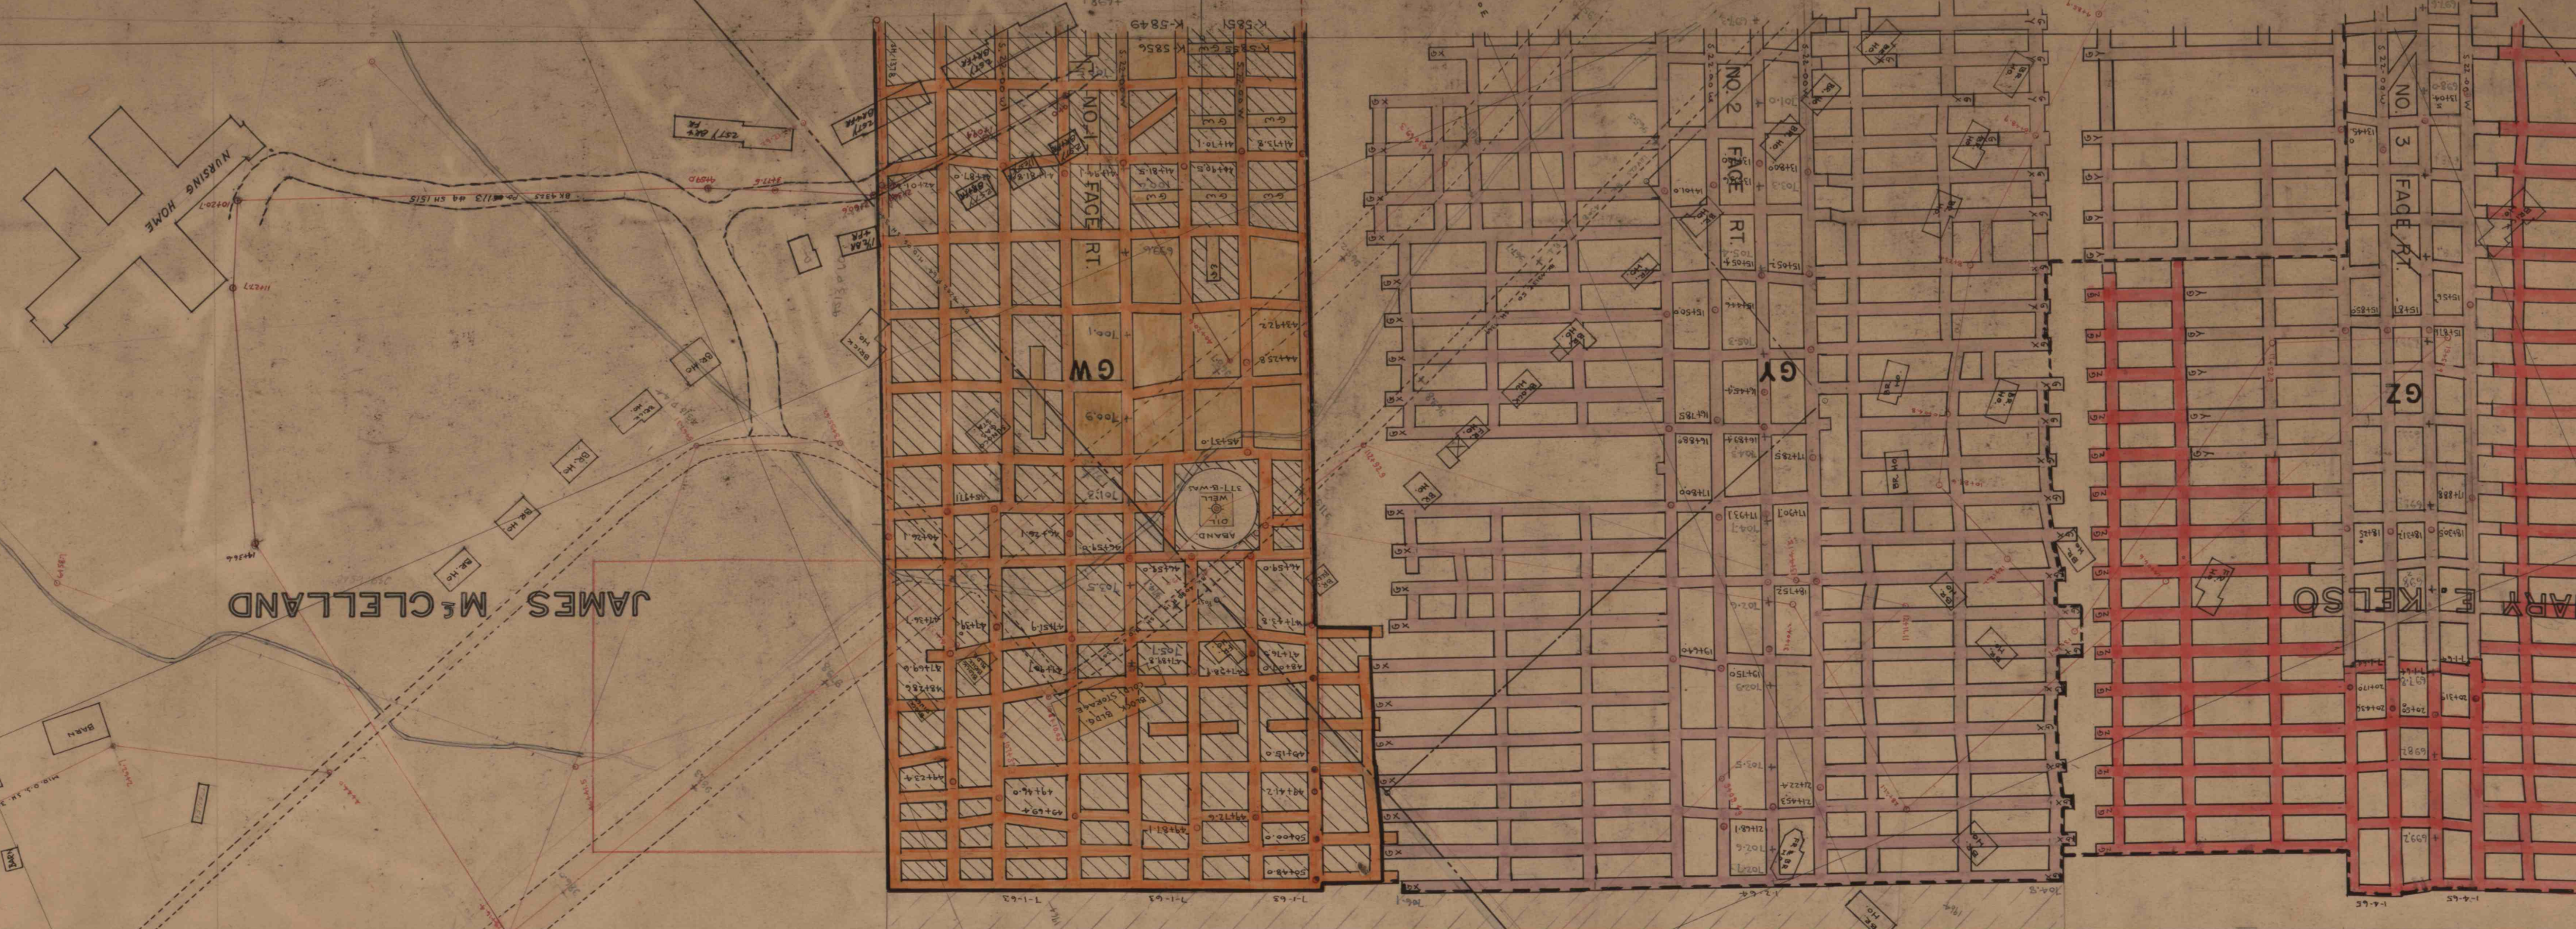

JAMES McCELLAND


388035

XSL 243

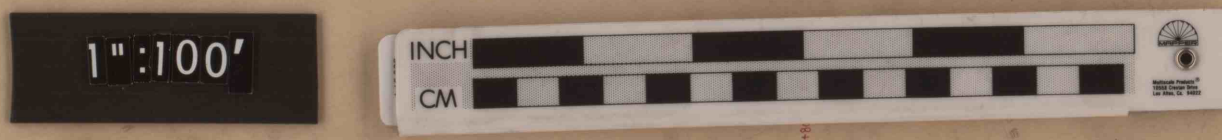

M A T H I E S C O A L C O M P A N Y

EXCHANGE LINE

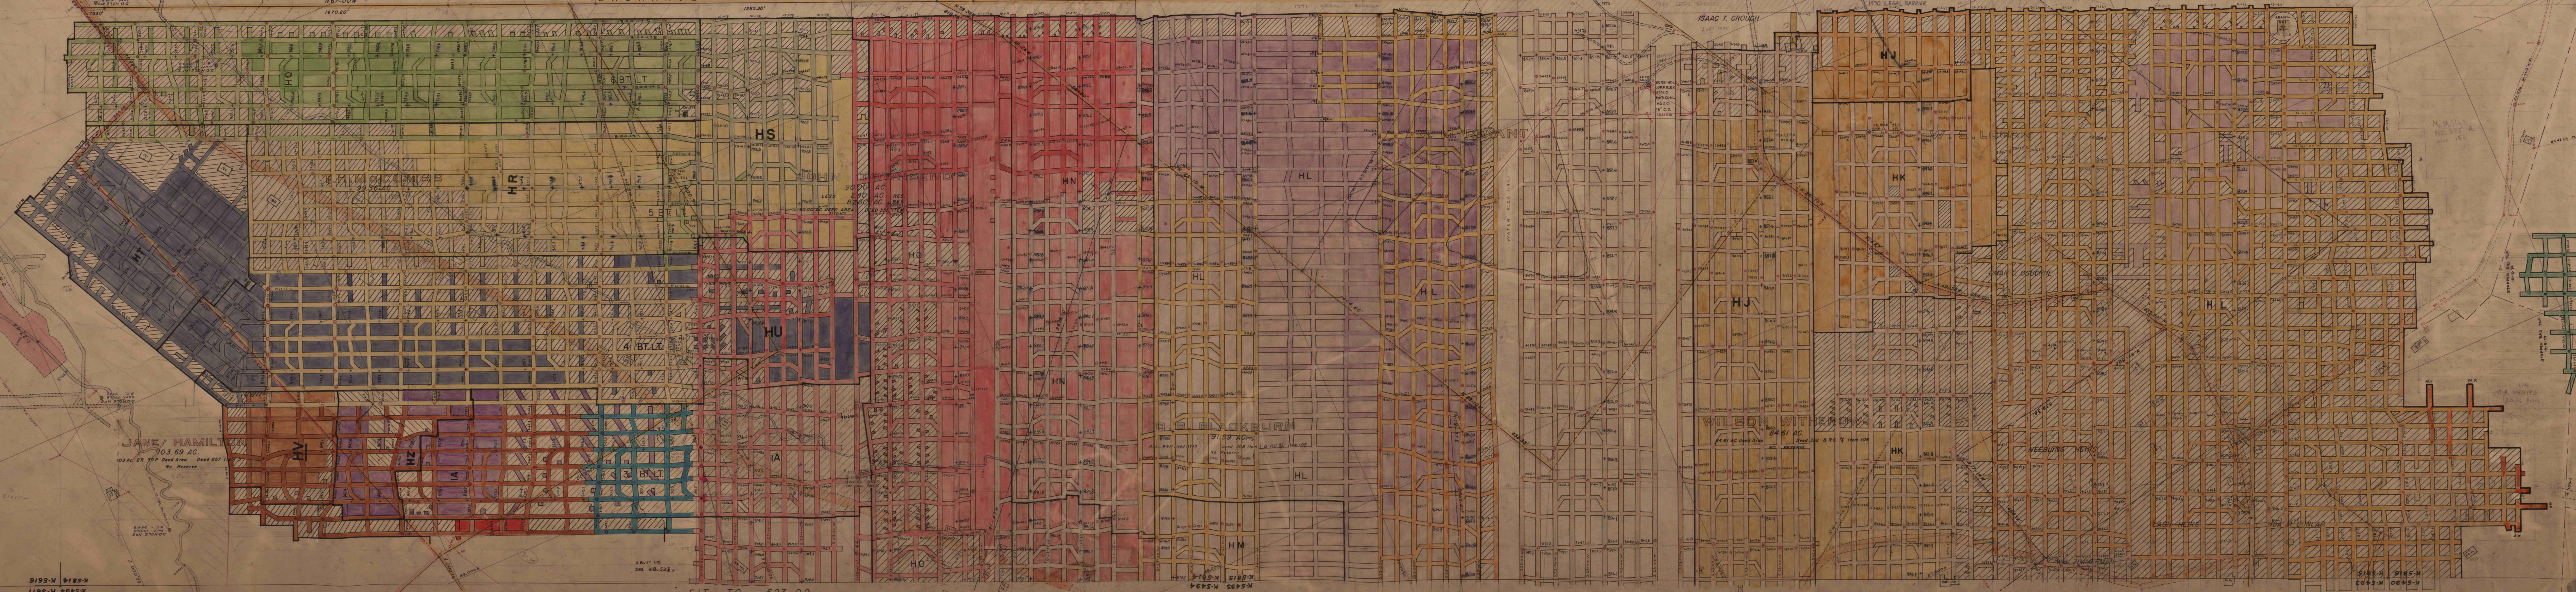

JANE HAMIL  
703.69 AC

FIT TO 523

FIT TO 523