



60
59

523

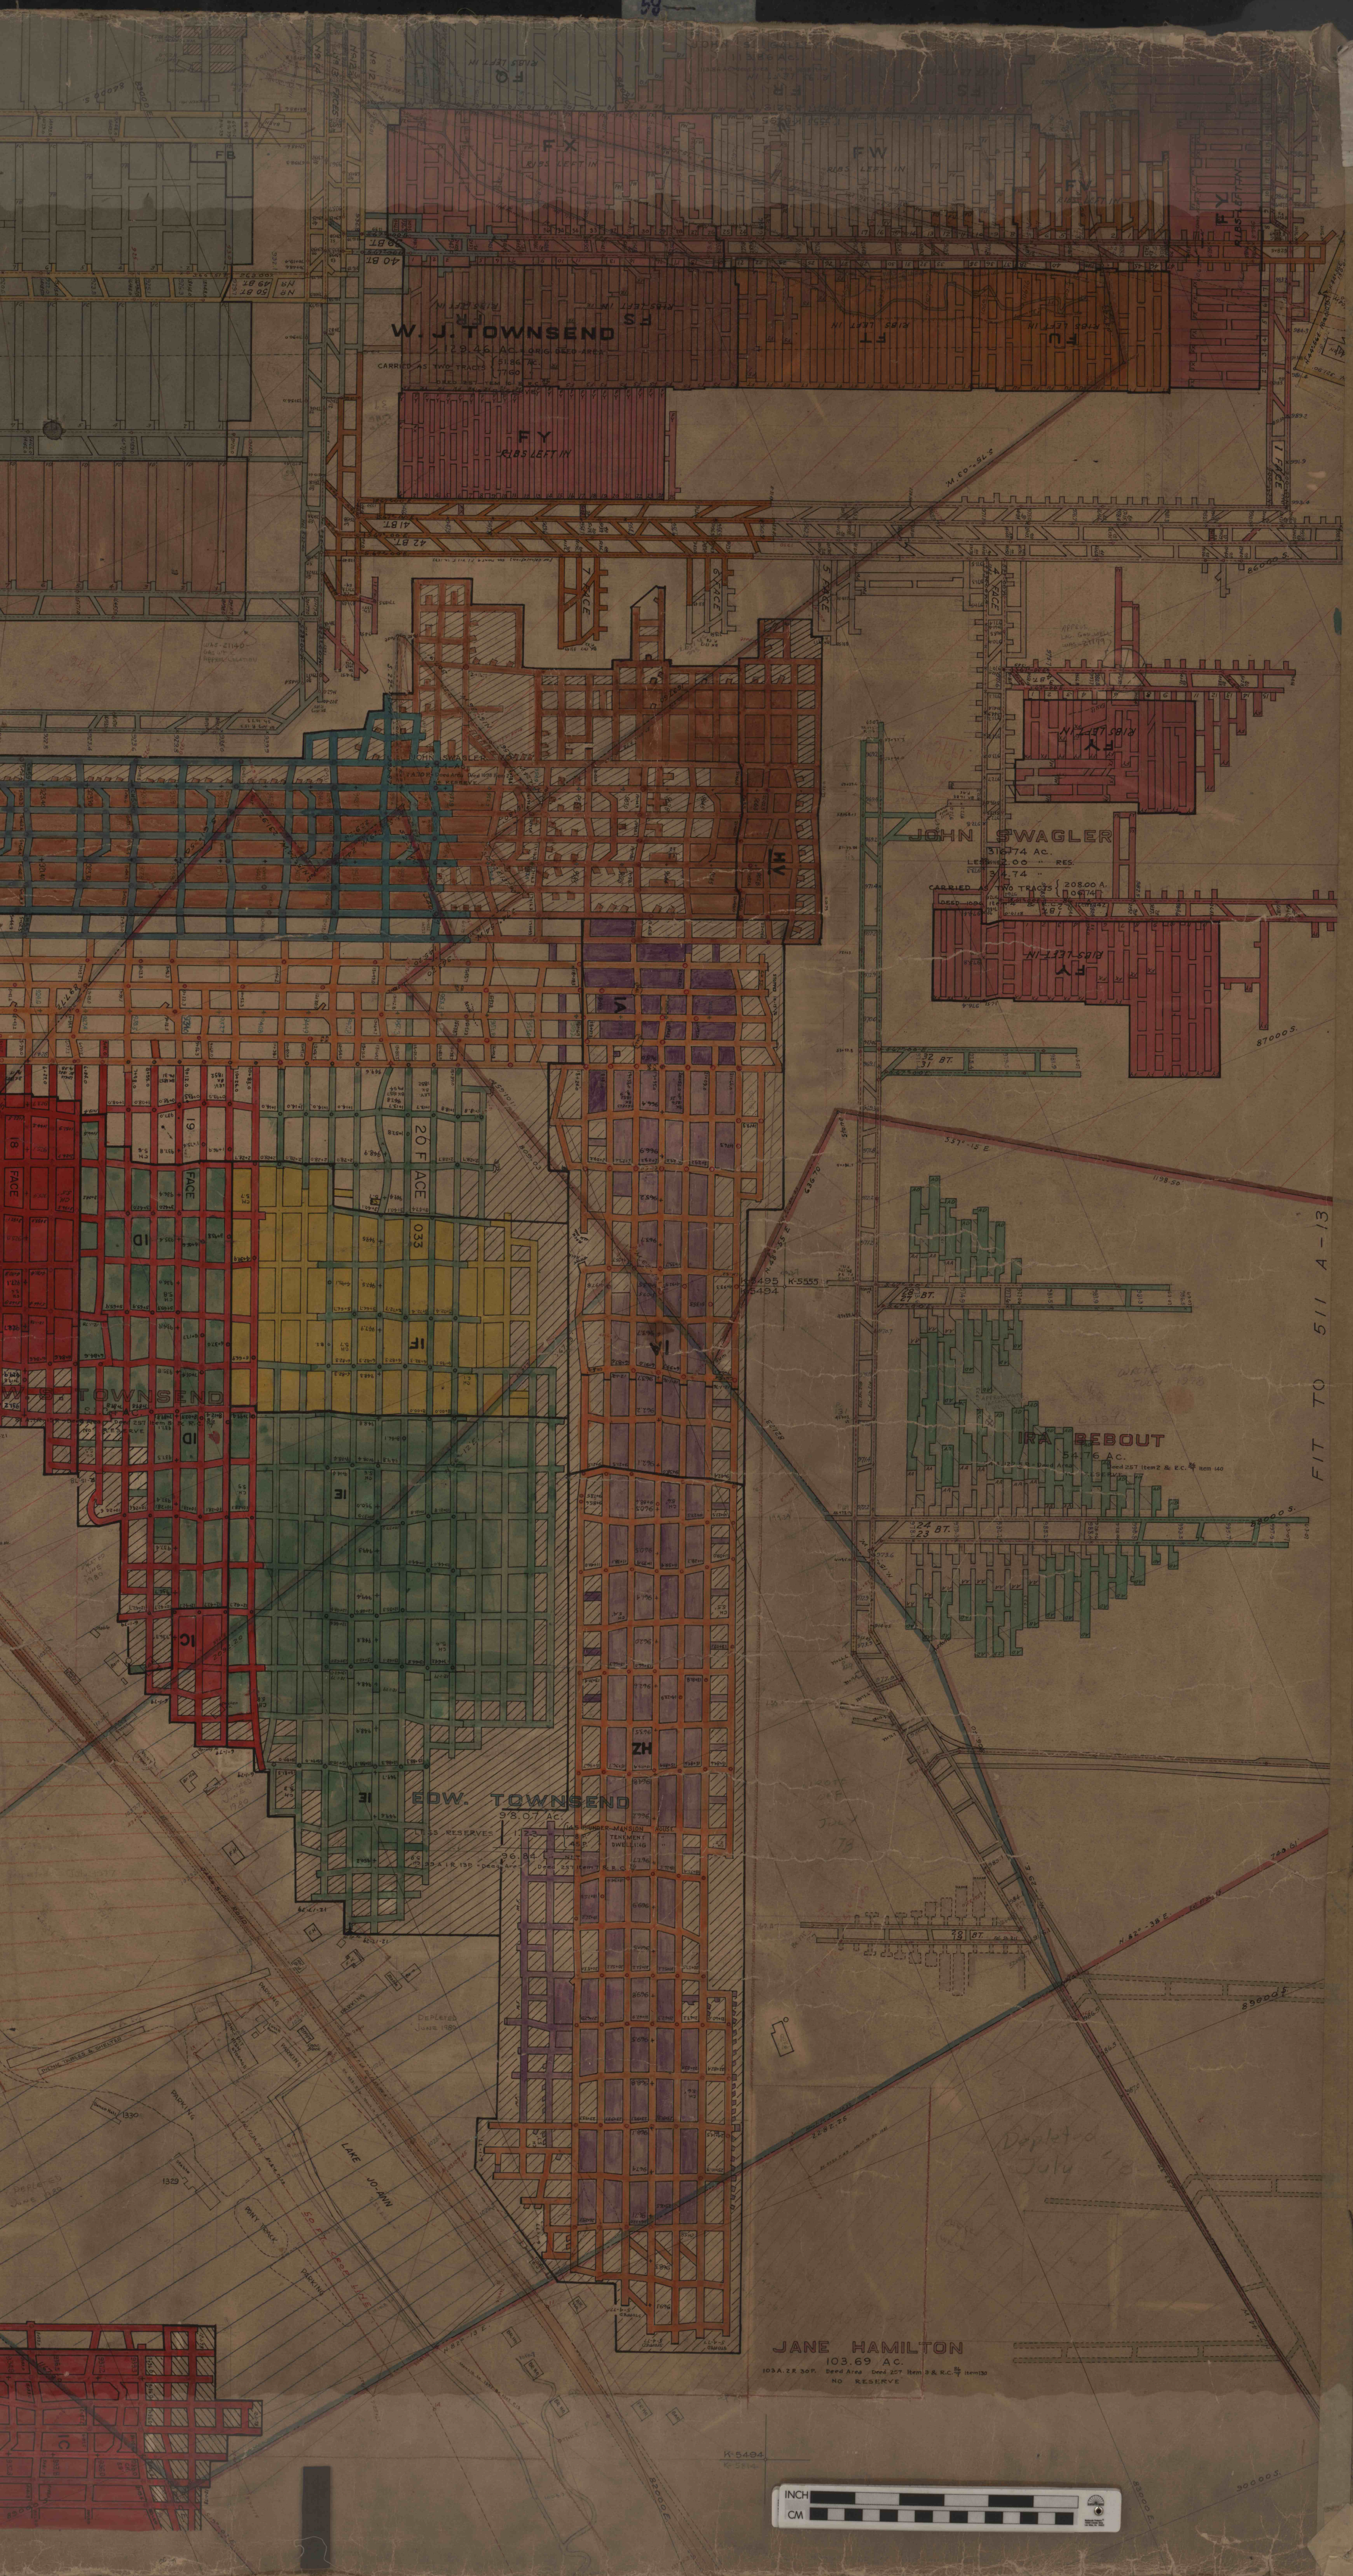

FIT TO 511 A-13

JANE HAMILTON
 103.69 AC.
 103A EX 20P. DEPT. AREA. DATE 207. HORN 2 & R.C. 104-1130
 NO. RESERVE

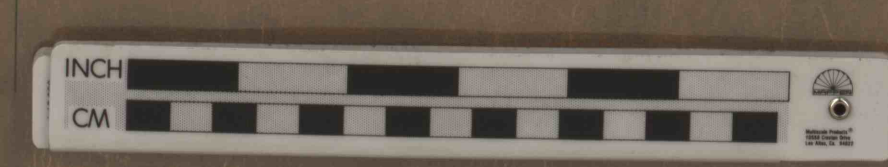

58
59
60