



60
59
57
56
55

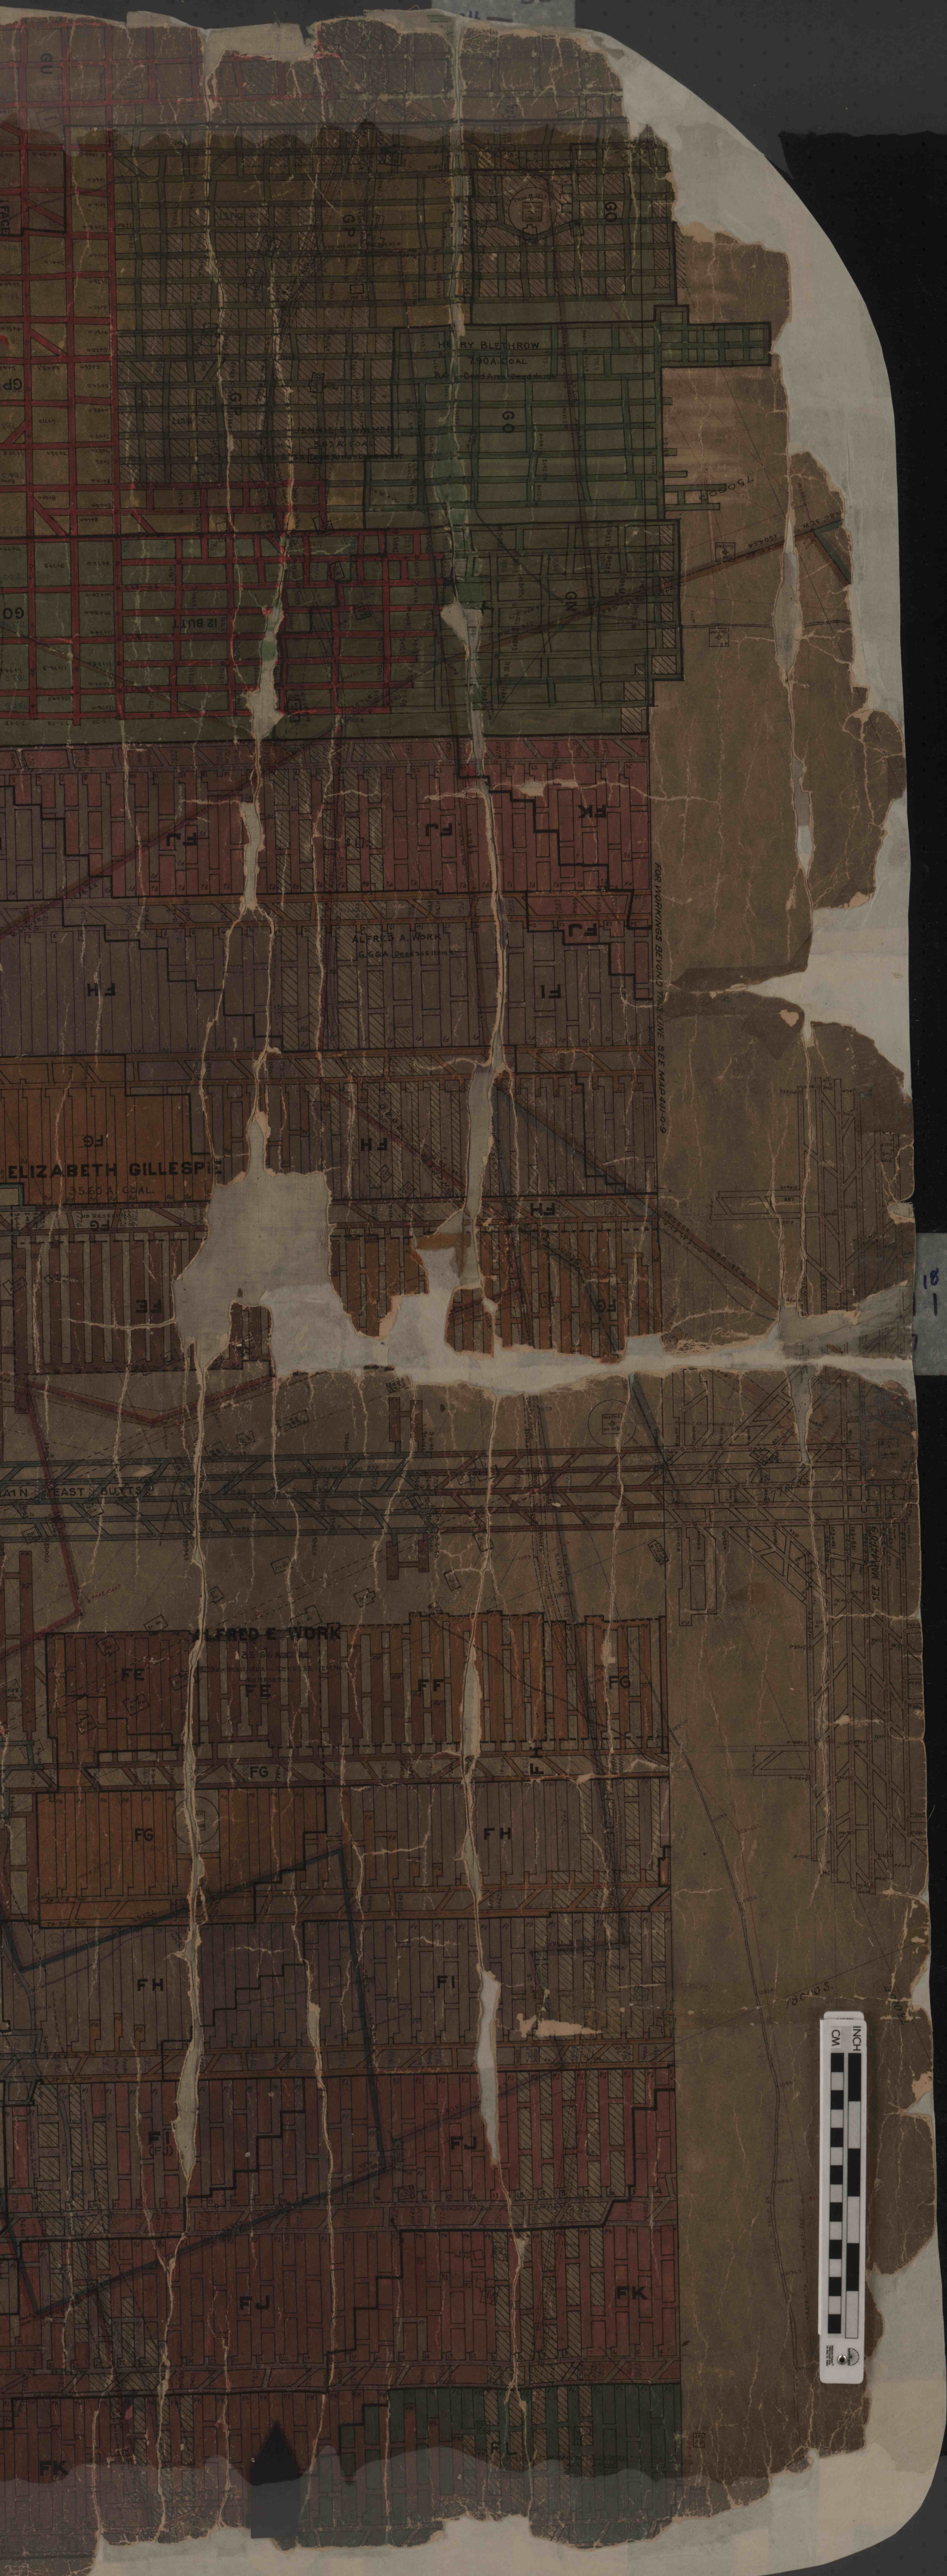

18
20
11
19

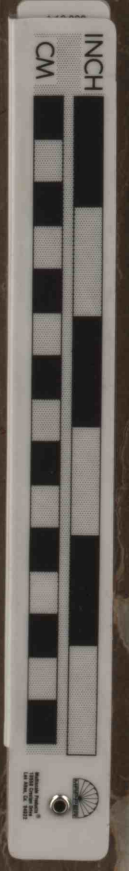

55
56
57
58
59
60