
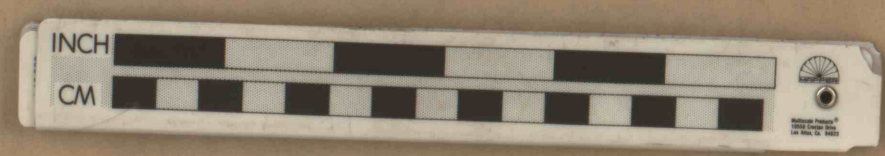


PLAN SHOWING
WILLIAM J. MANOWN PROPERTY
DIVIDED IN
ROSTRAVER, TWO WESTMORELAND CO. PA.
SCALE: 1/100 MAR. 18-18
E. H. DEFFCO

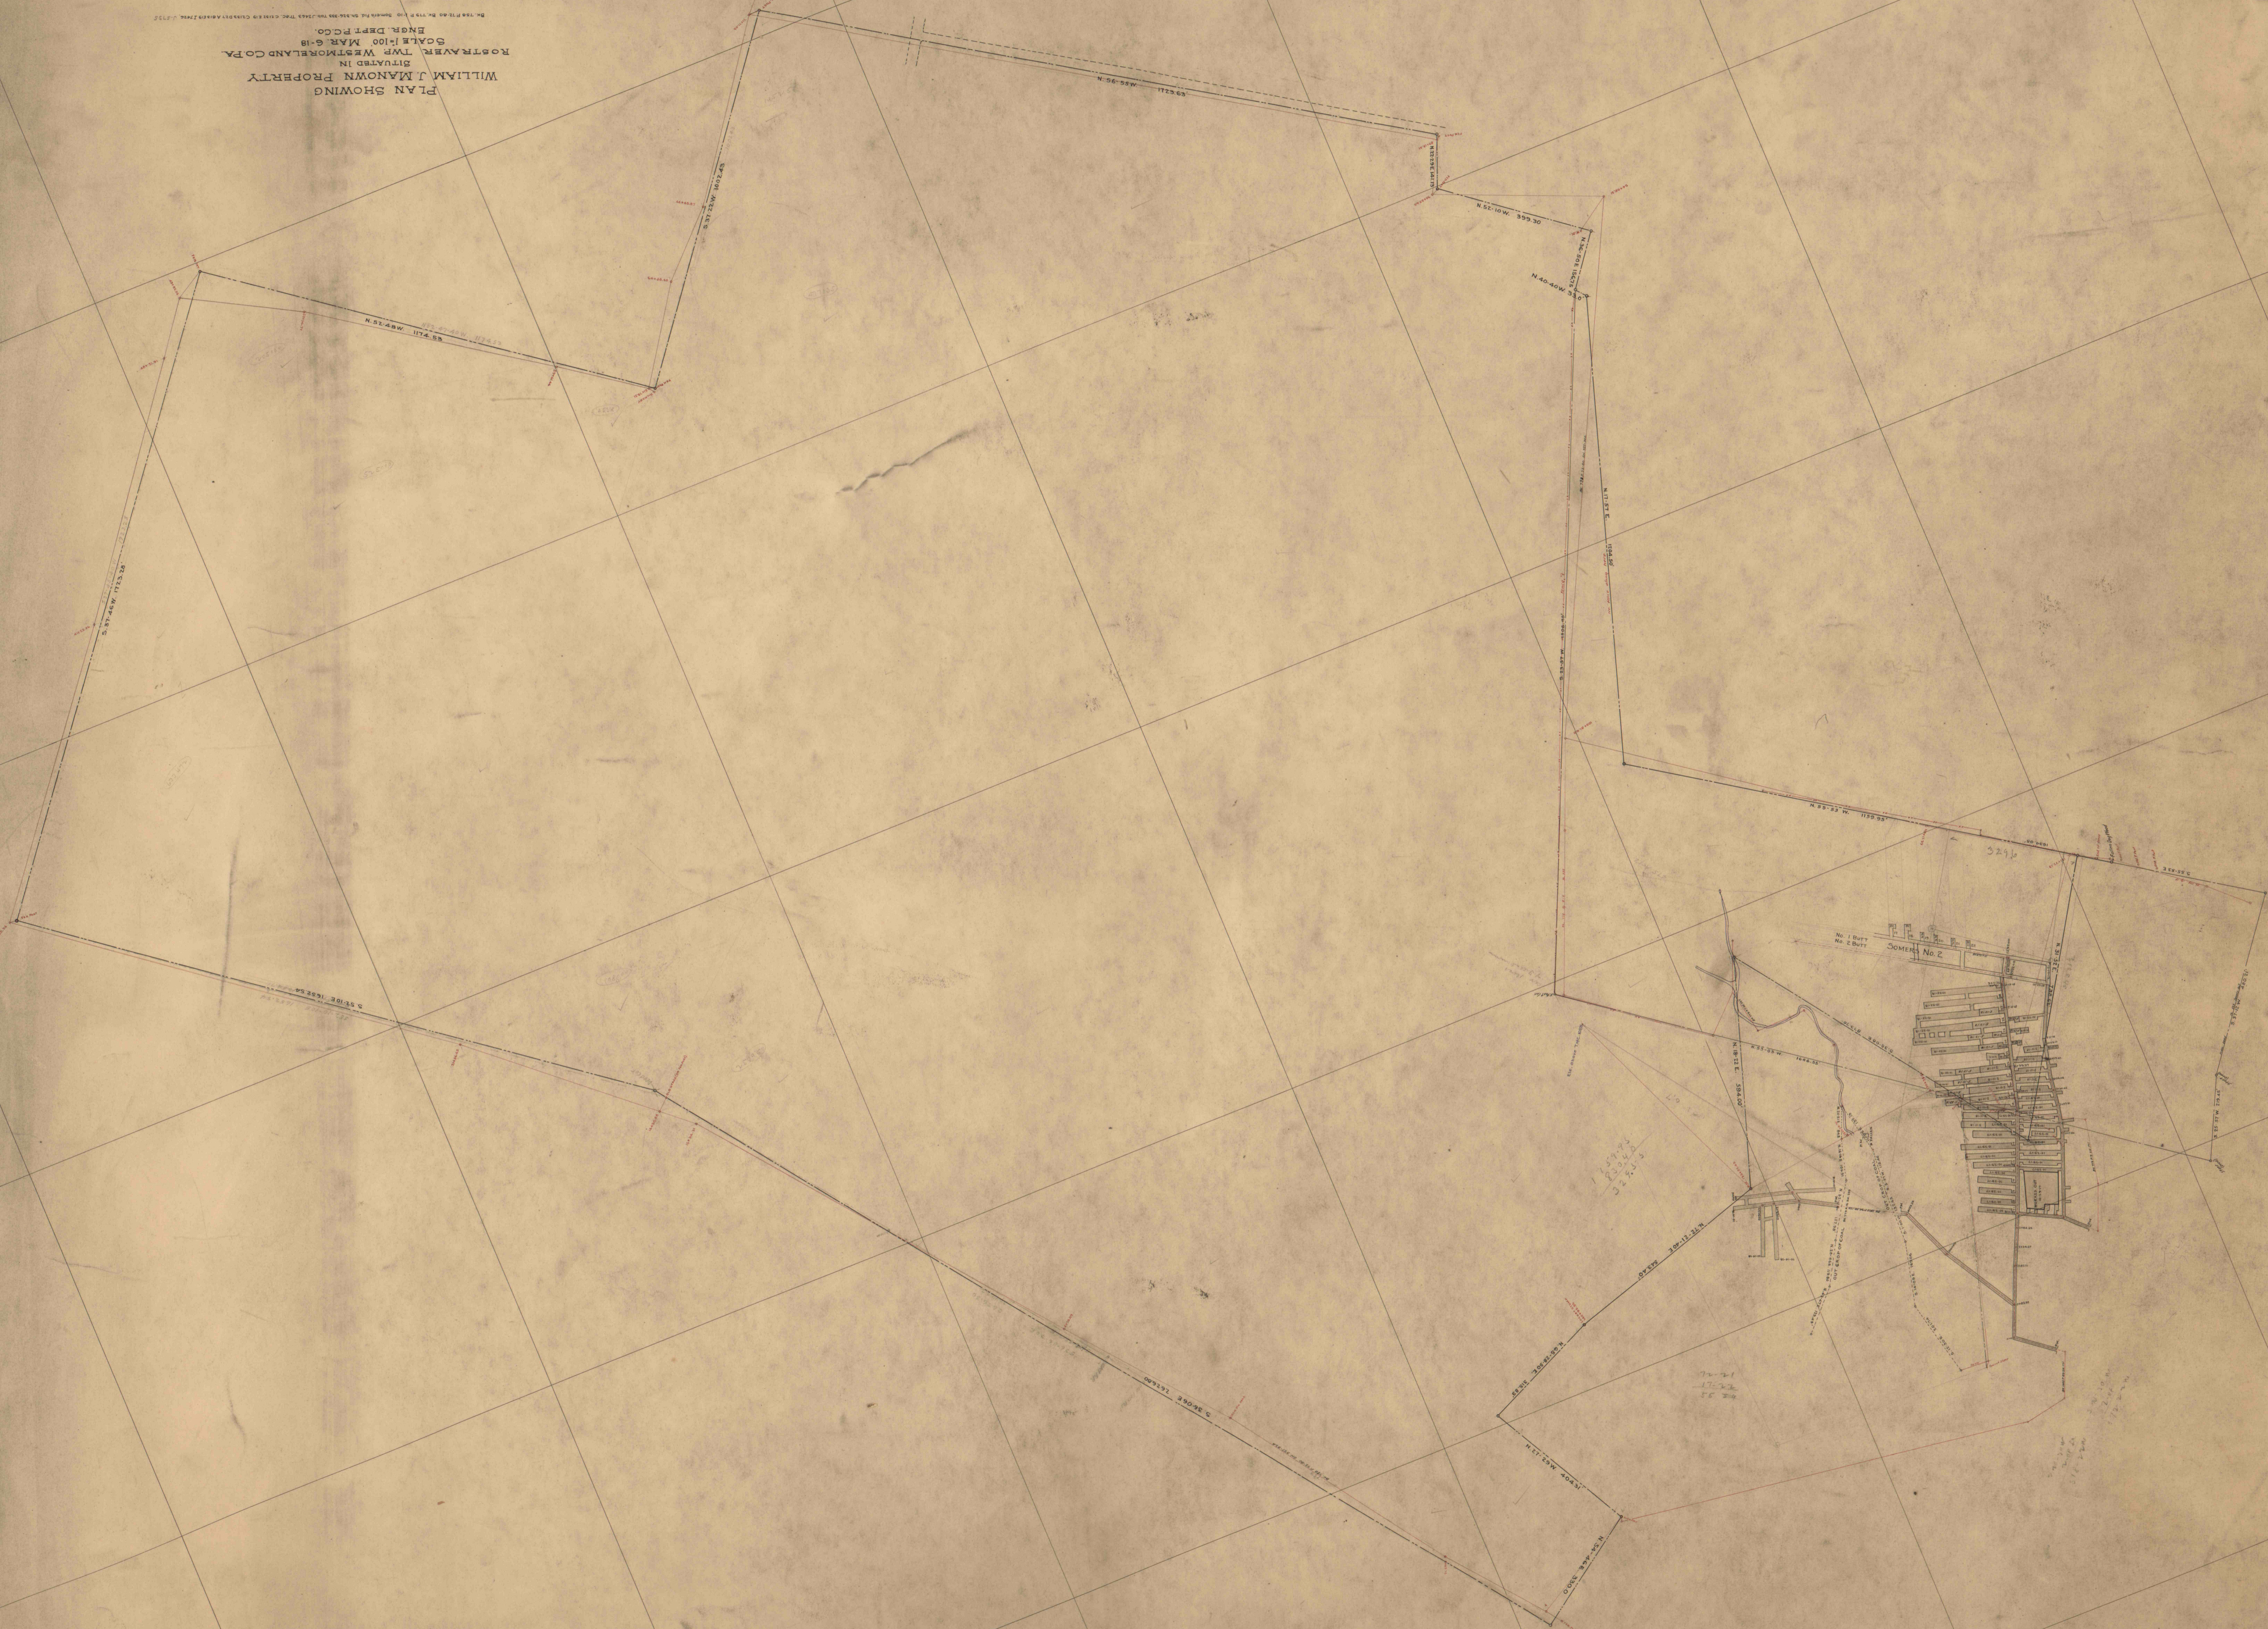

80 82
-1.11
79.81