PLAN OF

MOON RUN MINE, SEC. 3.

Scale 100 ft. = 1" Oct. 16, 1961.

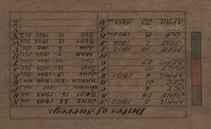

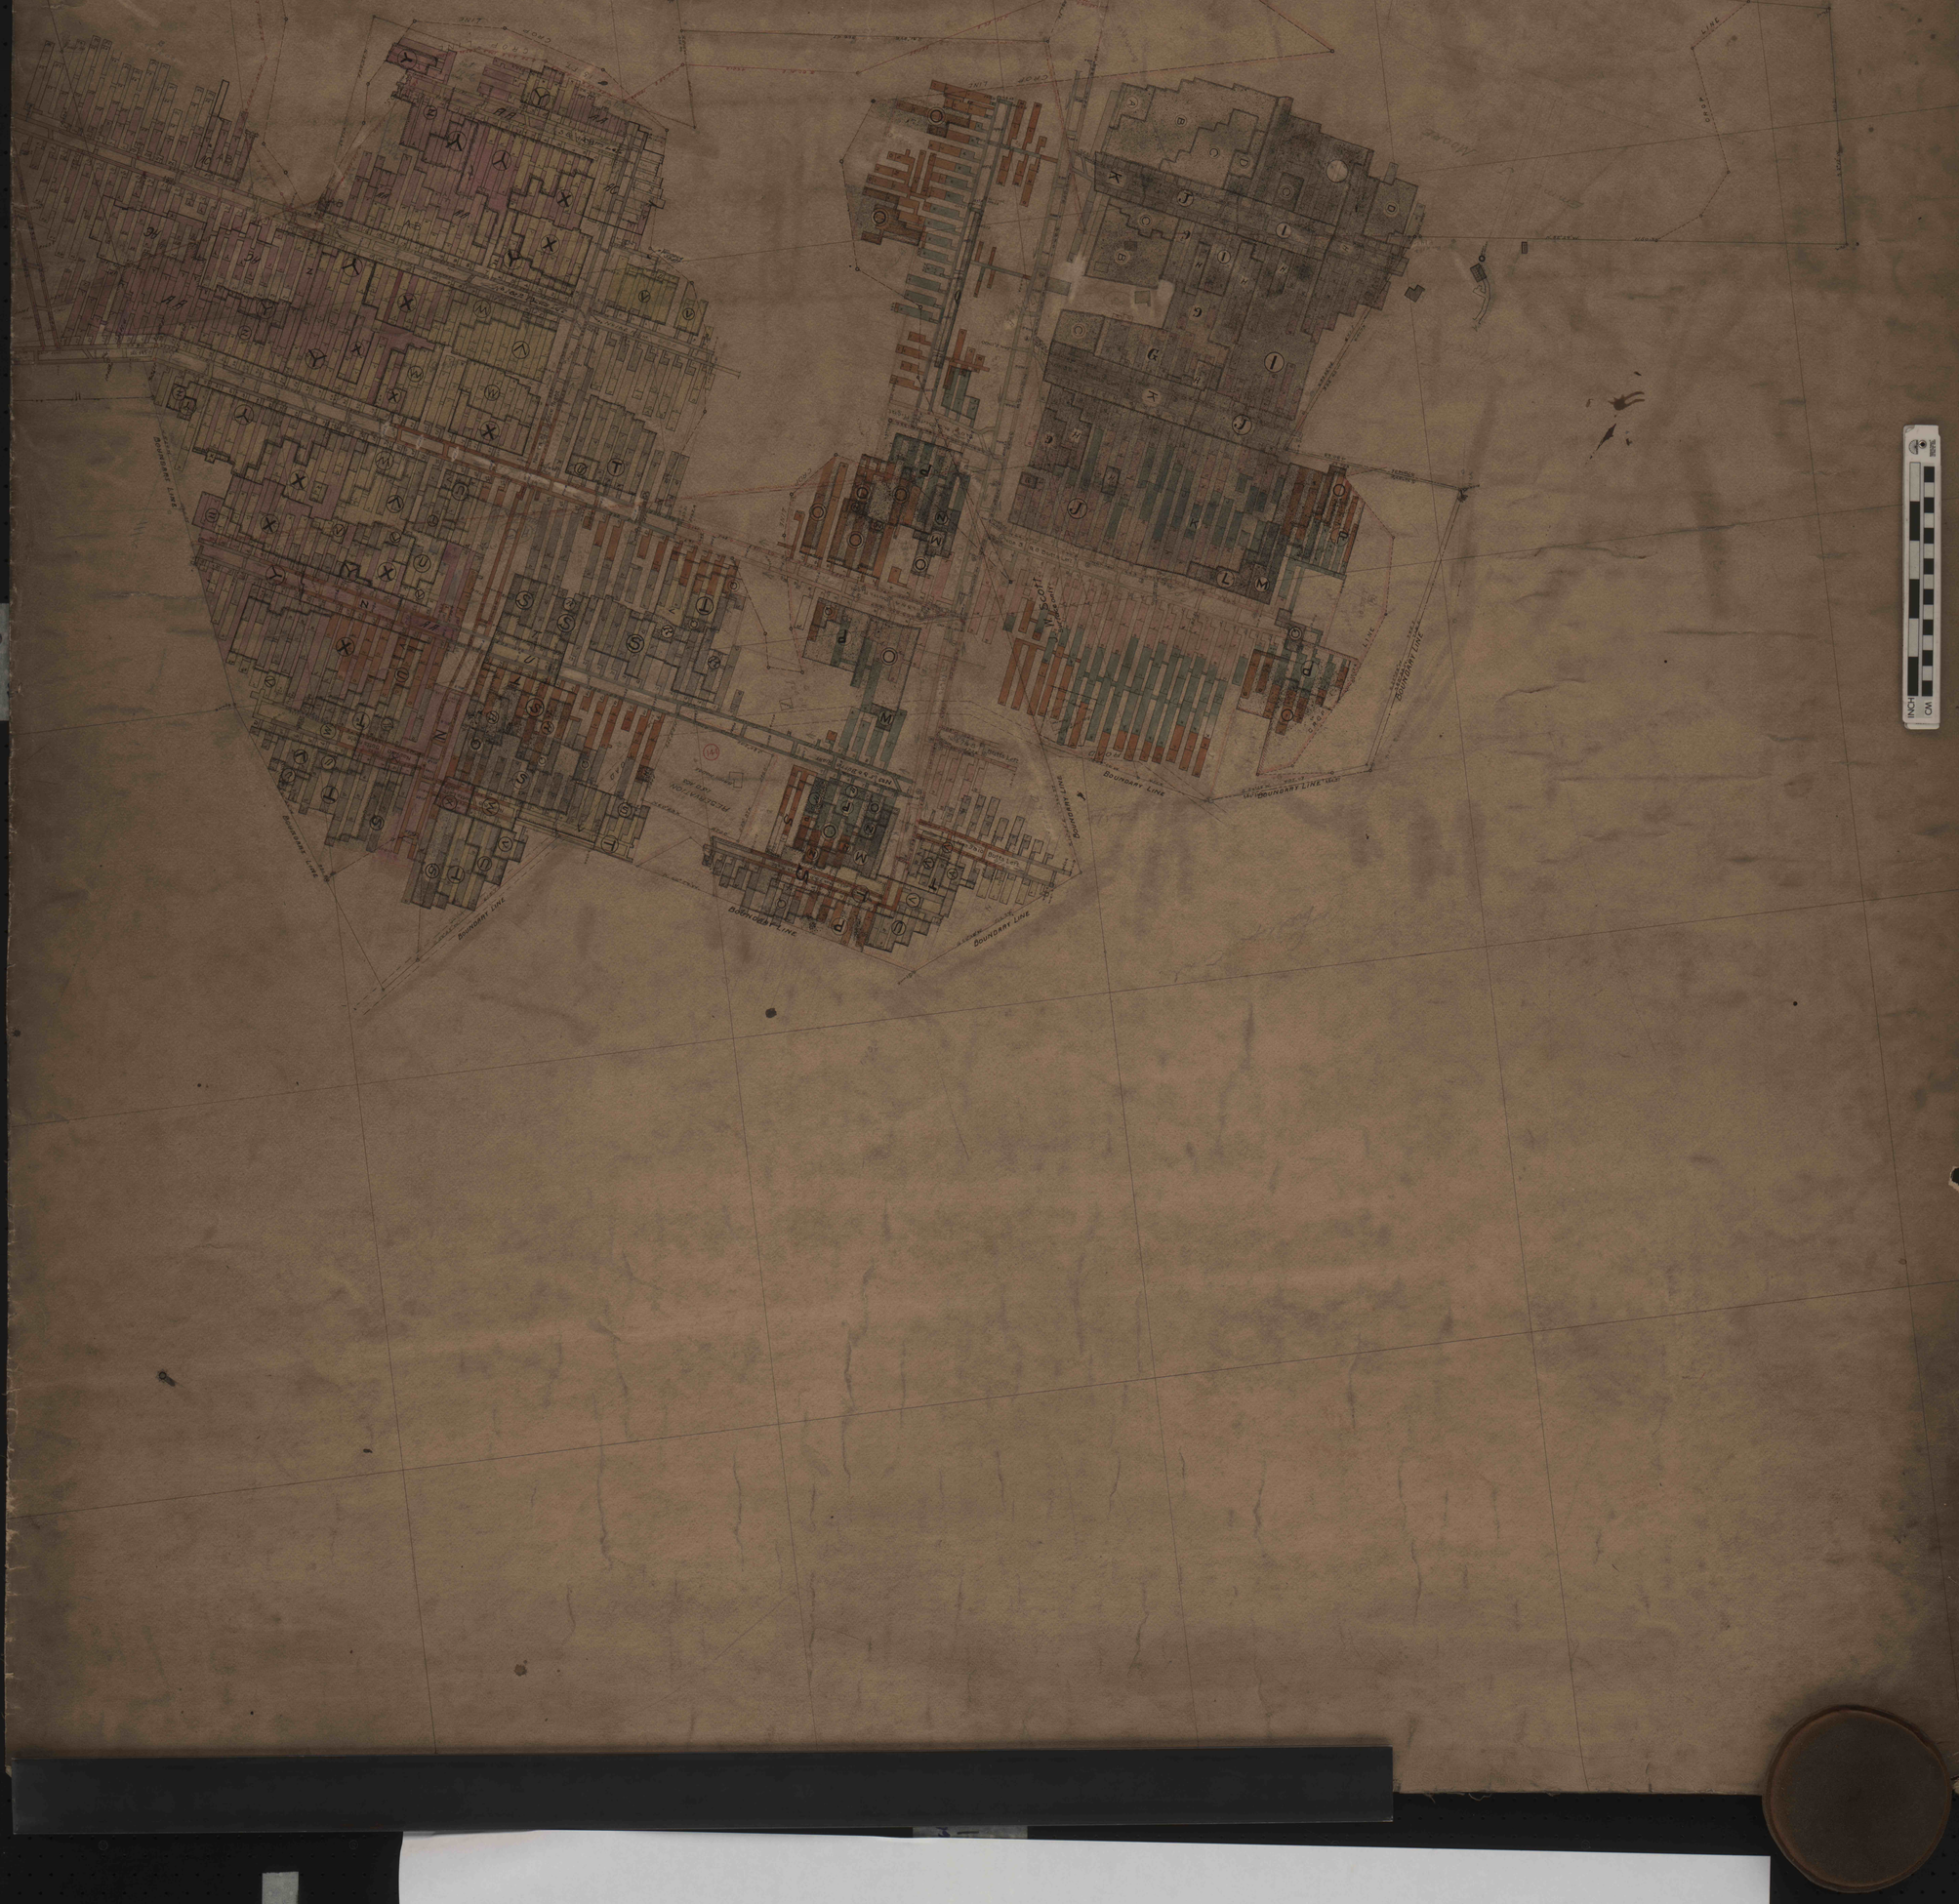
Boundary Line
Boundary Line
Boundary Line