

55
54
53
52
51
50

**ADDITION
TO
NATIONAL MINE
ENGINEERING PLAN.**


BY JOHN HOPPER HRS.



SPANG-CHAFFANT
CO.

JOHN HOPPER HRS.

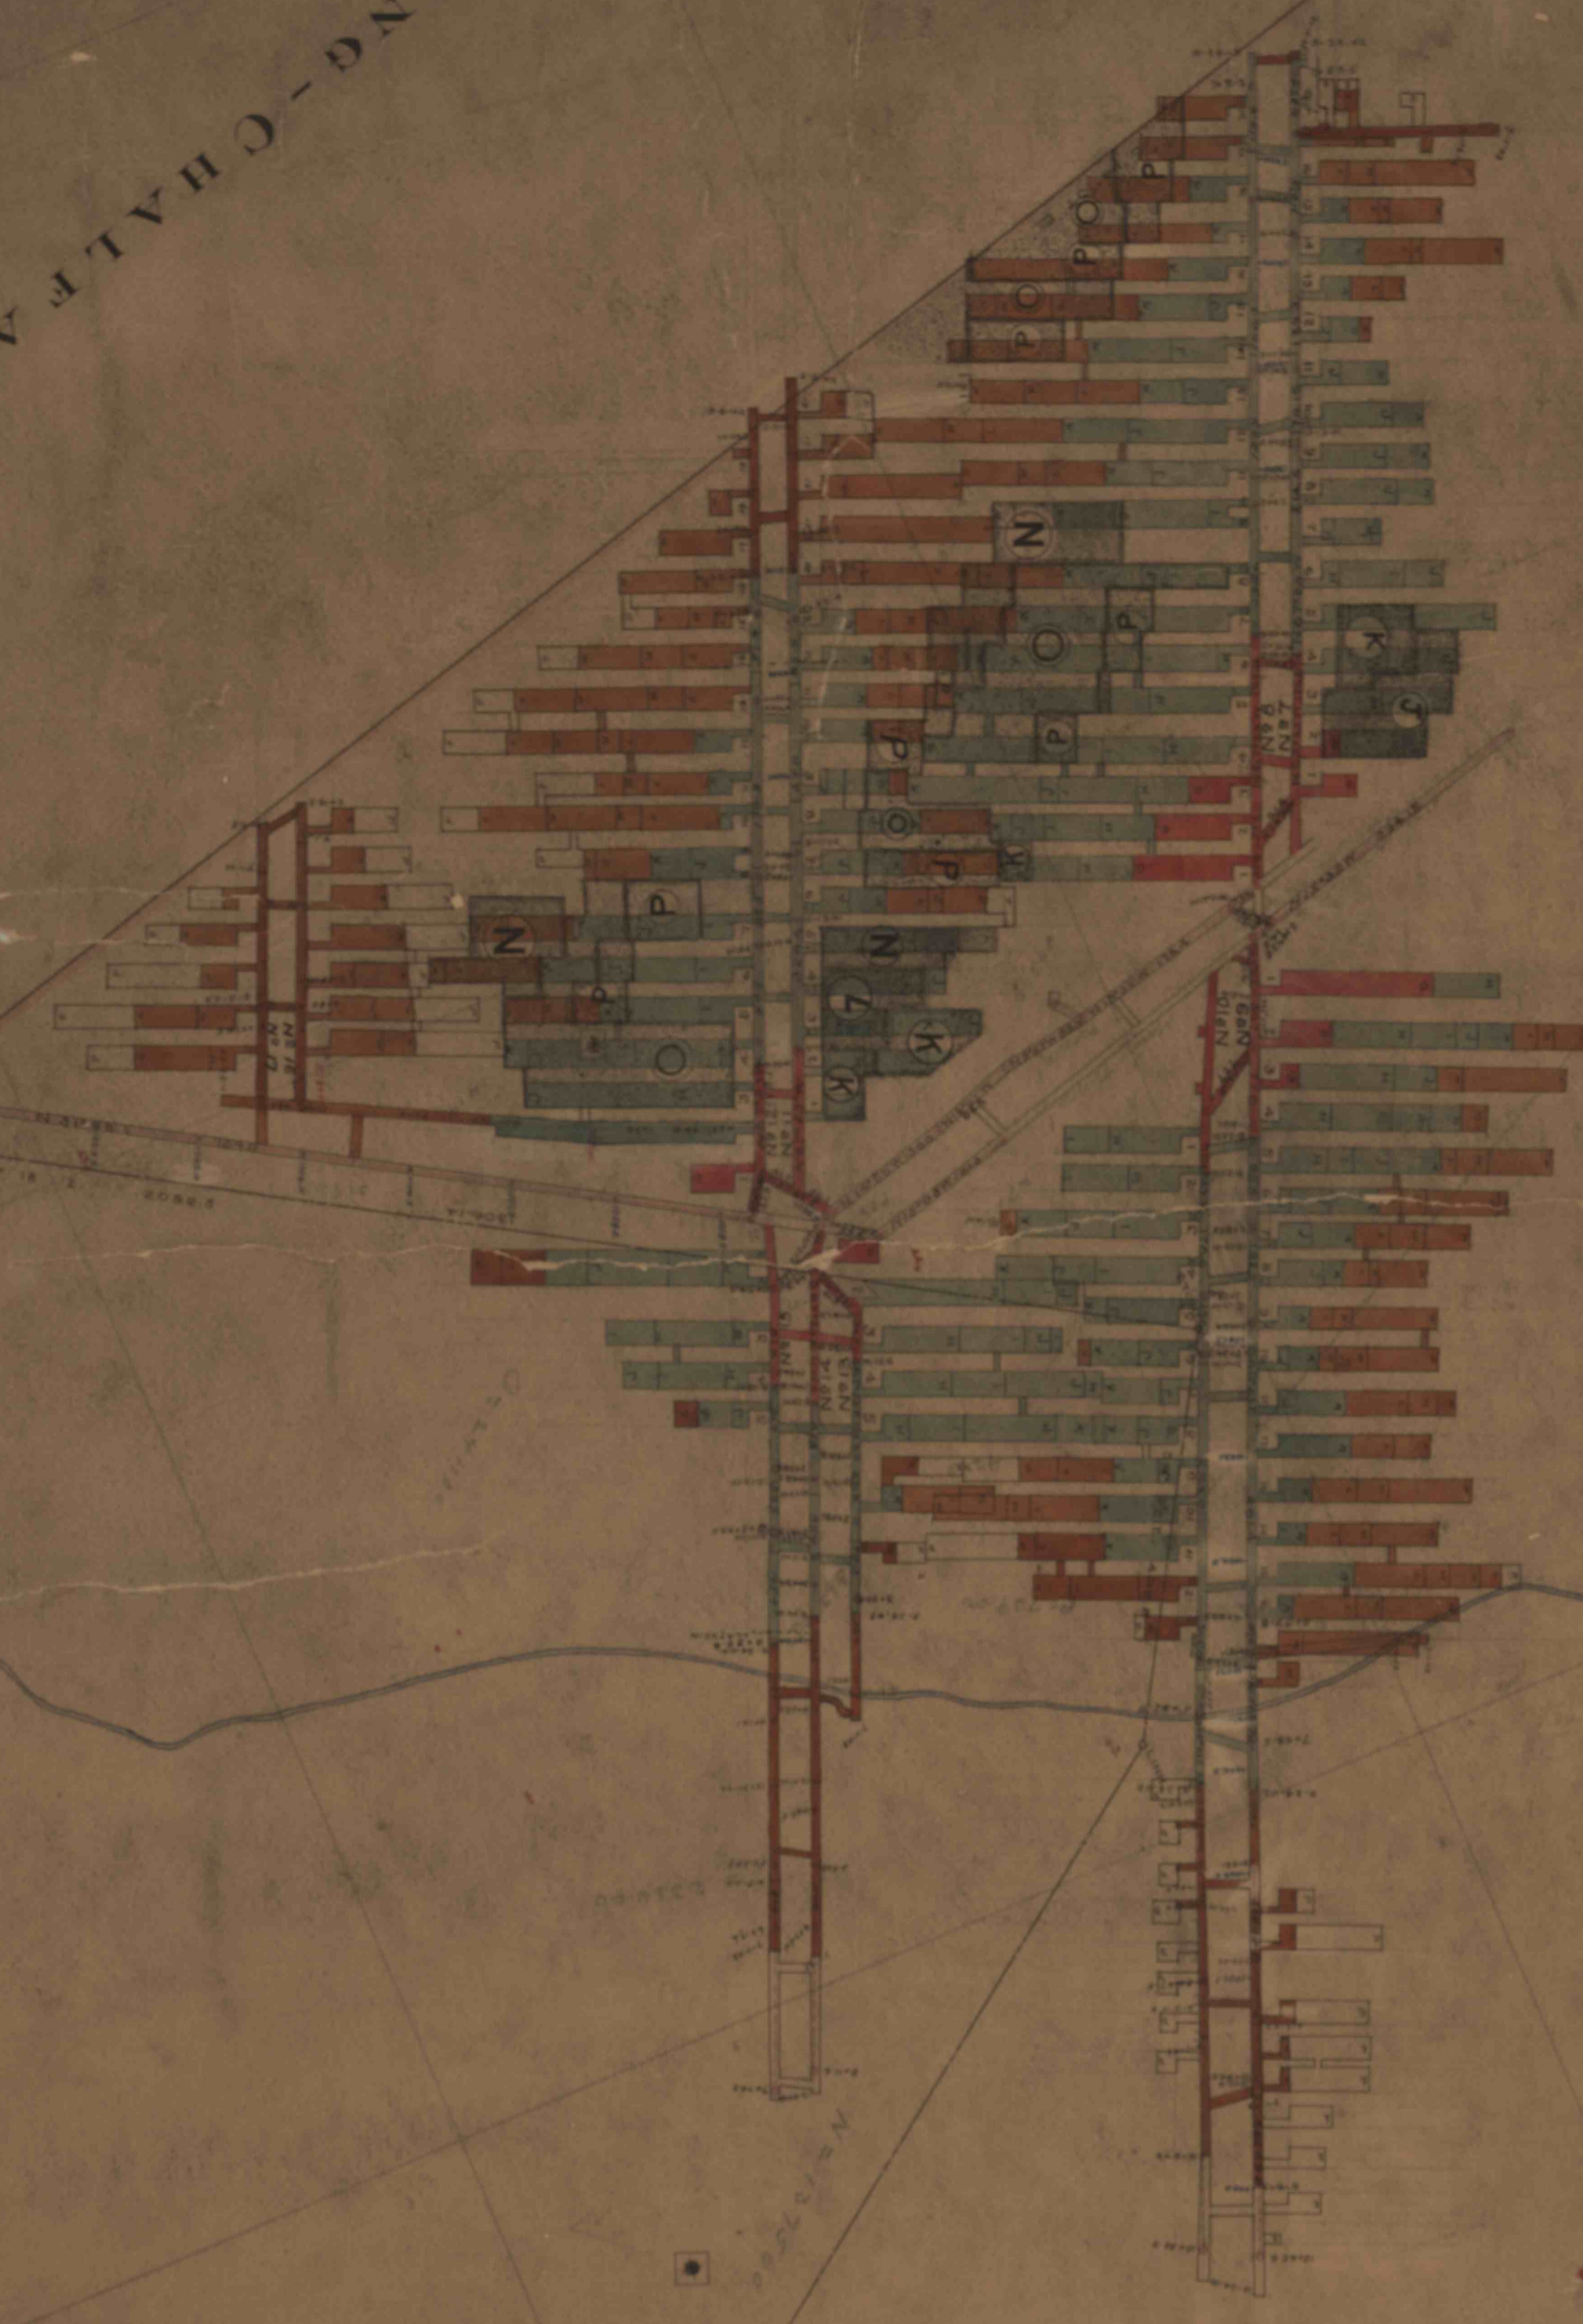

62 60 58
61 59

60 62
59 61

49
50
51
52
53
54
55