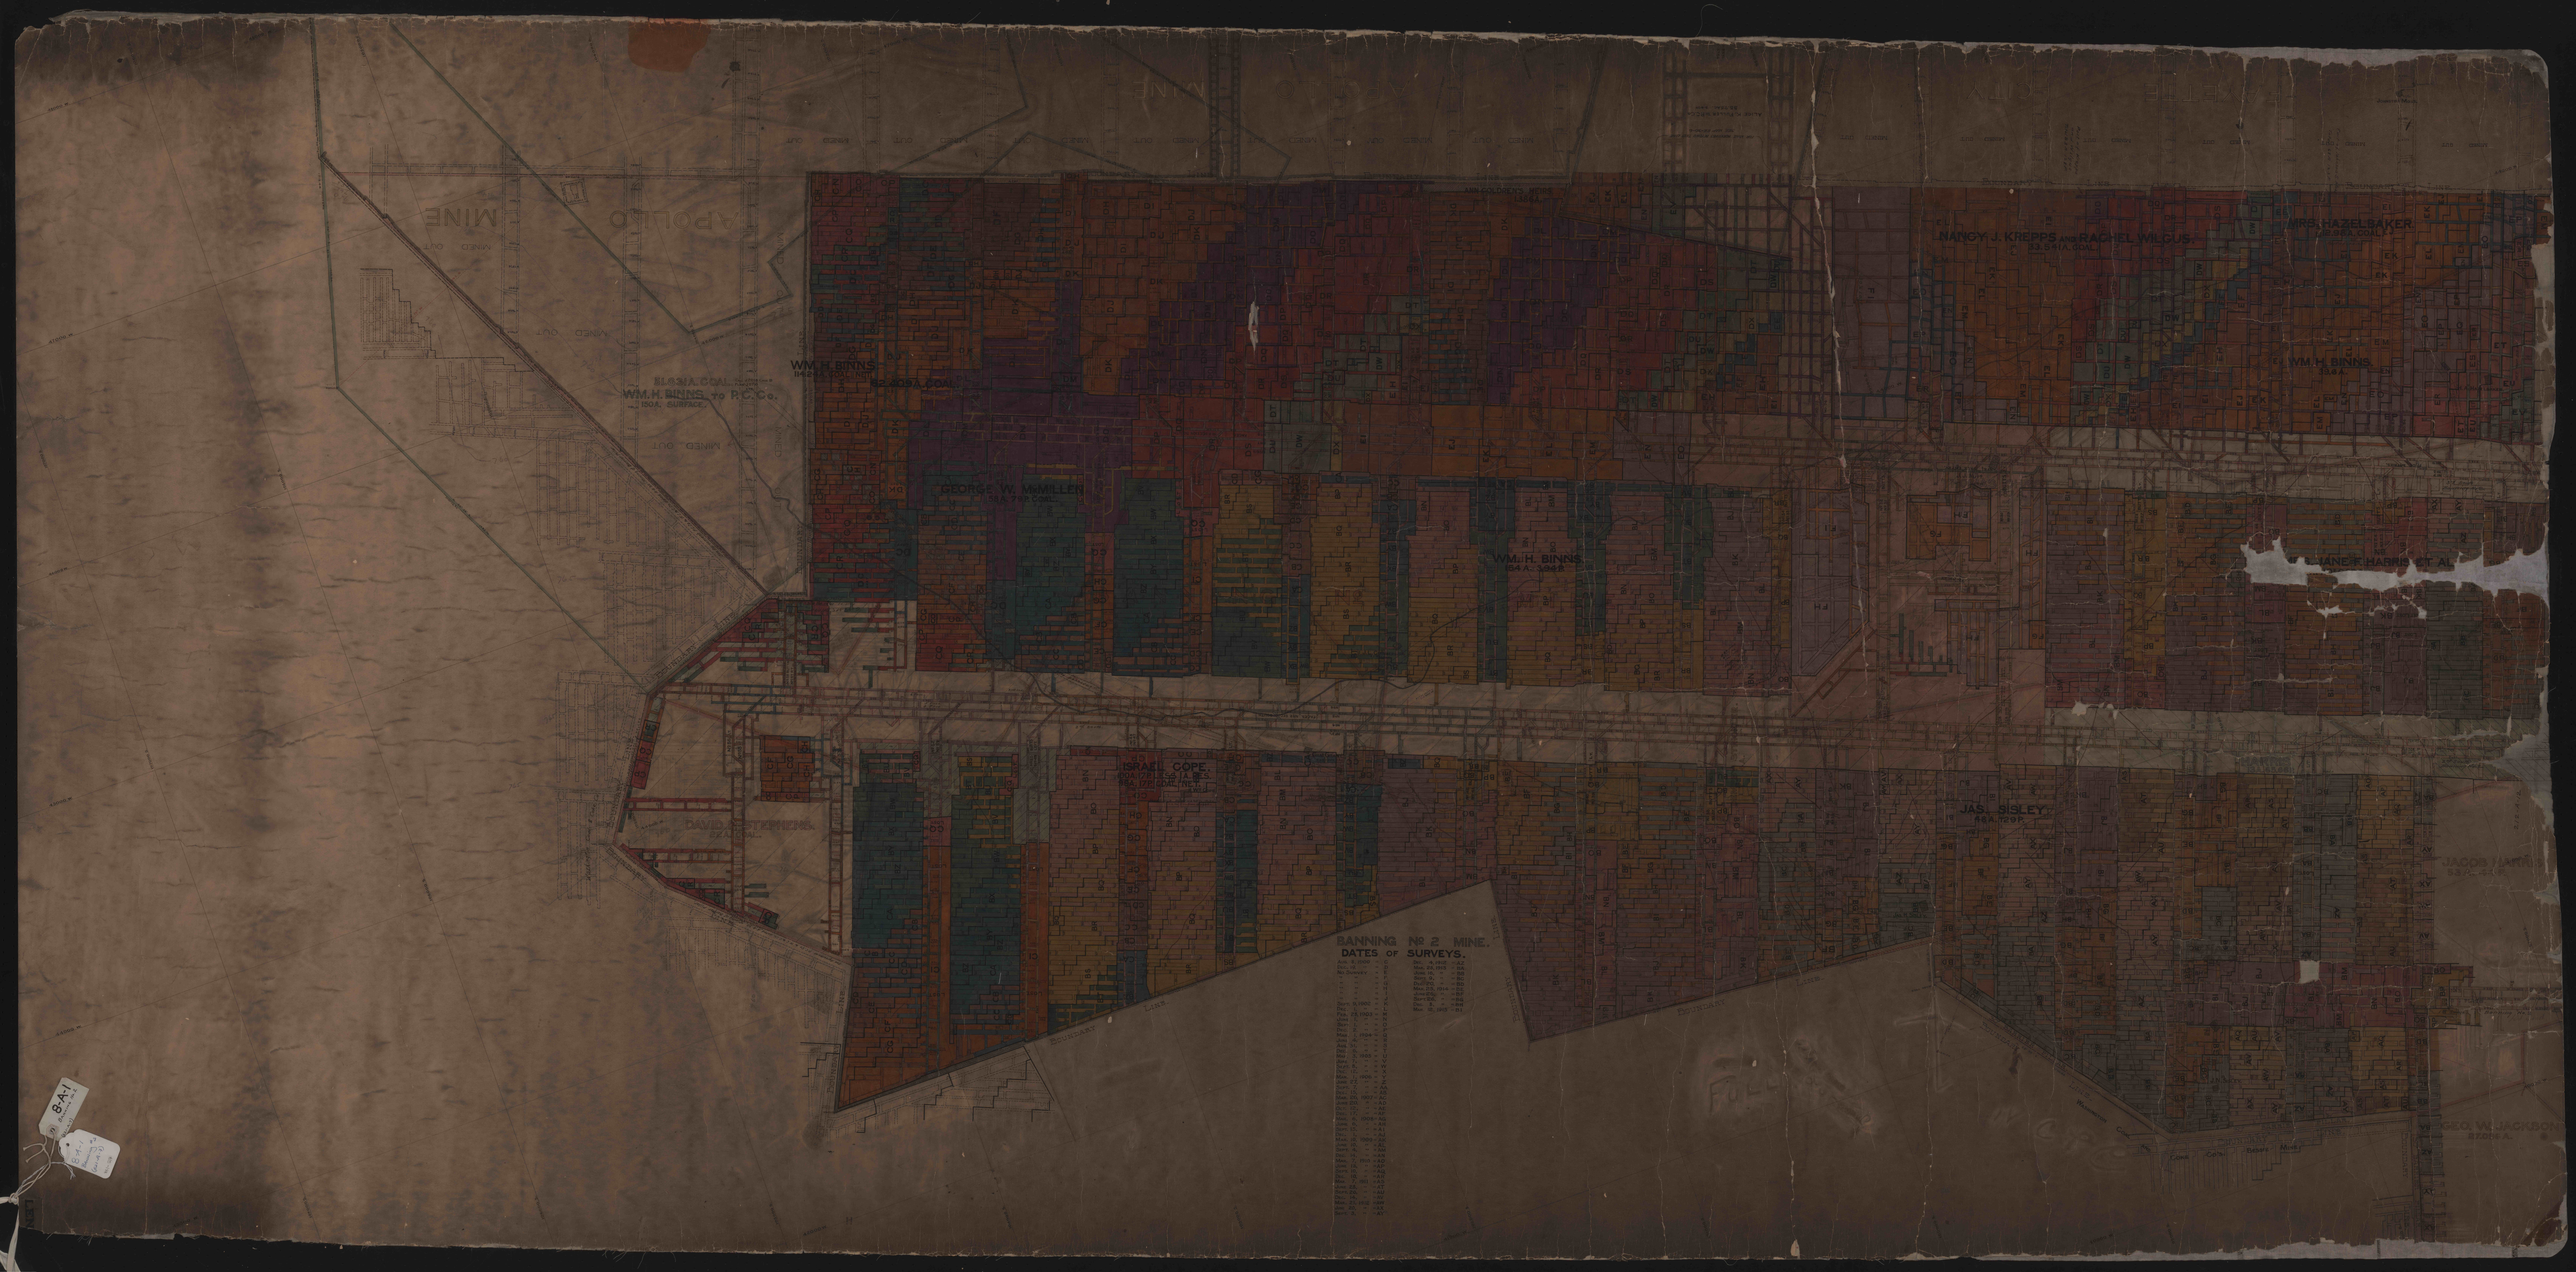
APOLLO MINE
WM. H. BINNS
WM. H. BINNS 70 P.C.Co.
GEORGE W. McMILLEN
WM. H. BINNS
ISRAEL COPE
NANCY J. KREPPS AND RACHEL WILCUS
MRS. HAZEL BAKER
WM. H. BINNS
JANE E. HARRIS ET AL
JAS. SISLEY
JACOB VIANTS
GEO. W. JACKSON
BANNING No 2 MINE.
DATES OF SURVEYS.