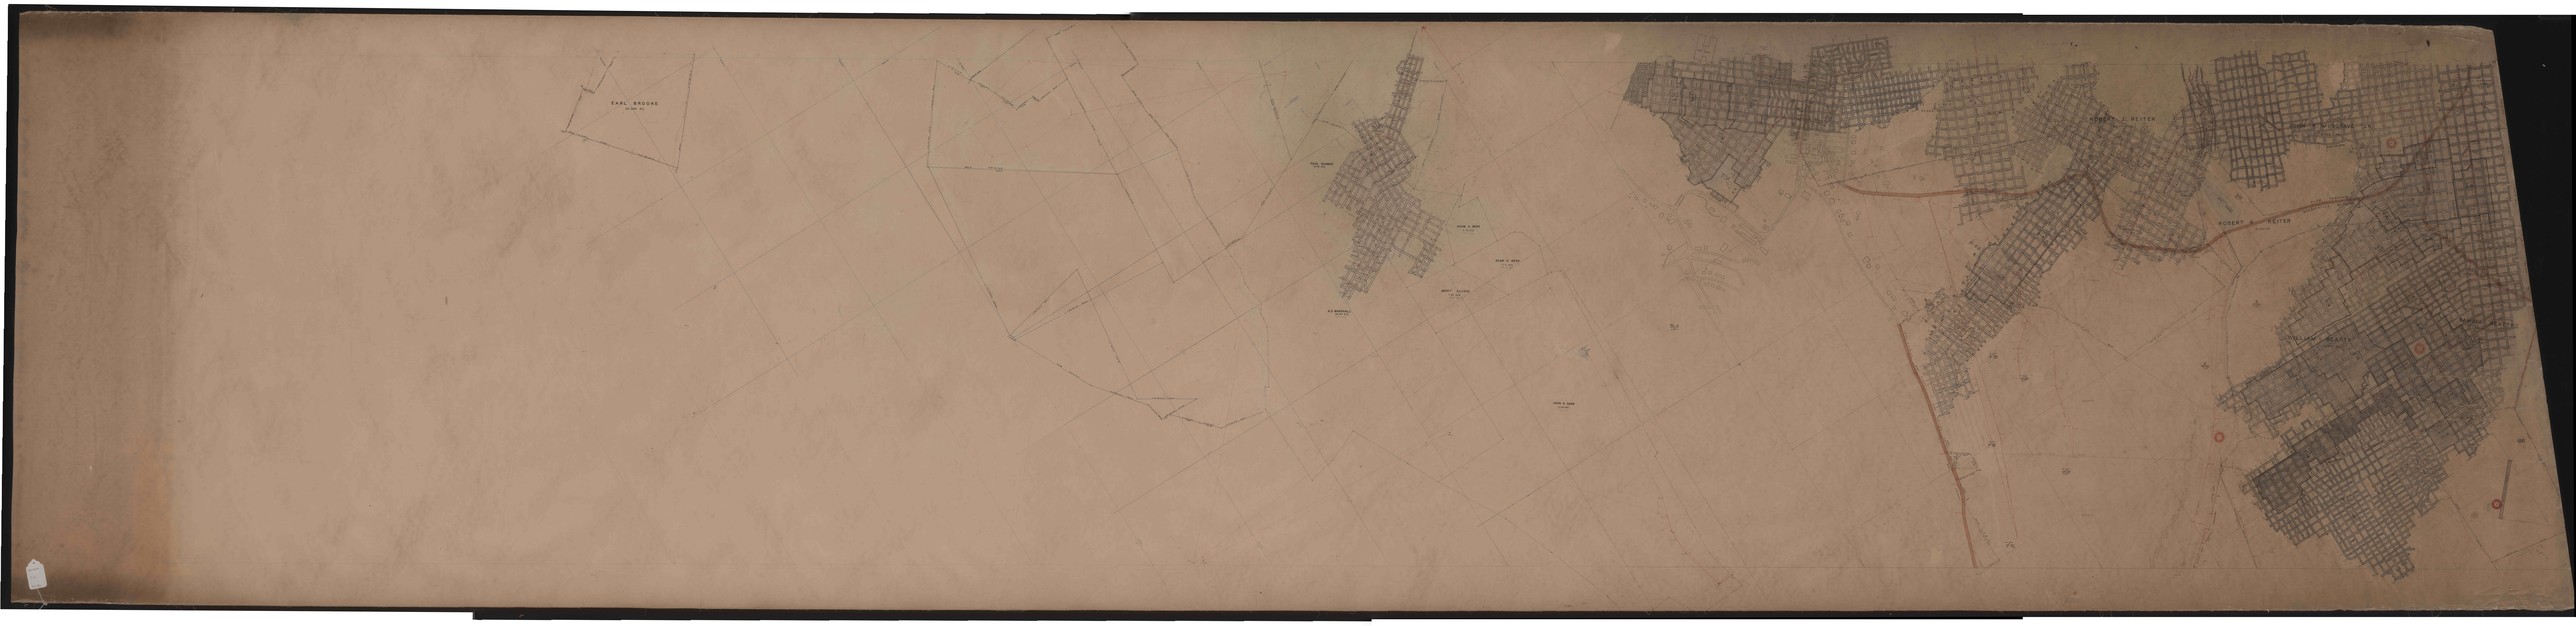
EARL BROOKE
ROBERT J. REITER
ROBERT A. REITER
WILLIAM BEATTY
SAMUEL BEATTY