


49-
47-
46-
45-

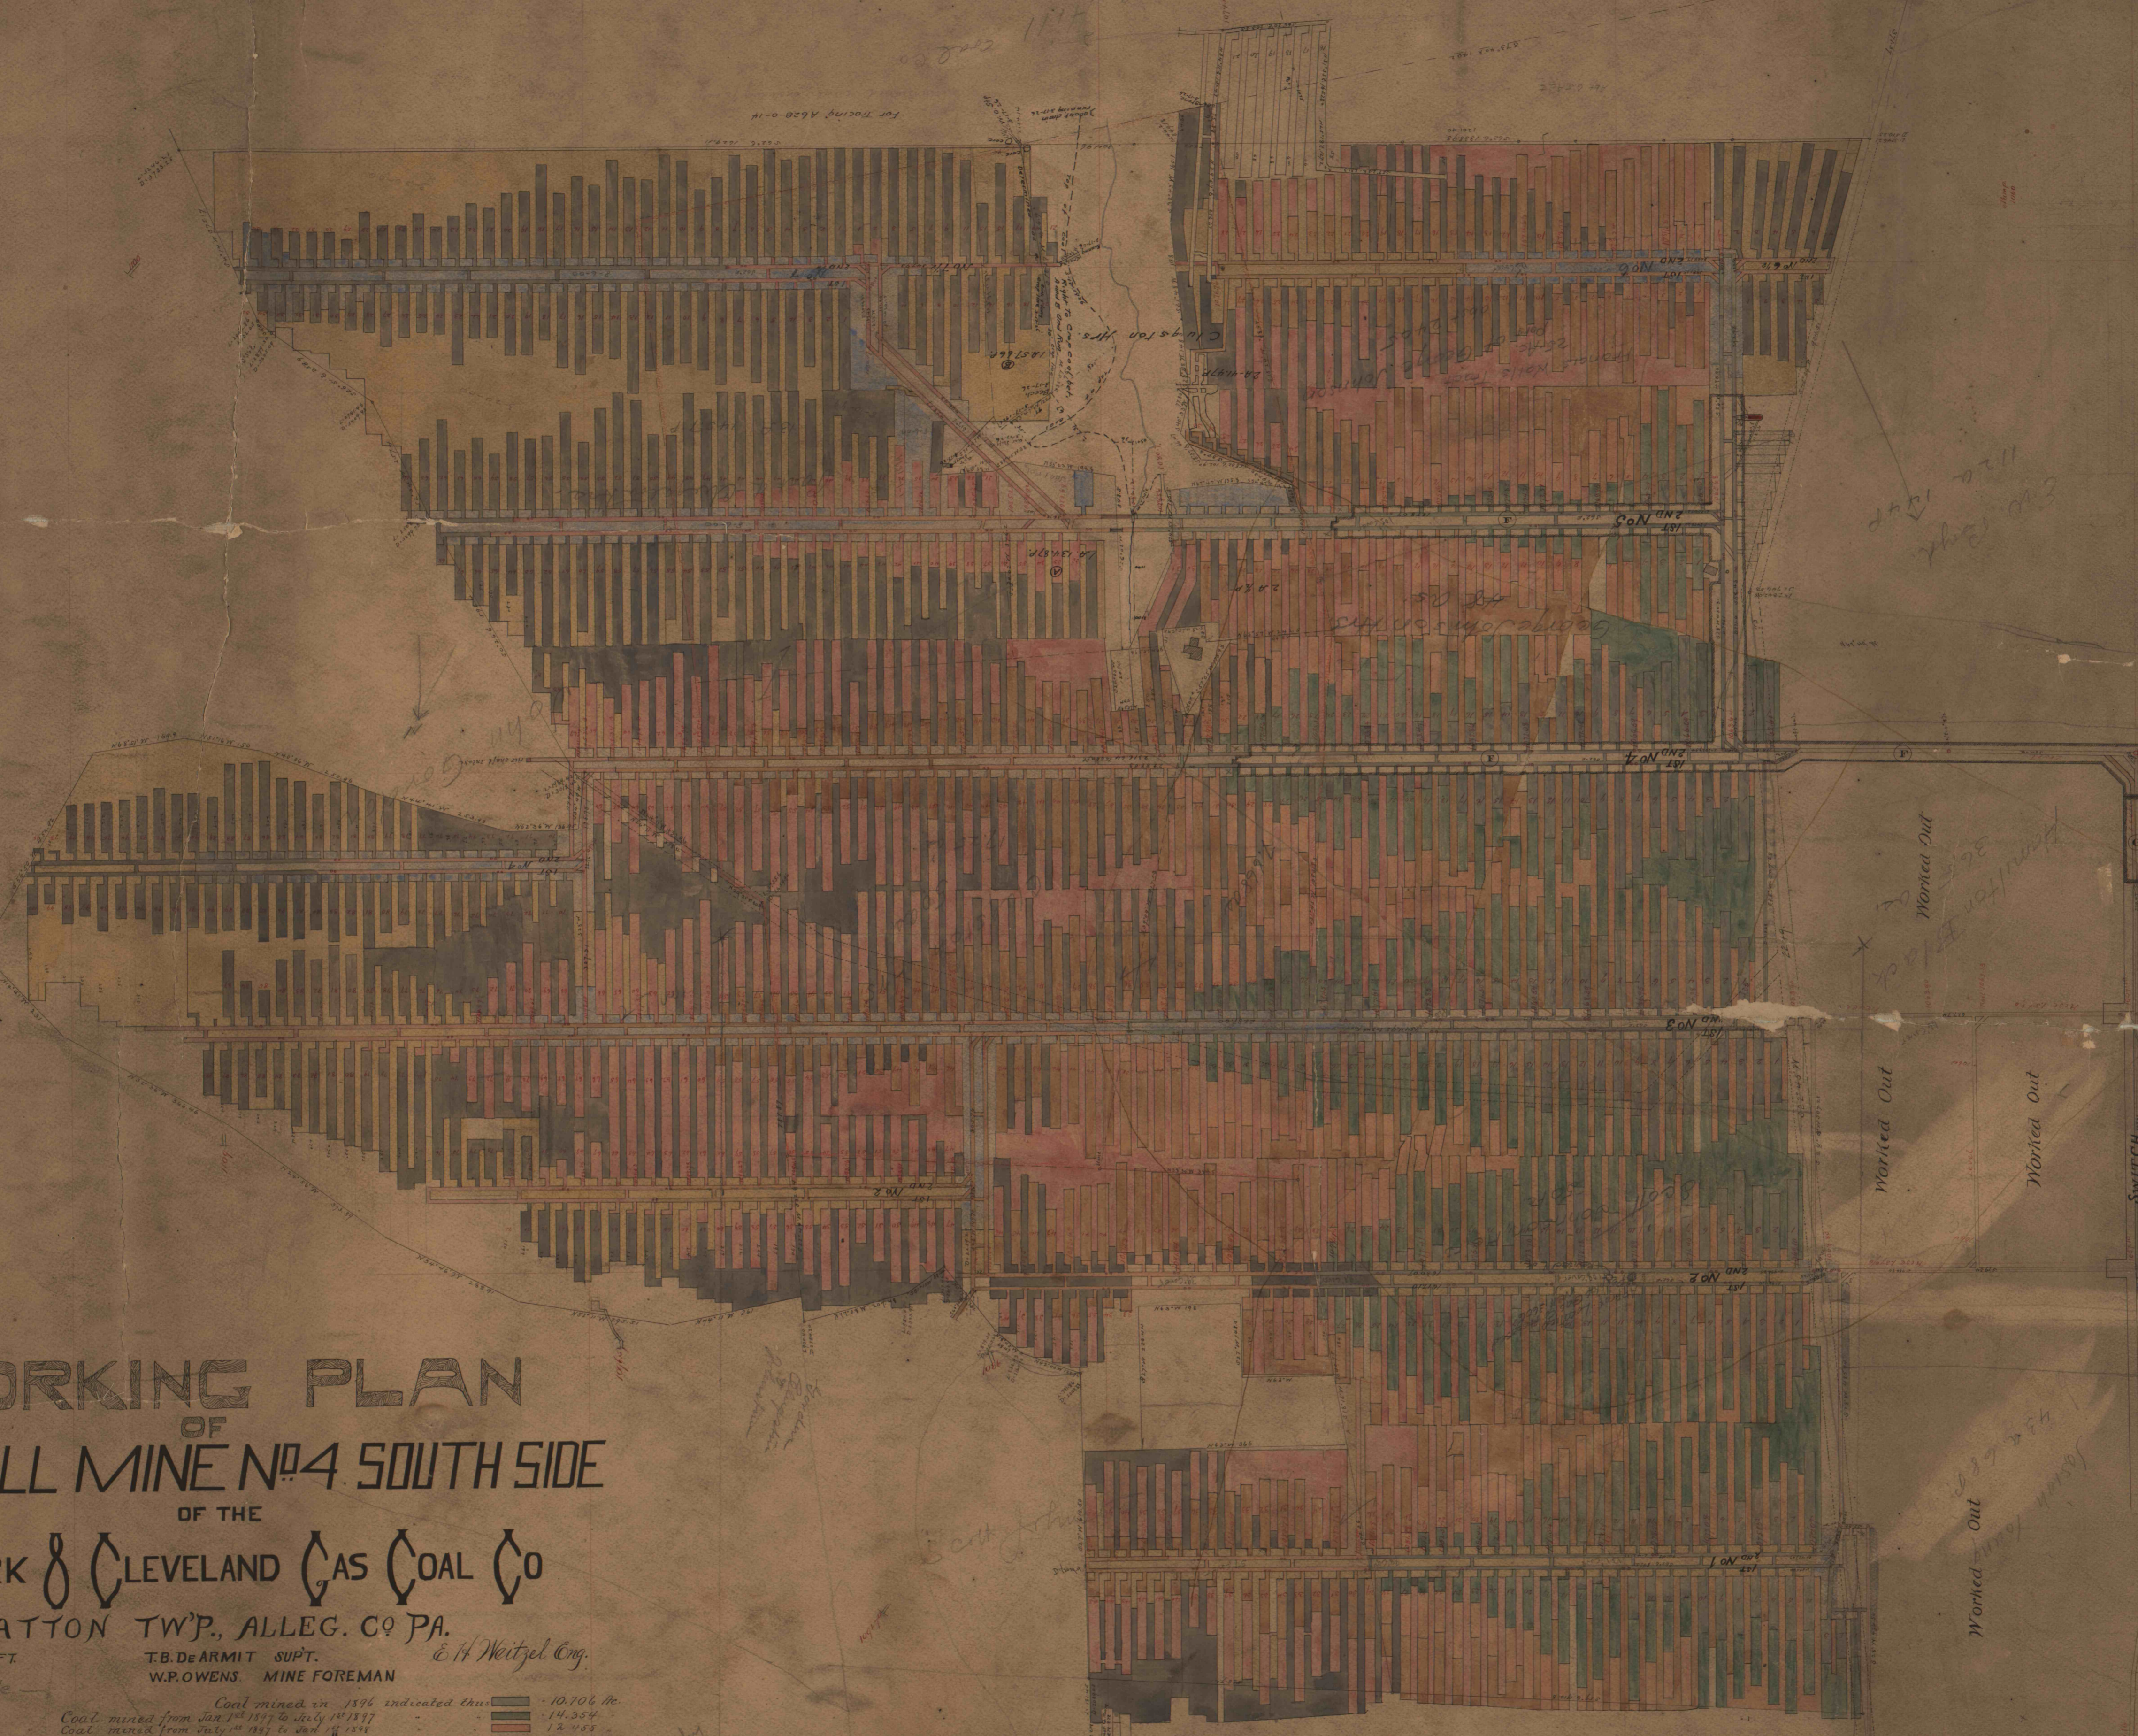

WORKING PLAN
OF
OAK HILL MINE NO. 4 SOUTH SIDE
OF THE
NEW YORK & CLEVELAND GAS COAL CO
PATTON TWP., ALLEG. CO PA.

SCALE 1 INCH = 100 FT.

South Side

T.B. De ARMIT SUPT.
W.P. OWENS MINE FOREMAN

E. H. Weitzel Eng.

Coal mined in 1896 indicated thus:

[Dark Blue]	10,706 Mc
[Blue]	14,554
[Light Blue]	12,405
[Cyan]	23,167
[Green]	28,355
[Light Green]	28,019
[Yellow-Green]	35,200
[Yellow]	5,846
[Orange]	2,723

1896-1901

390926



47-
48-
49-

54 56
3 55 57