


47  
46  
44  
43  
42

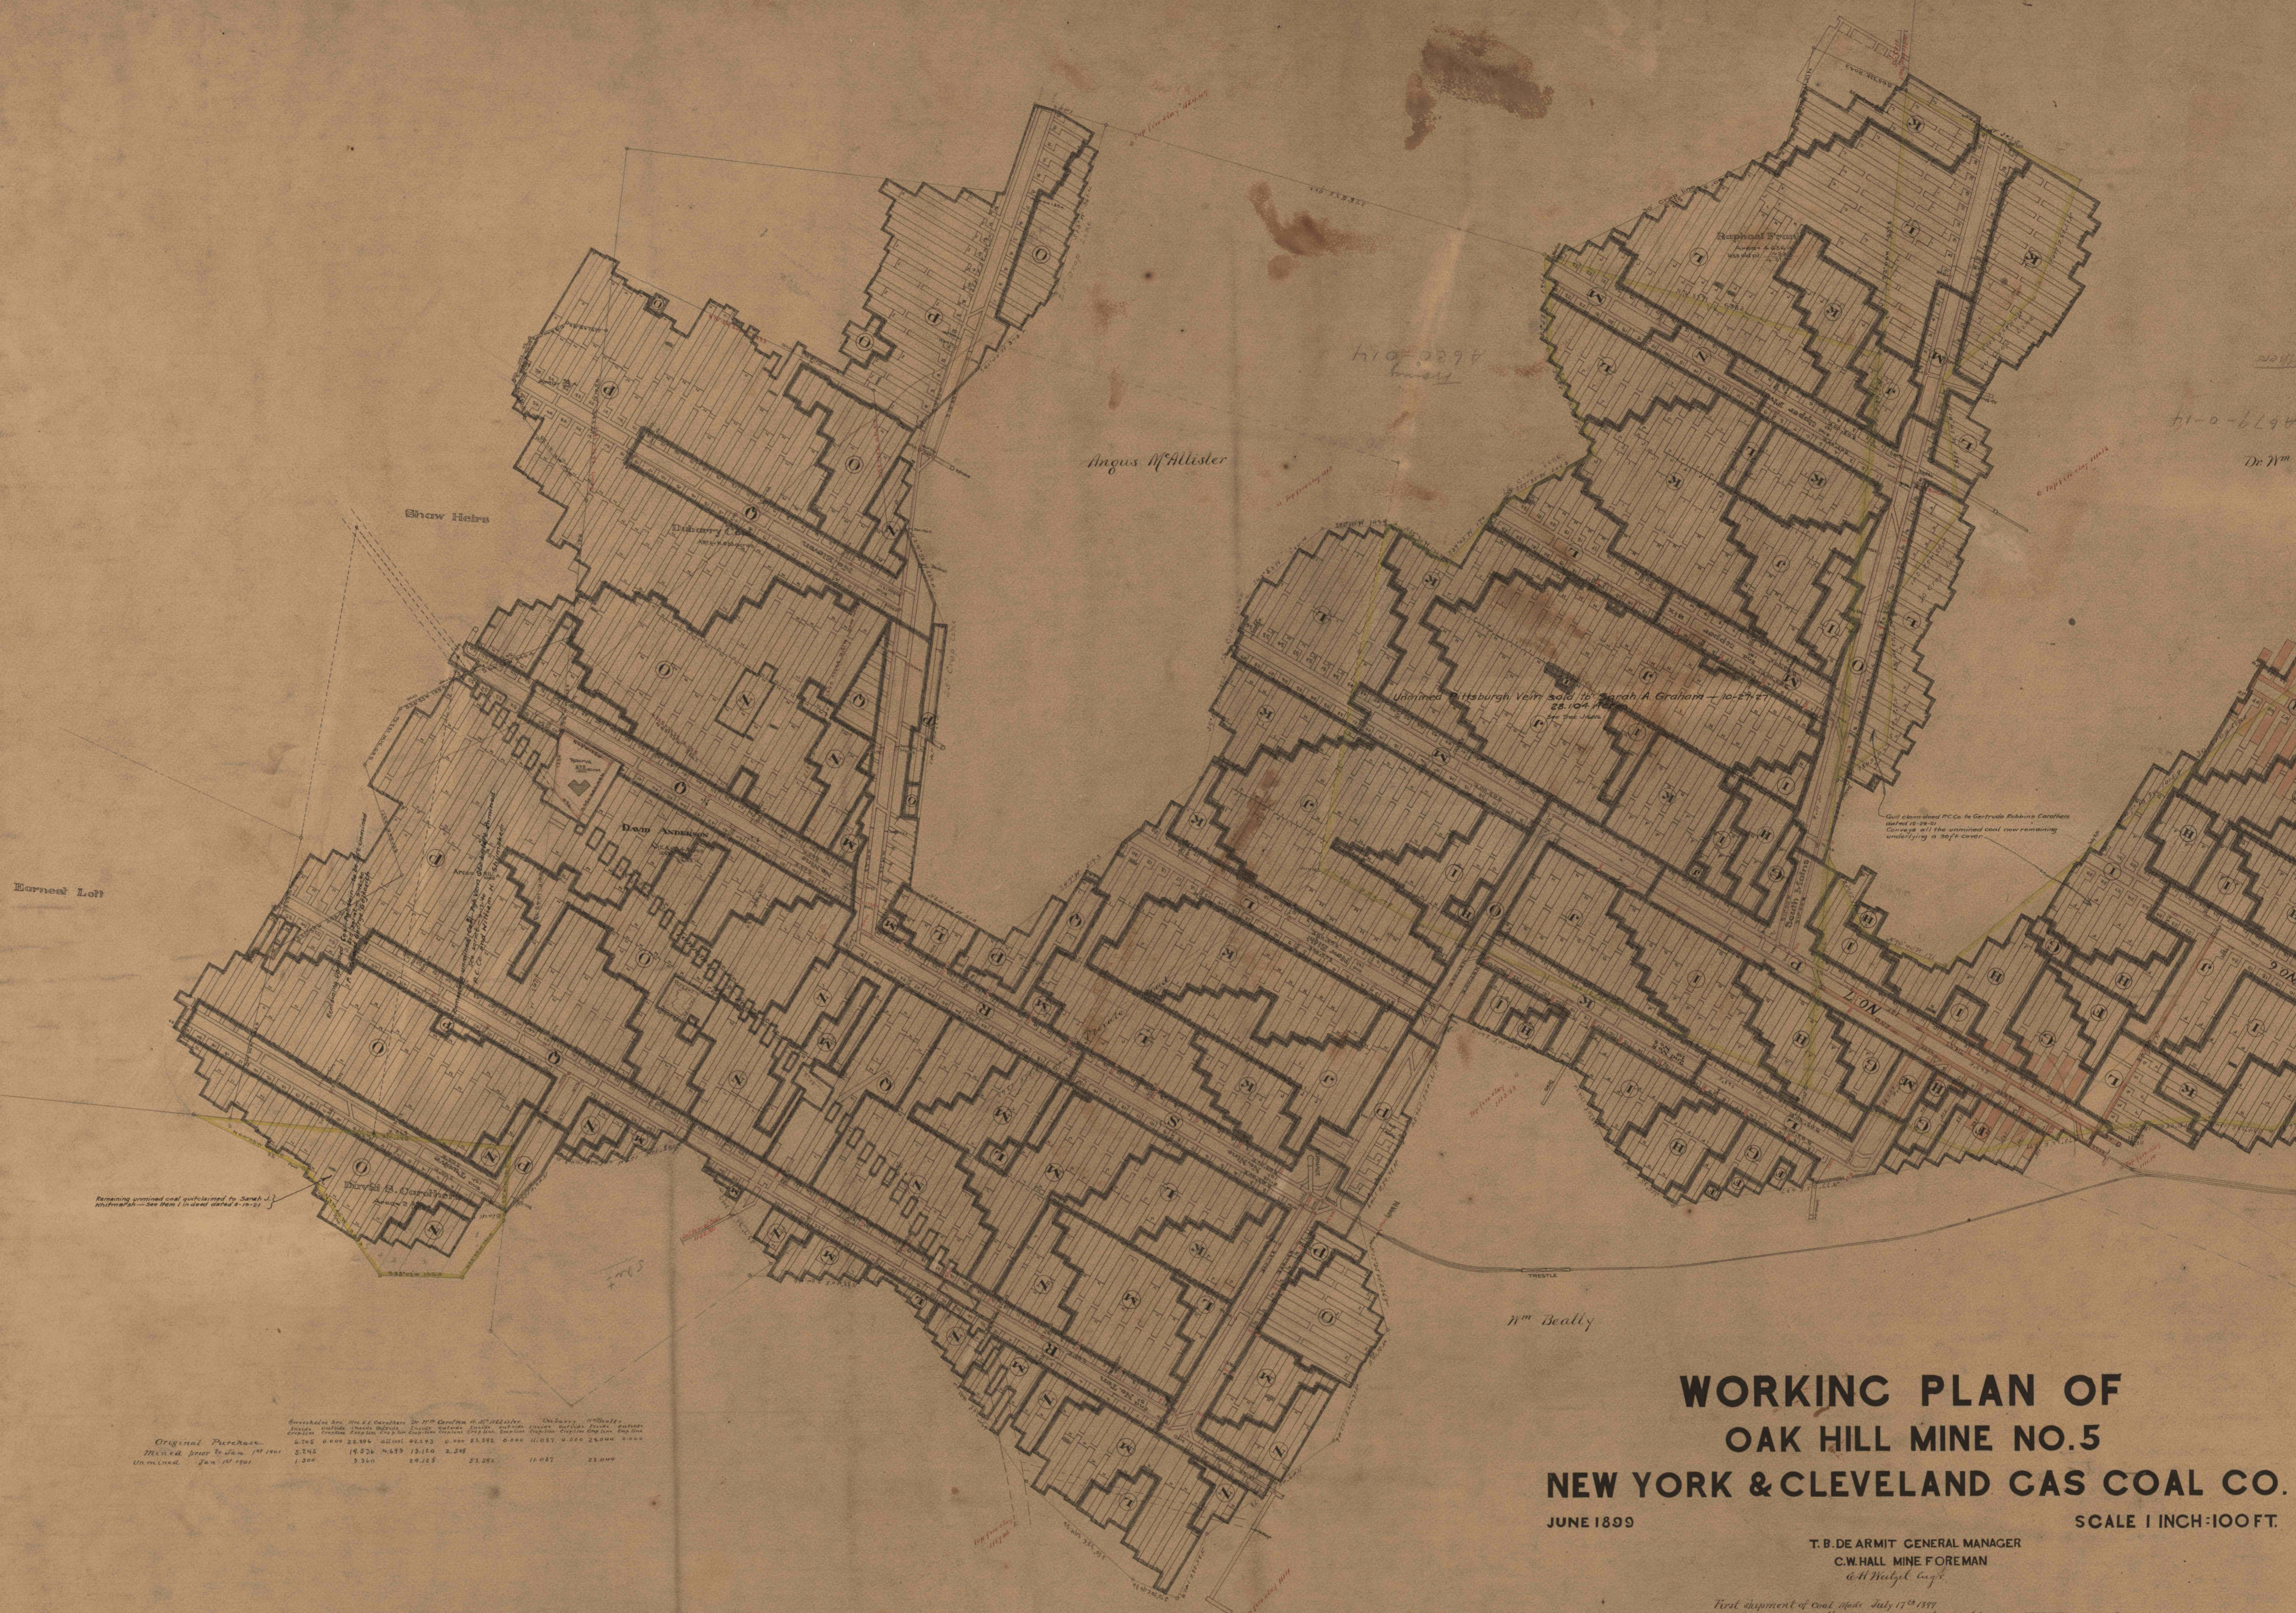

**WORKING PLAN OF  
OAK HILL MINE NO. 5  
NEW YORK & CLEVELAND GAS COAL CO.**  
JUNE 1893

T. B. DE ARMIT GENERAL MANAGER  
C. W. HALL MINE FOREMAN  
at Hazel Run

First shipment of coal made July 15<sup>th</sup> 1893  
Coal mined from March 5<sup>th</sup> to March 31<sup>st</sup> 1900 indicated thus  
Coal mined between July 1<sup>st</sup> 1900 and Jan 1<sup>st</sup> 1901


- DATE OF SURVEY**
- E - July 8<sup>th</sup>
  - G - Sept 3<sup>rd</sup>
  - H - Dec 1<sup>st</sup>
  - I - Mar 3<sup>rd</sup>
  - J - Oct 1<sup>st</sup>
  - K - Dec 1<sup>st</sup>
  - L - Mar 1<sup>st</sup>

15.50 Acres  
12.326  
17.276

Original Purchase  
Mined from March 5<sup>th</sup> 1900  
Unmined Jan 1<sup>st</sup> 1901

2142	1570	1633	1510	2.28					
1.000	3.210	18.163	21.081	11.087	23.000				

390808

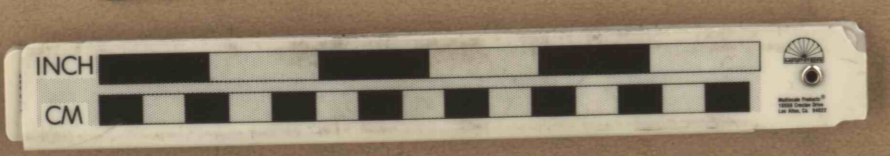

45  
46  
47