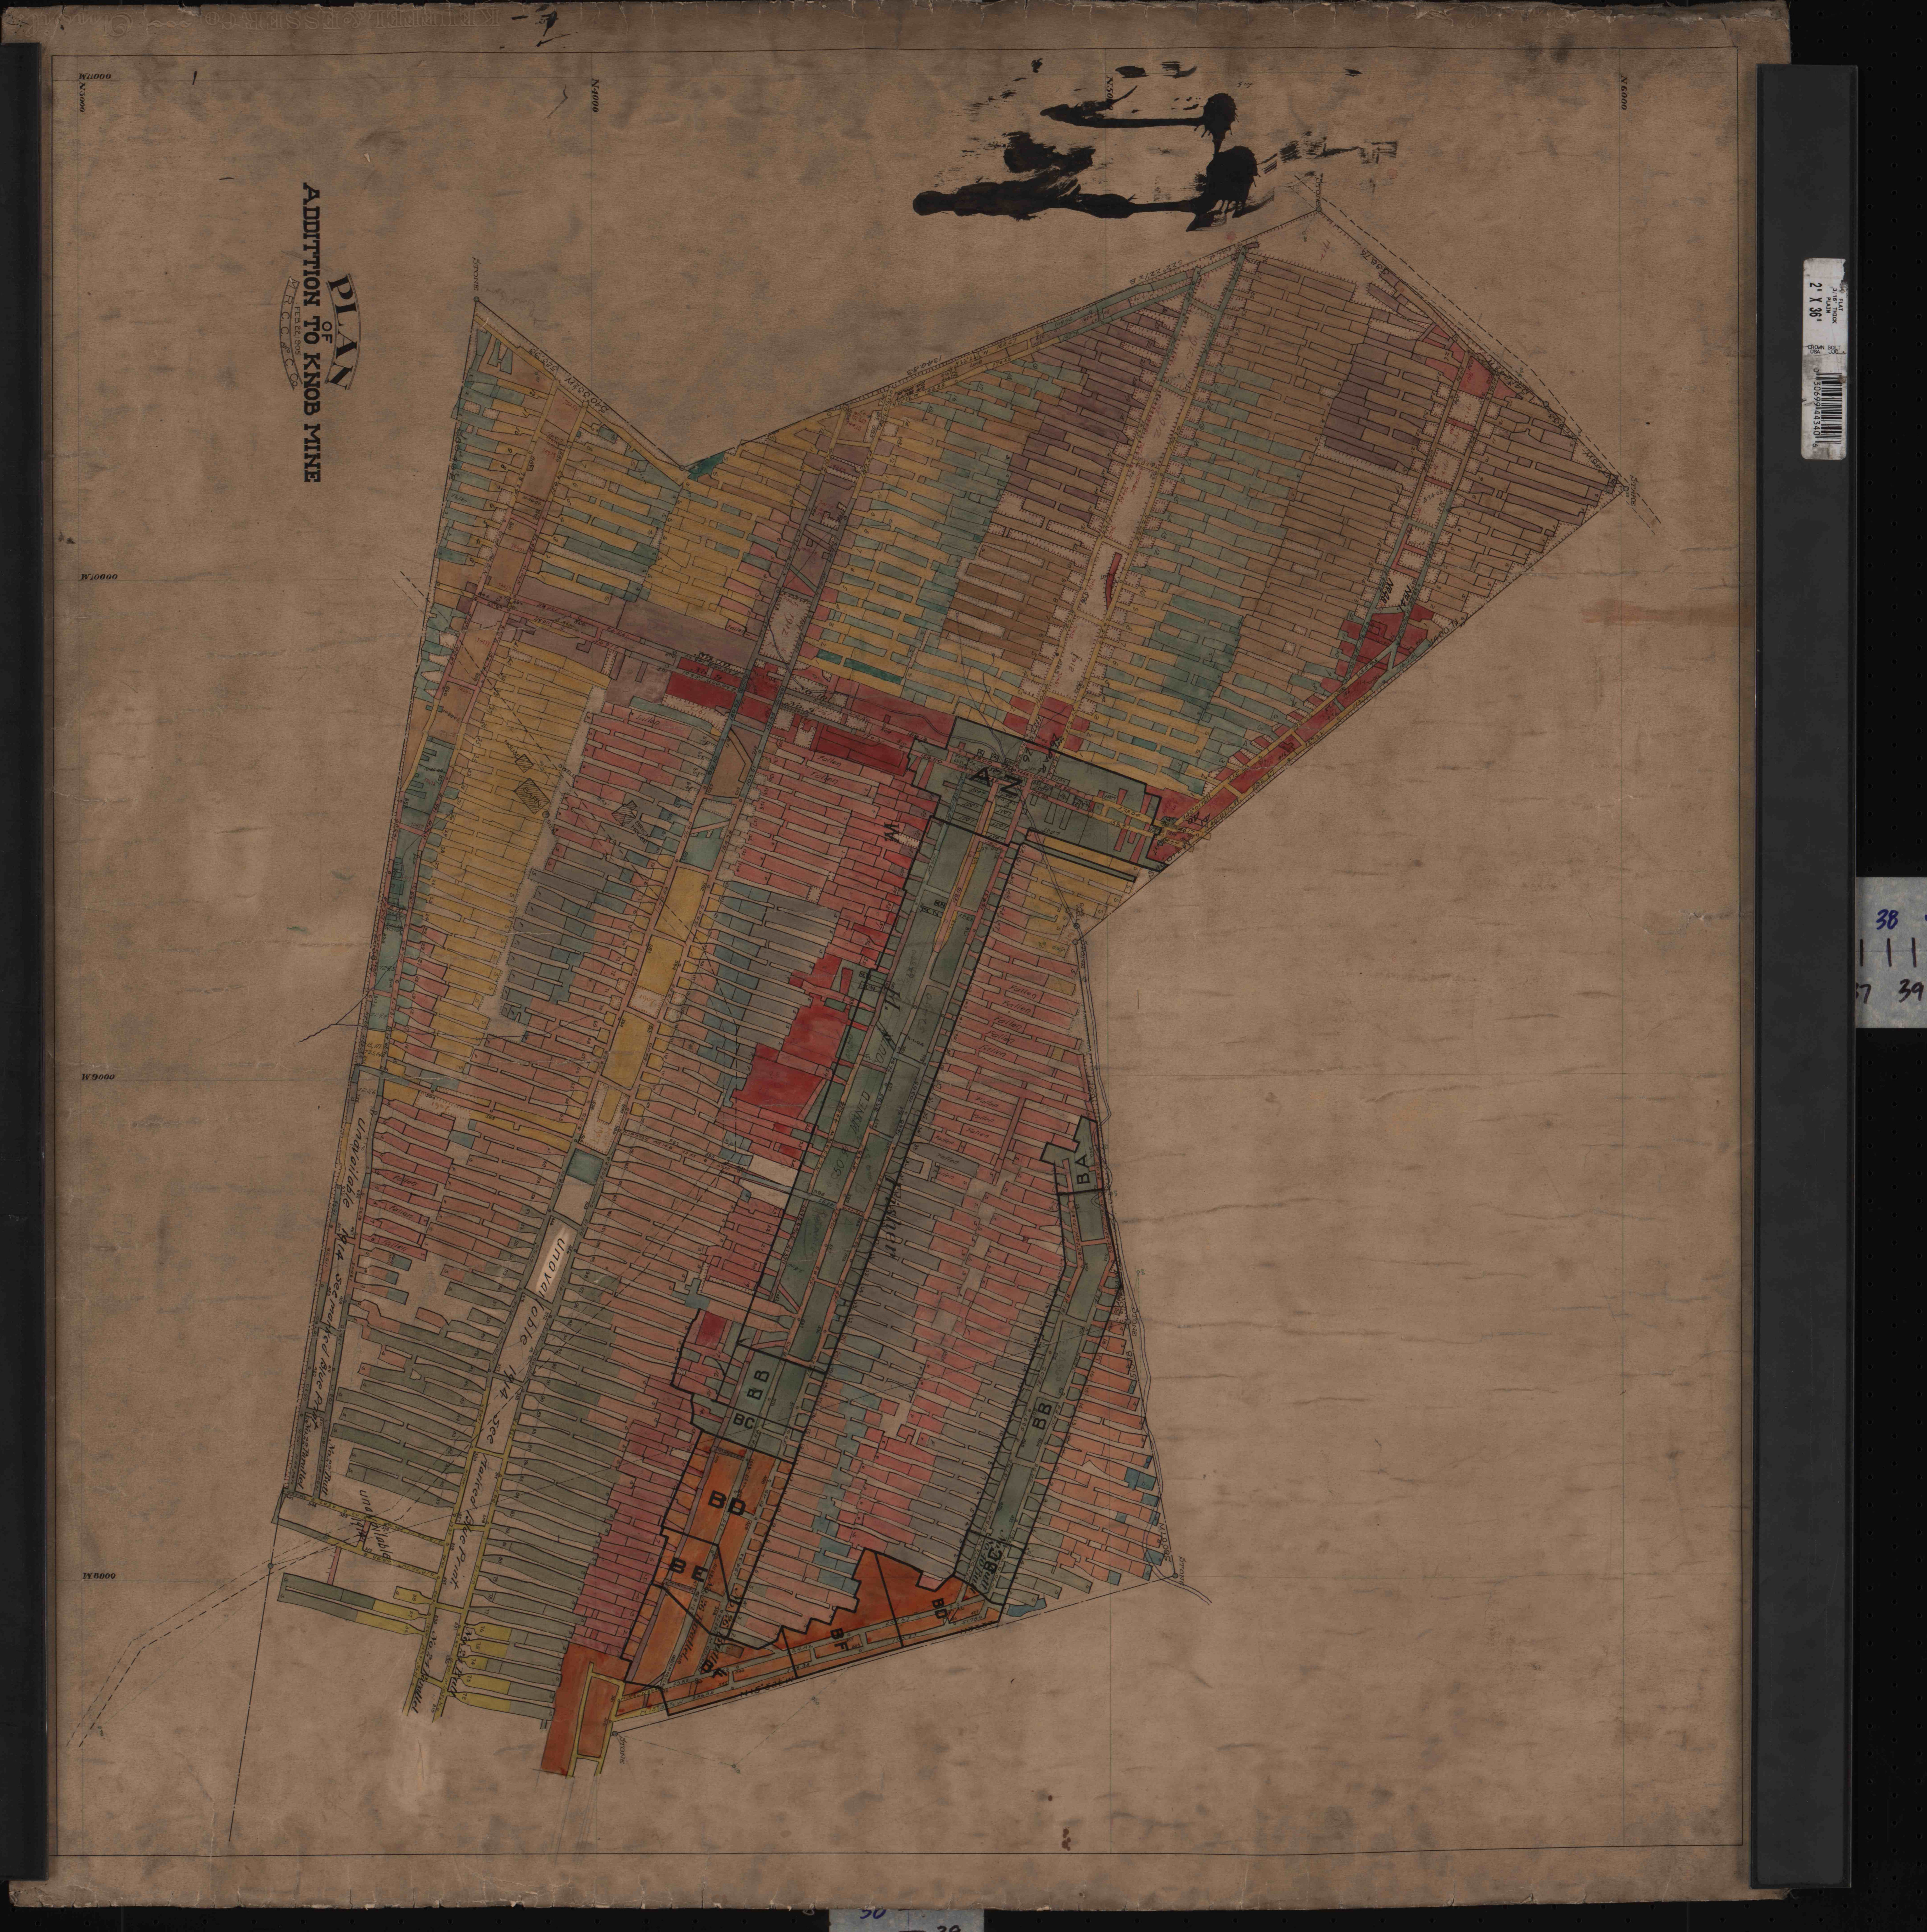
PLAN OF ADDITION TO KNOB MINE
FEB. 22, 1905
KEUFFEL & ESSER CO.
W11000
N3000
N4000
N5000
N6000
W10000
W9000
W8000
STONE
STAKE
Fallen
BARN
Unavailable 1914 See marked Blue Print
AZ
BA
BB
BC
BD
BE
BF