

60
58
57



PLAN OF THE MIDWAY MINES.

MIDWAY, WASHINGTON CO., PENNA.

Surveyed by M. Taylor.

January, 1894.

Scale 1/2" = 100'

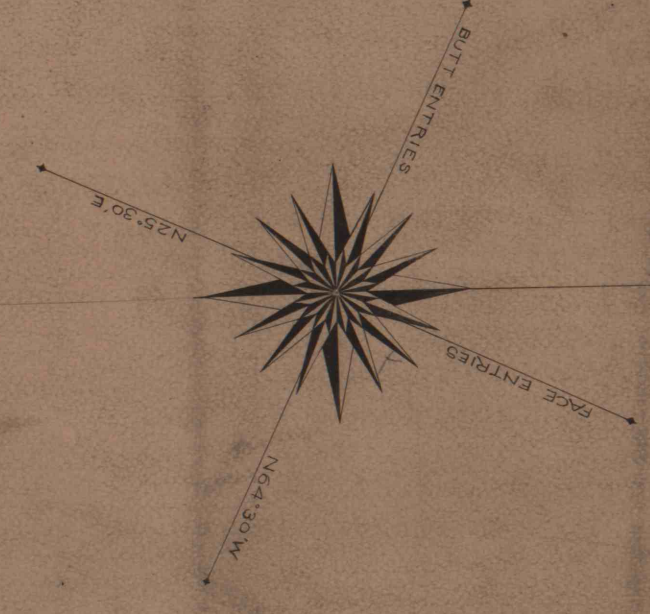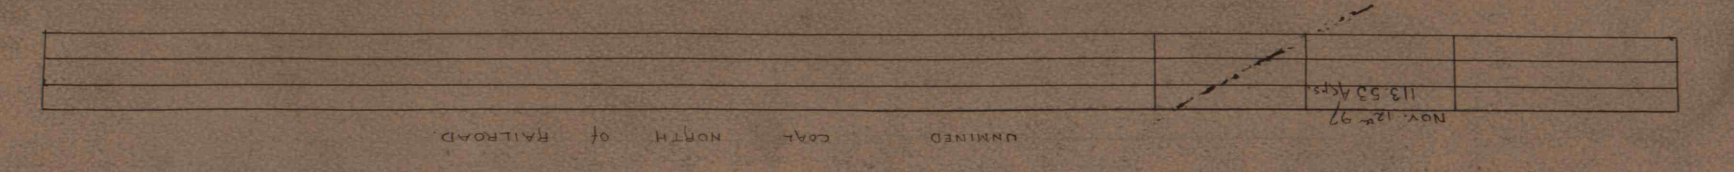

*For Plan of East Branch
See No. 1007*

70 71 72 73 74 75
76 77 78 79 80 81 82 83 84 85 86 87 88 89 90

60
59