
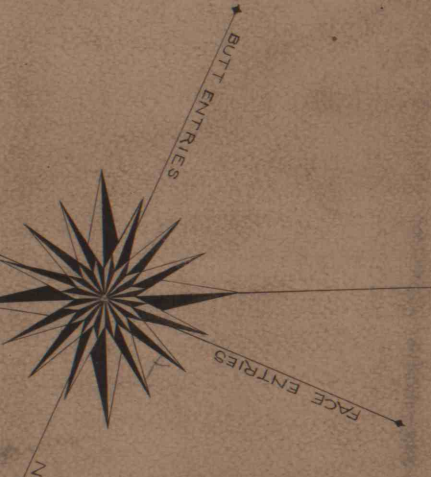


60
58
59

PLAN OF THE MIDWAY MINES.

MIDWAY, WASHINGTON CO., PENNA.
SITUATE AT
January, 1891.
Scale No. 1
Selling, M. Taylor.

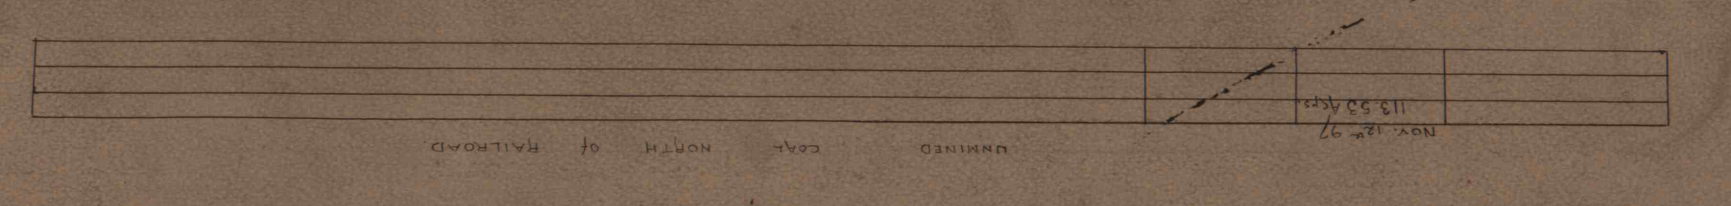

74 76 78 80 82 84 86 88 90
73 75 77 79 81 83 85 87 89

58
60
59
61