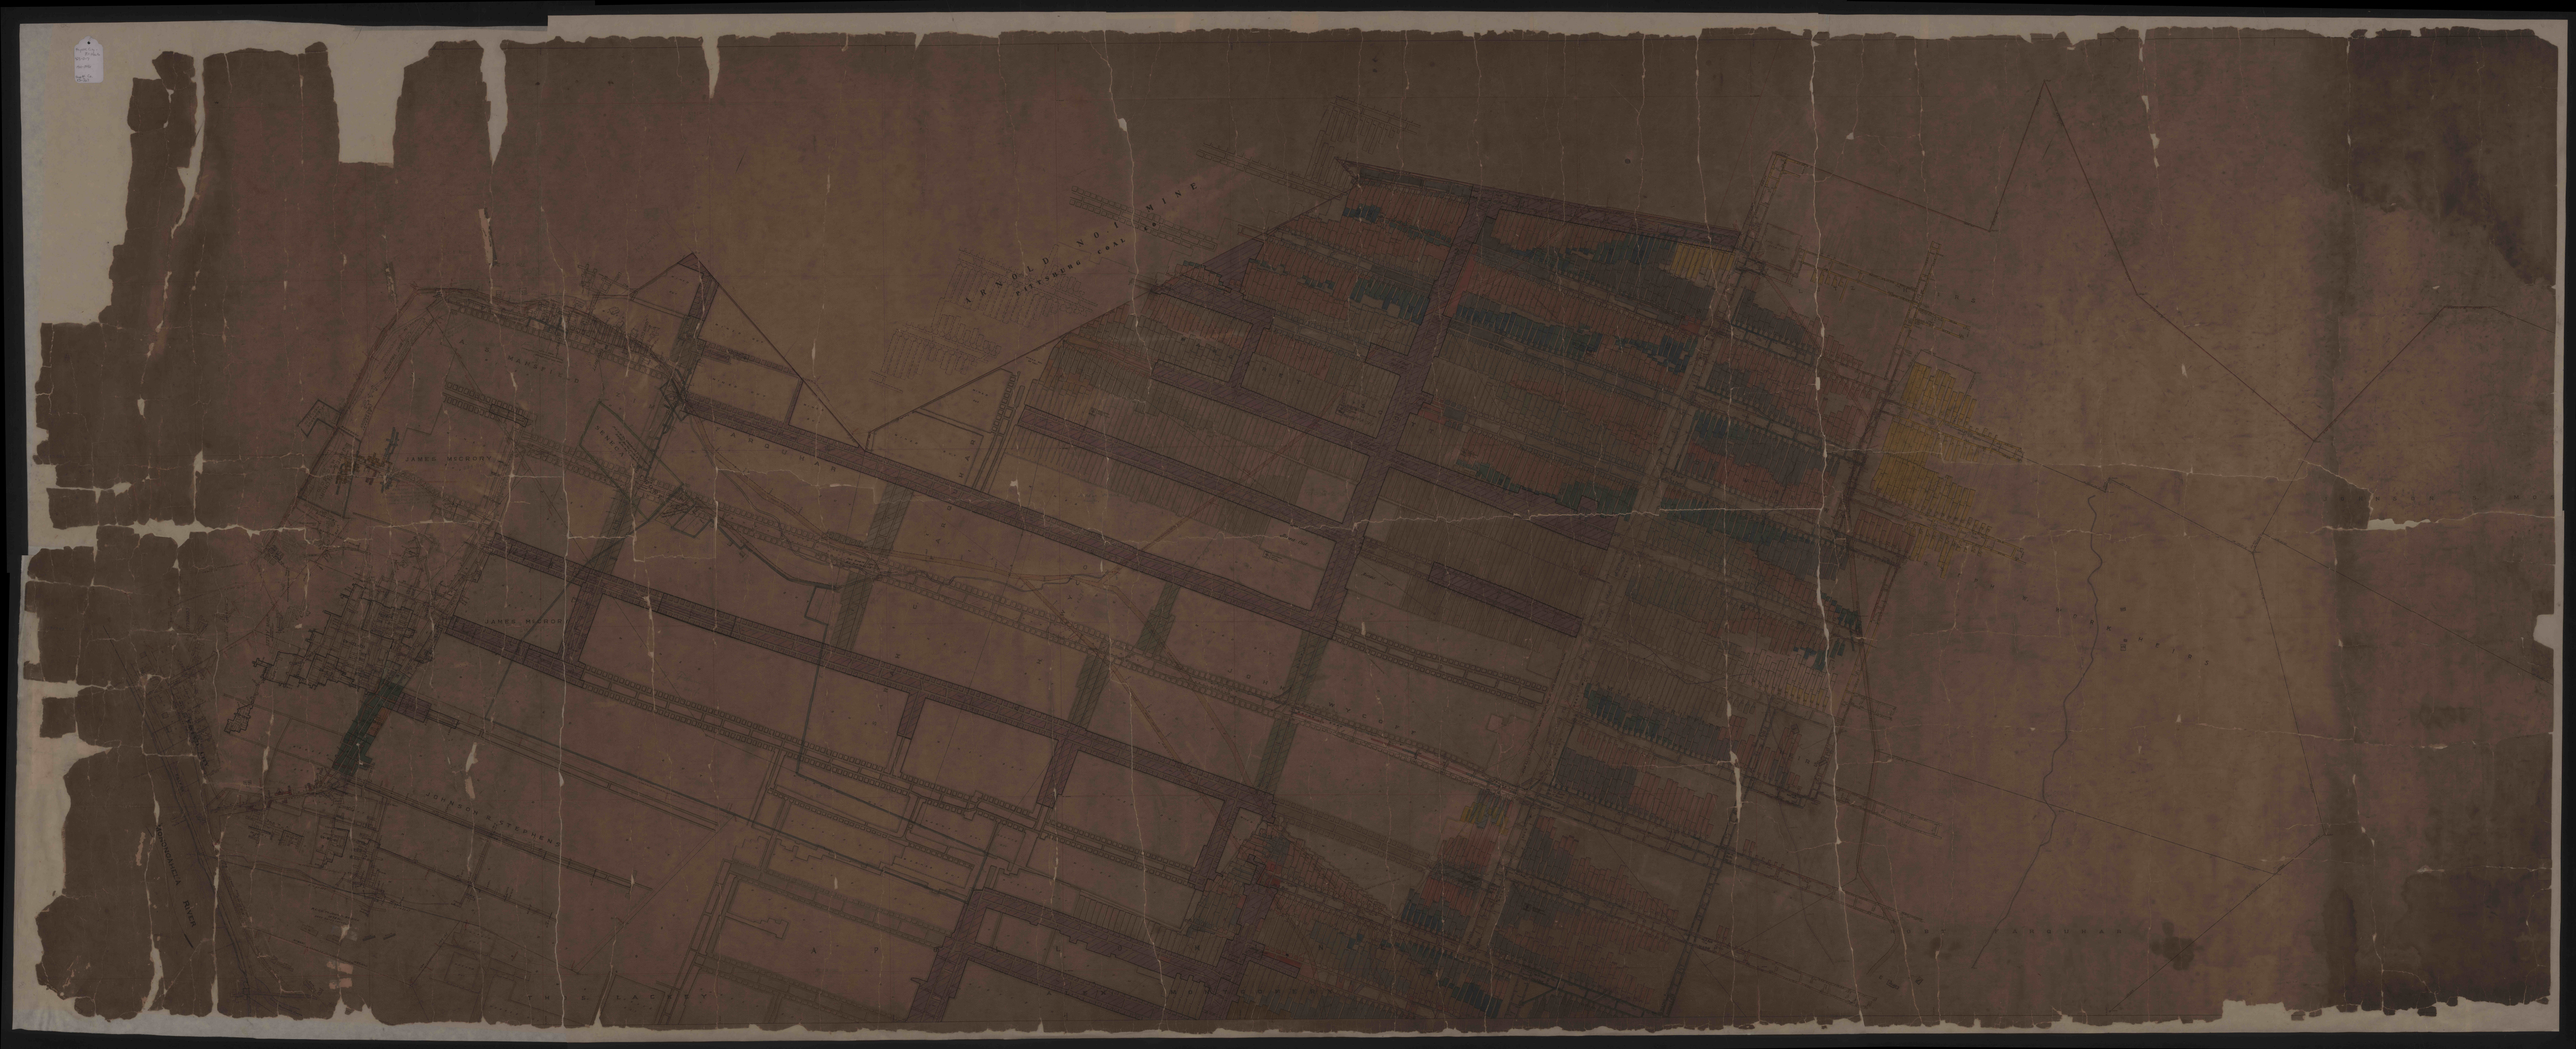
ARNOLD NO. 1 MINE
PITTSBURG COAL CO.
MANSFIELD
JAMES MCCOY
JAMES MCCOY
JOHNSON & STEPHENS
THOS. BLACKBURN
MONONGAHELA RIVER