


42
40


XSL 369 388044 1"=100'

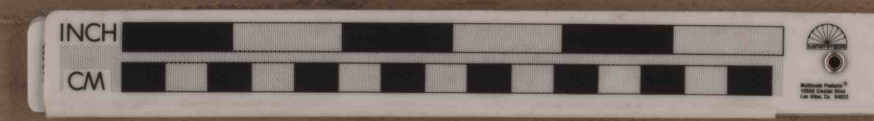

WEBSTER GAS COAL Co.
NORTH-WEBSTER MINE
SITUATE IN ROSTRADER TWP WESTMORELAND CO
PENNSYLVANIA
1897

Continued Out to Dec. 1896
Feb. 1898
Aug. 8, 1898
May 24, 1899

JUN POWERS HAS

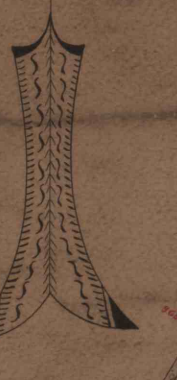

JOS VAN KIRK

SAMUEL KELEY

MRS. WM. MOORE

FAWCETT

BEAZELL

76 76
1111
77

76 78
1111
75 77

40
41
42