


60-1-61

LEASED TO J. M. STEER, 12-13-44  
EXPIRES 12-13-51

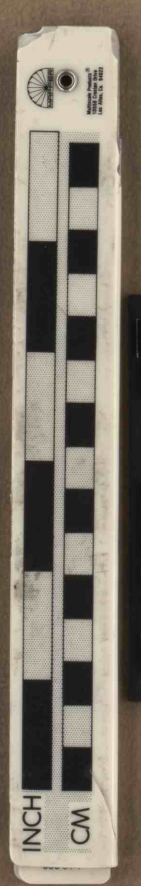

391379 02

WASHINGTON MINE  
WORKINGS IN THE BROWN COAL.  
SCALE 1 IN. = 100 FT.  
M. B. C. & C. CO.

ENGINEERING  
WASHINGTON  
Geological  
6-4  
A-4

60-1-61