

60
59
58
57
56

HENRY ENGEL
1880 AC. 1880 AC.

JOHN TAGGART
179.140 AC.

MATHEW BROWN ET UX
101.87 AC.

J.C. BROWN
102.05 AC.

LUTHER M. MORGAN
30.5 AC.
1880 AC. 1880 AC.

GEO. M. REED
195.80 AC.


L.C. BROWN
128 AC.

JND. L. COCKINS
50.88 AC.

JND. L. COCKINS
174.88 AC.

BERRY HBB
82.00 AC.

IRVING WELSH
78 AC.

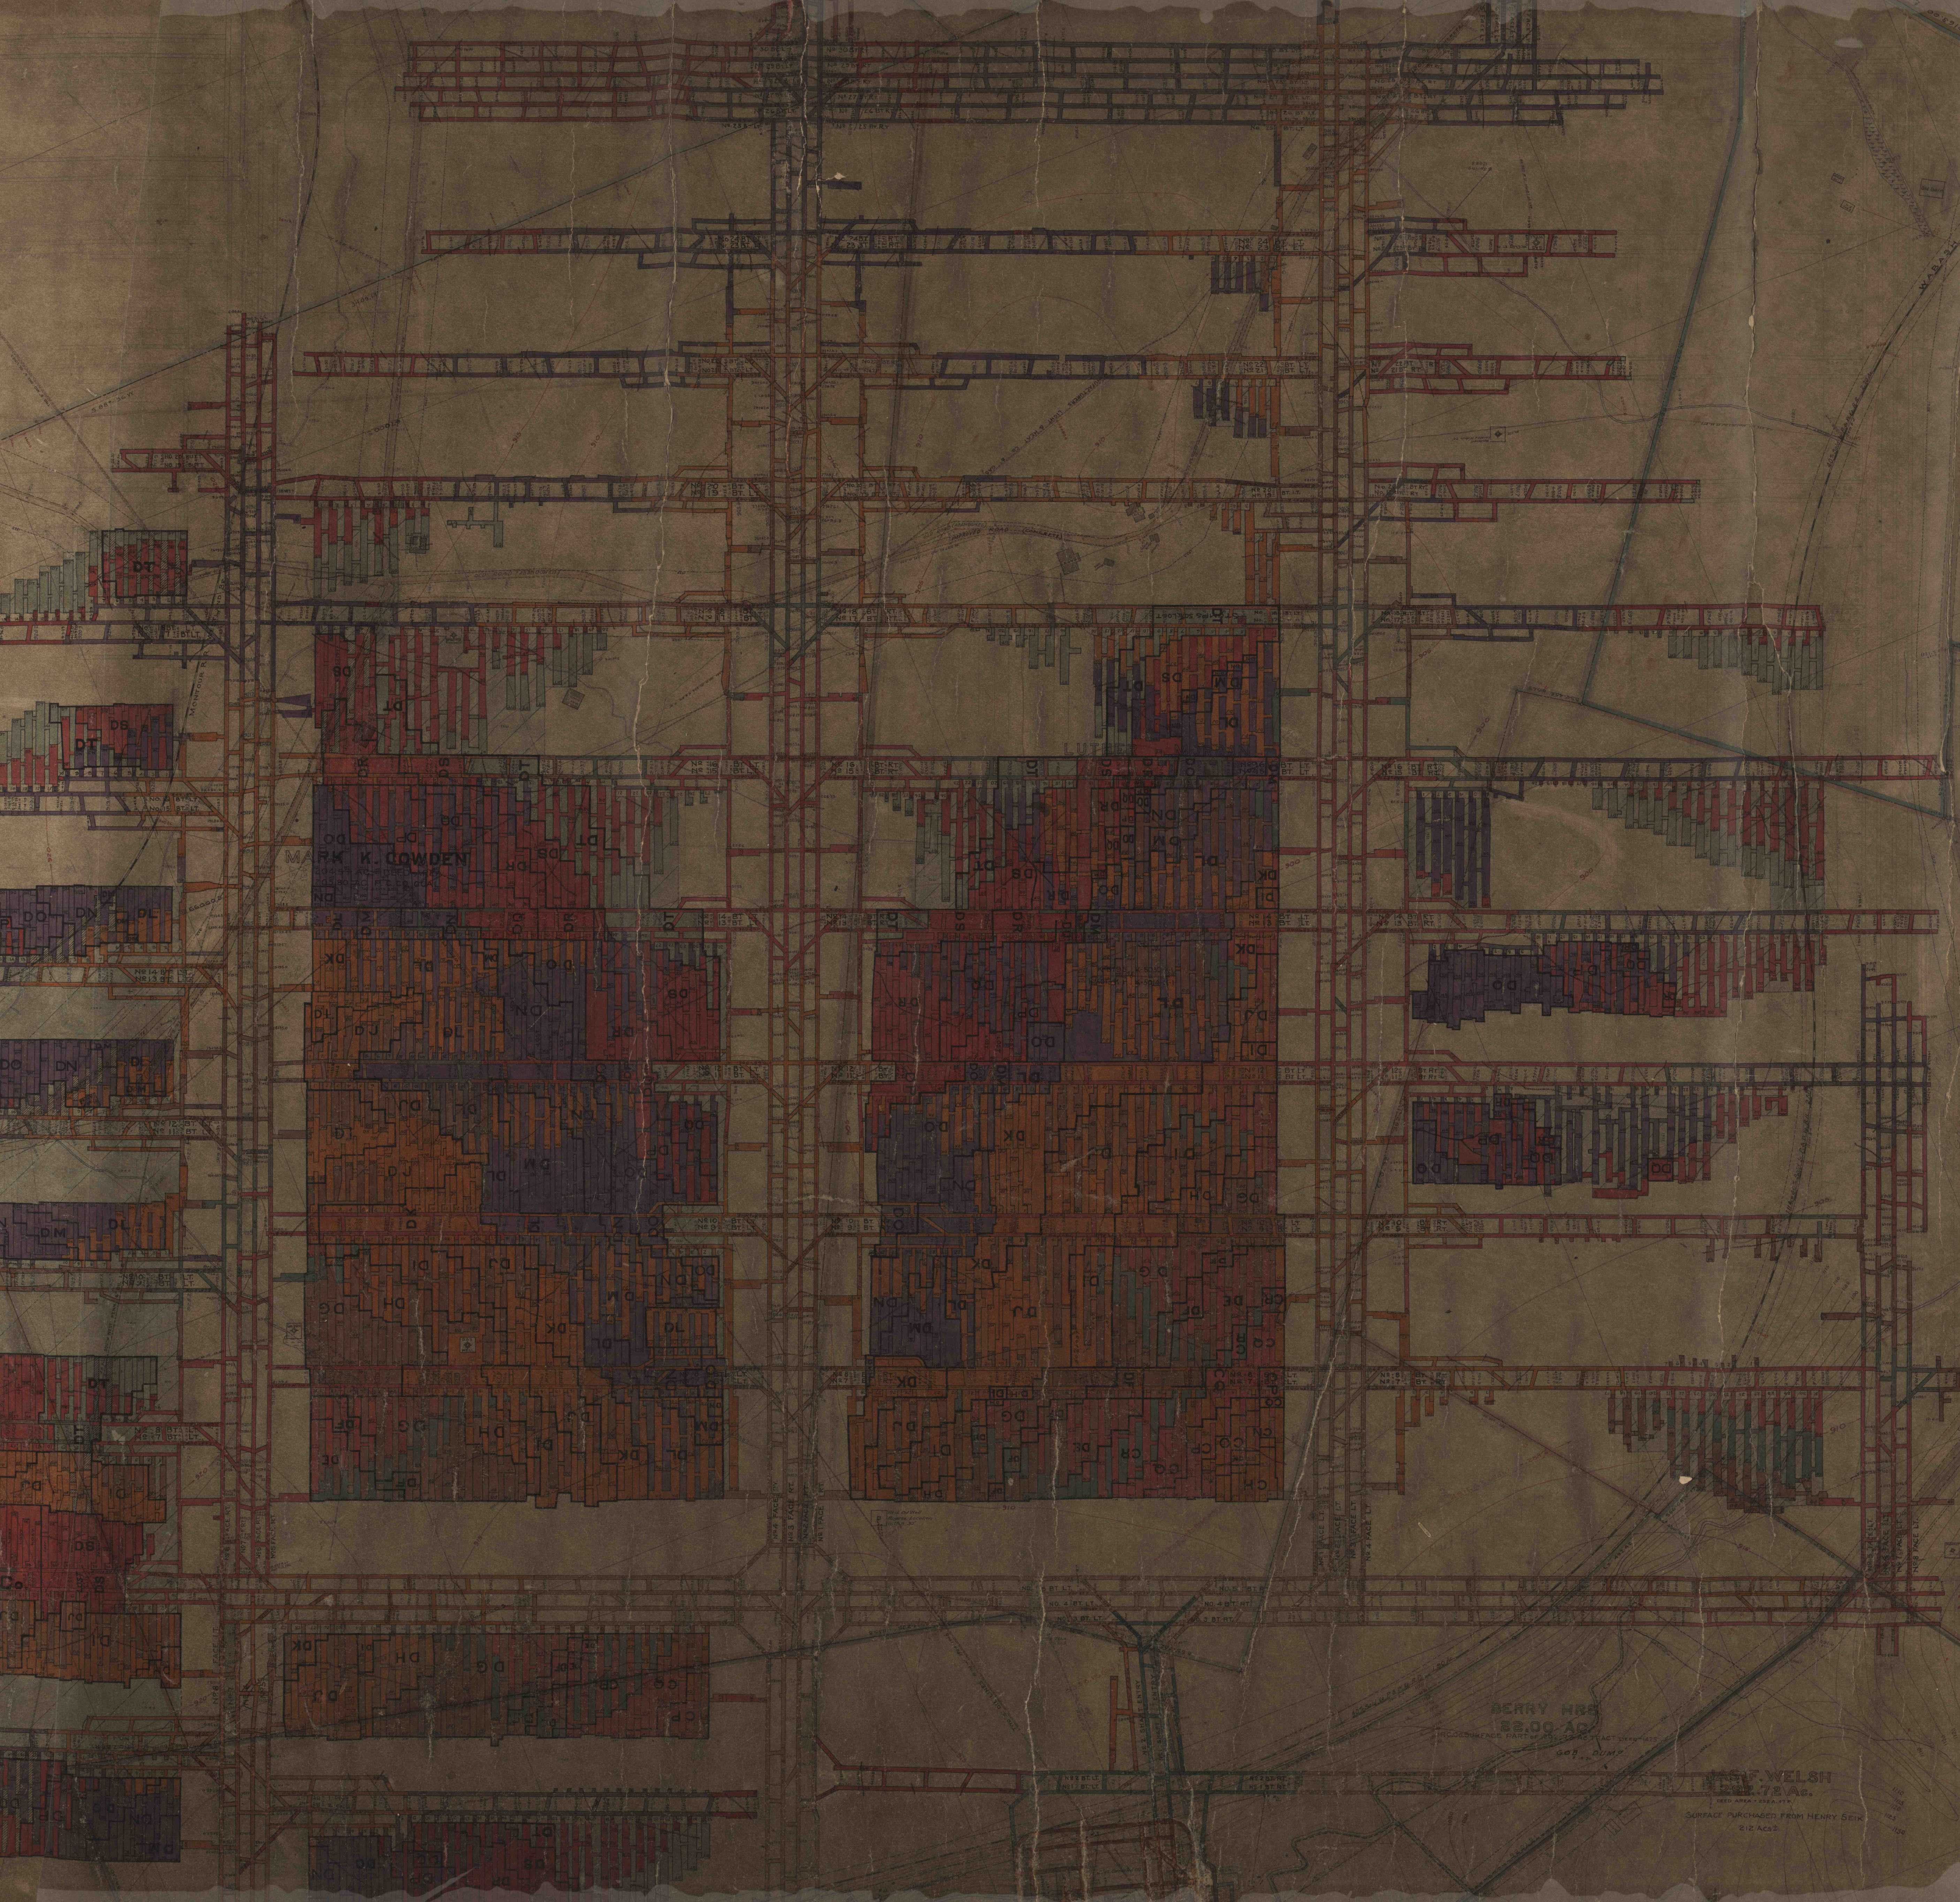

92
91
90

60
59
58
57
56