


WESTPLAN  
539

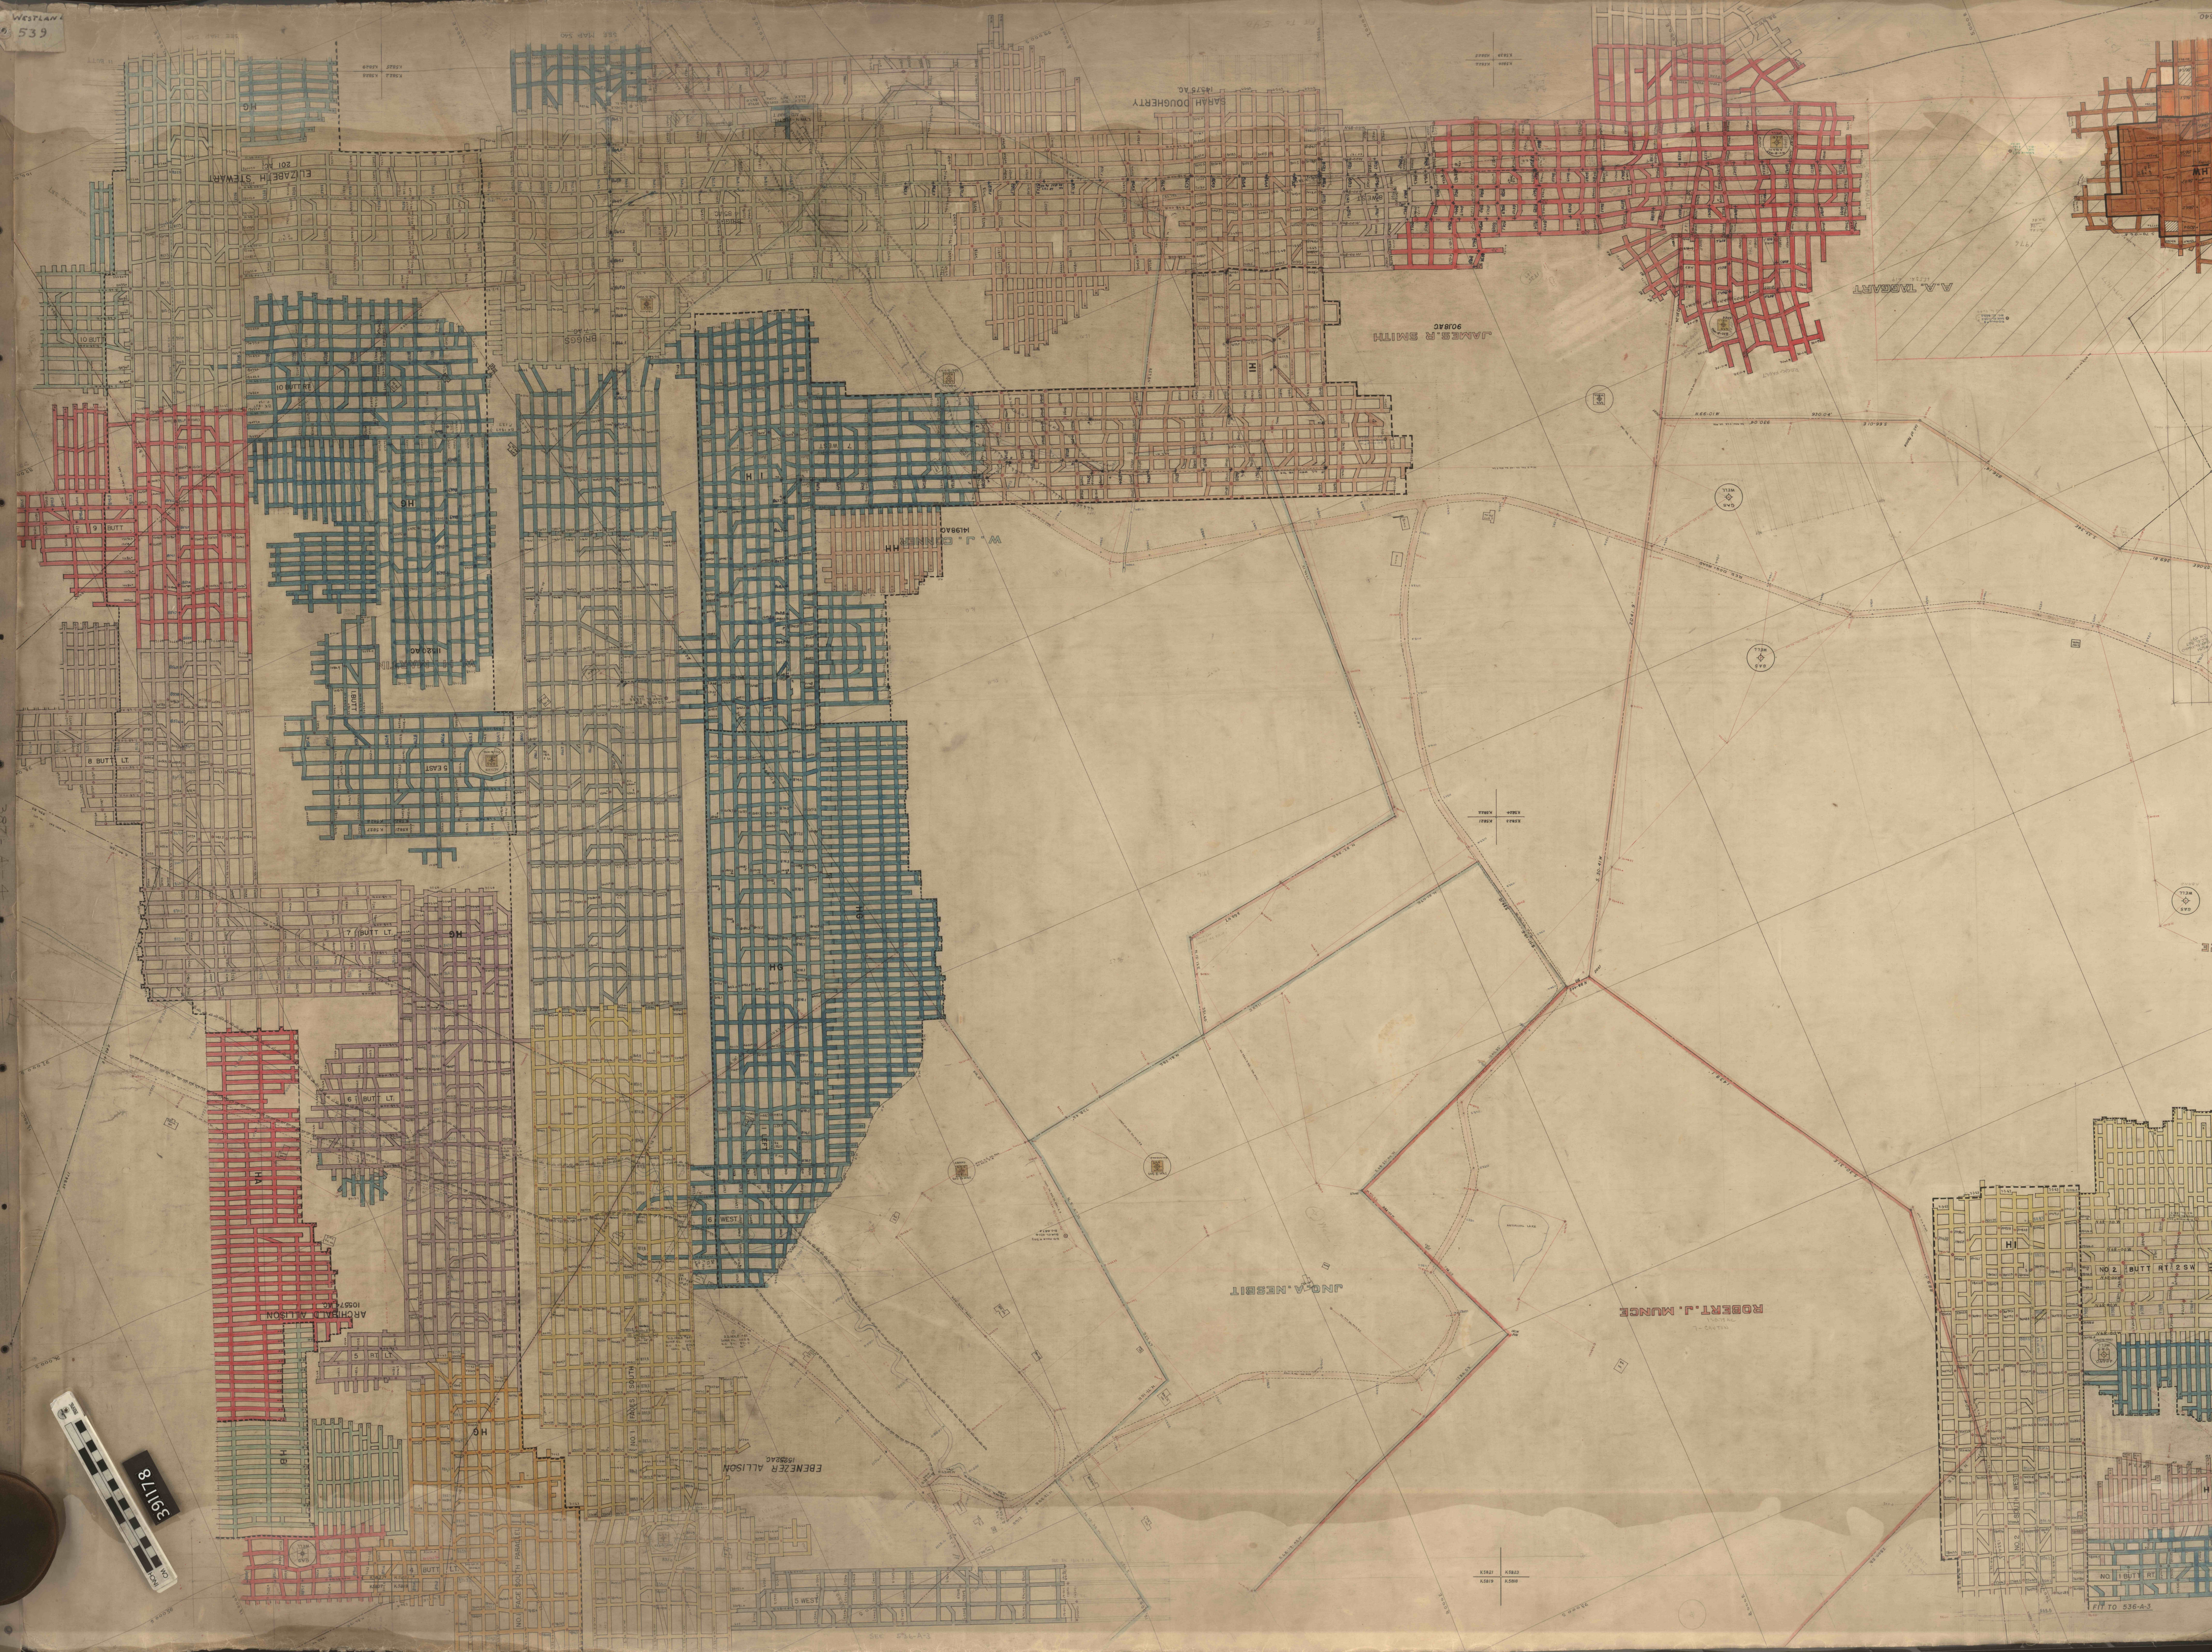

39178