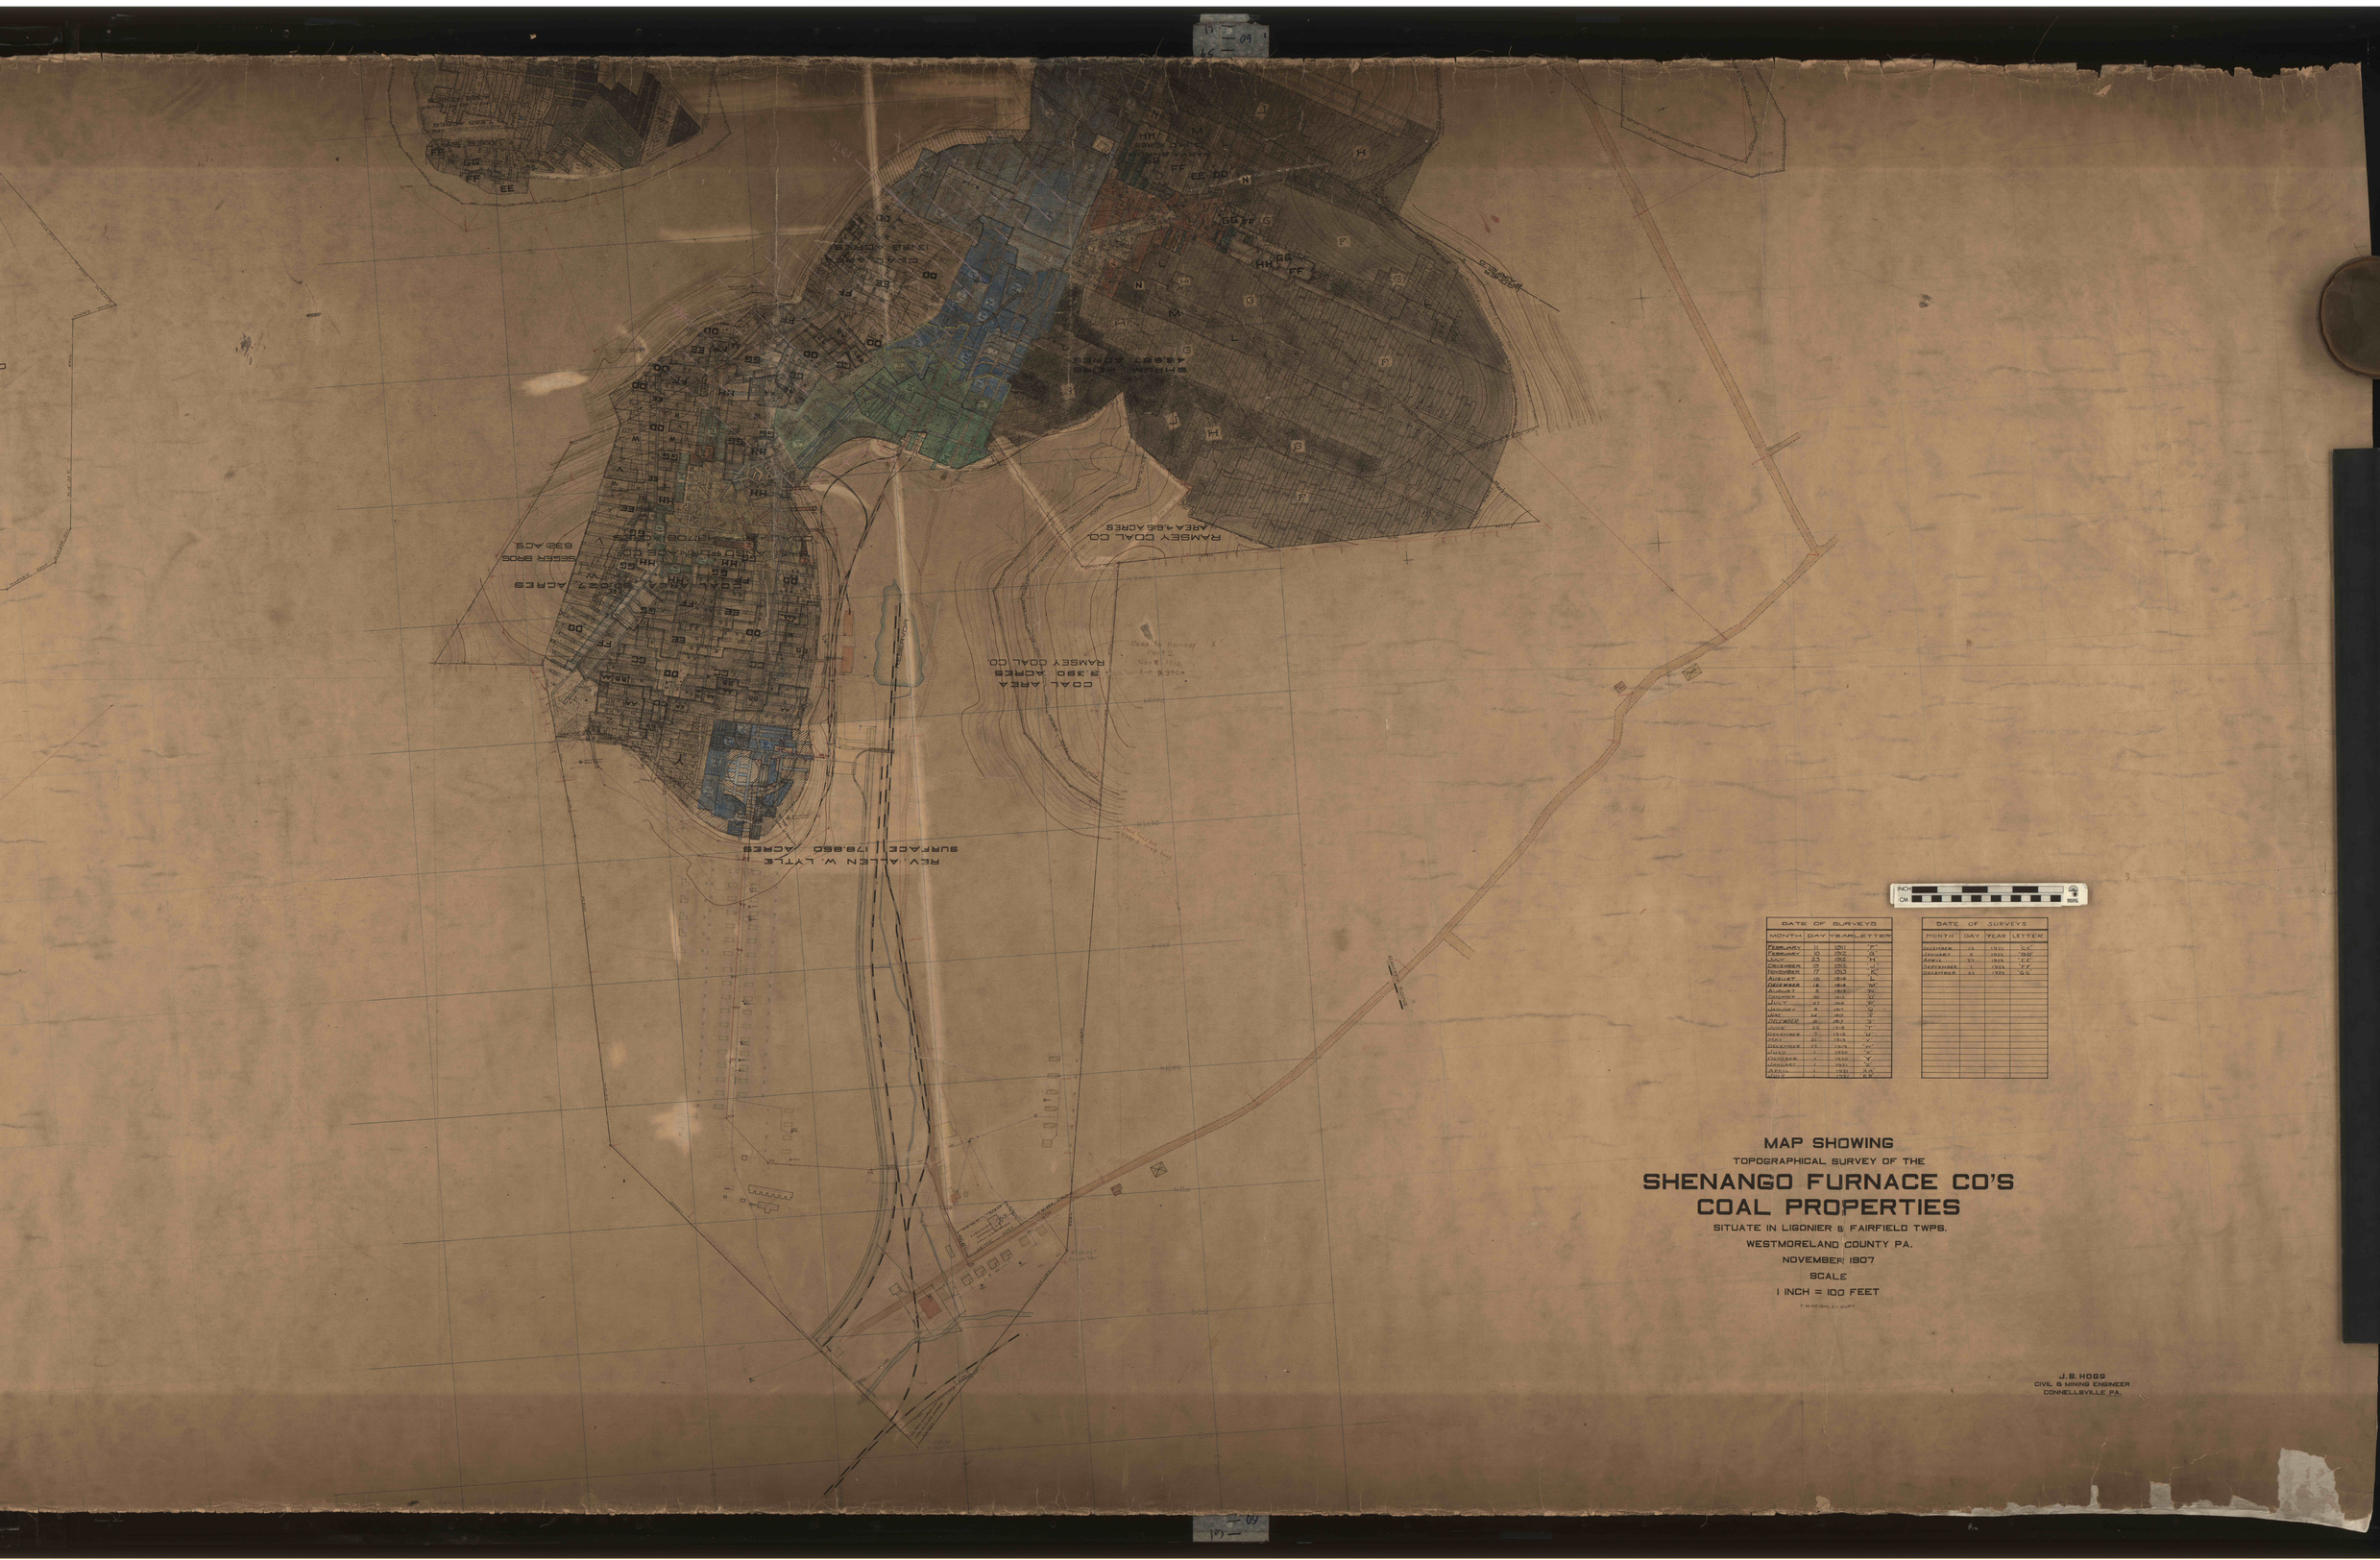

DATE OF SURVEYS			
MONTH	DAY	YEAR	LETTER
FEBRUARY	11	1911	"F"
FEBRUARY	10	1912	"G"
JULY	23	1912	"H"
DECEMBER	19	1912	"J"
NOVEMBER	17	1913	"K"
AUGUST	10	1914	"L"
DECEMBER	14	1914	"M"
AUGUST	8	1915	"N"
OCTOBER	30	1915	"O"
JULY	27	1916	"P"
JANUARY	8	1917	"Q"
JULY	24	1917	"R"
DECEMBER	8	1917	"S"
JUNE	25	1918	"T"
DECEMBER	7	1918	"U"
MAY	21	1919	"V"
DECEMBER	23	1919	"W"
JULY	1	1920	"X"
OCTOBER	1	1920	"Y"
JANUARY	1	1921	"Z"
APRIL	1	1921	"AA"
MAY	1	1921	"BB"

DATE OF SURVEYS			
MONTH	DAY	YEAR	LETTER
DECEMBER	13	1921	"CC"
JANUARY	8	1922	"DD"
APRIL	23	1922	"EE"
SEPTEMBER	7	1922	"FF"
DECEMBER	21	1922	"GG"

MAP SHOWING

TOPOGRAPHICAL SURVEY OF THE

SHENANGO FURNACE CO'S COAL PROPERTIES

SITUATE IN LIGONIER & FAIRFIELD TWPS.

WESTMORELAND COUNTY PA.

NOVEMBER 1907

SCALE

1 INCH = 100 FEET

T. W. KEIGHLEY SURF.

J. B. HOGG
CIVIL & MINING ENGINEER
CONNELLSVILLE PA.